



CONTENTS OF SHEET
 GROUND TO 4TH FLOOR PLANS,
 LINE AREA DIAGRAM & AREA CALCULATIONS,
 TERRACE FLOOR PLANS &
 DOOR AND WINDOW SCHEDULE, LIGHT &
 VENTILATION SCHEDULES & ELEVATION
 BUILDING TYPE-B (WING-B1 TO B8)


STAMP OF APPROVAL
 AS BUILT DRAWINGS APPROVED
 Subject to the conditions mentioned
 in this certificate letter No.:
 CIDCO/MH/V/RENS/166/2018/Part-2/12/12
 Dated: 07.11.2018
 Association of Architects (MUMBAI)

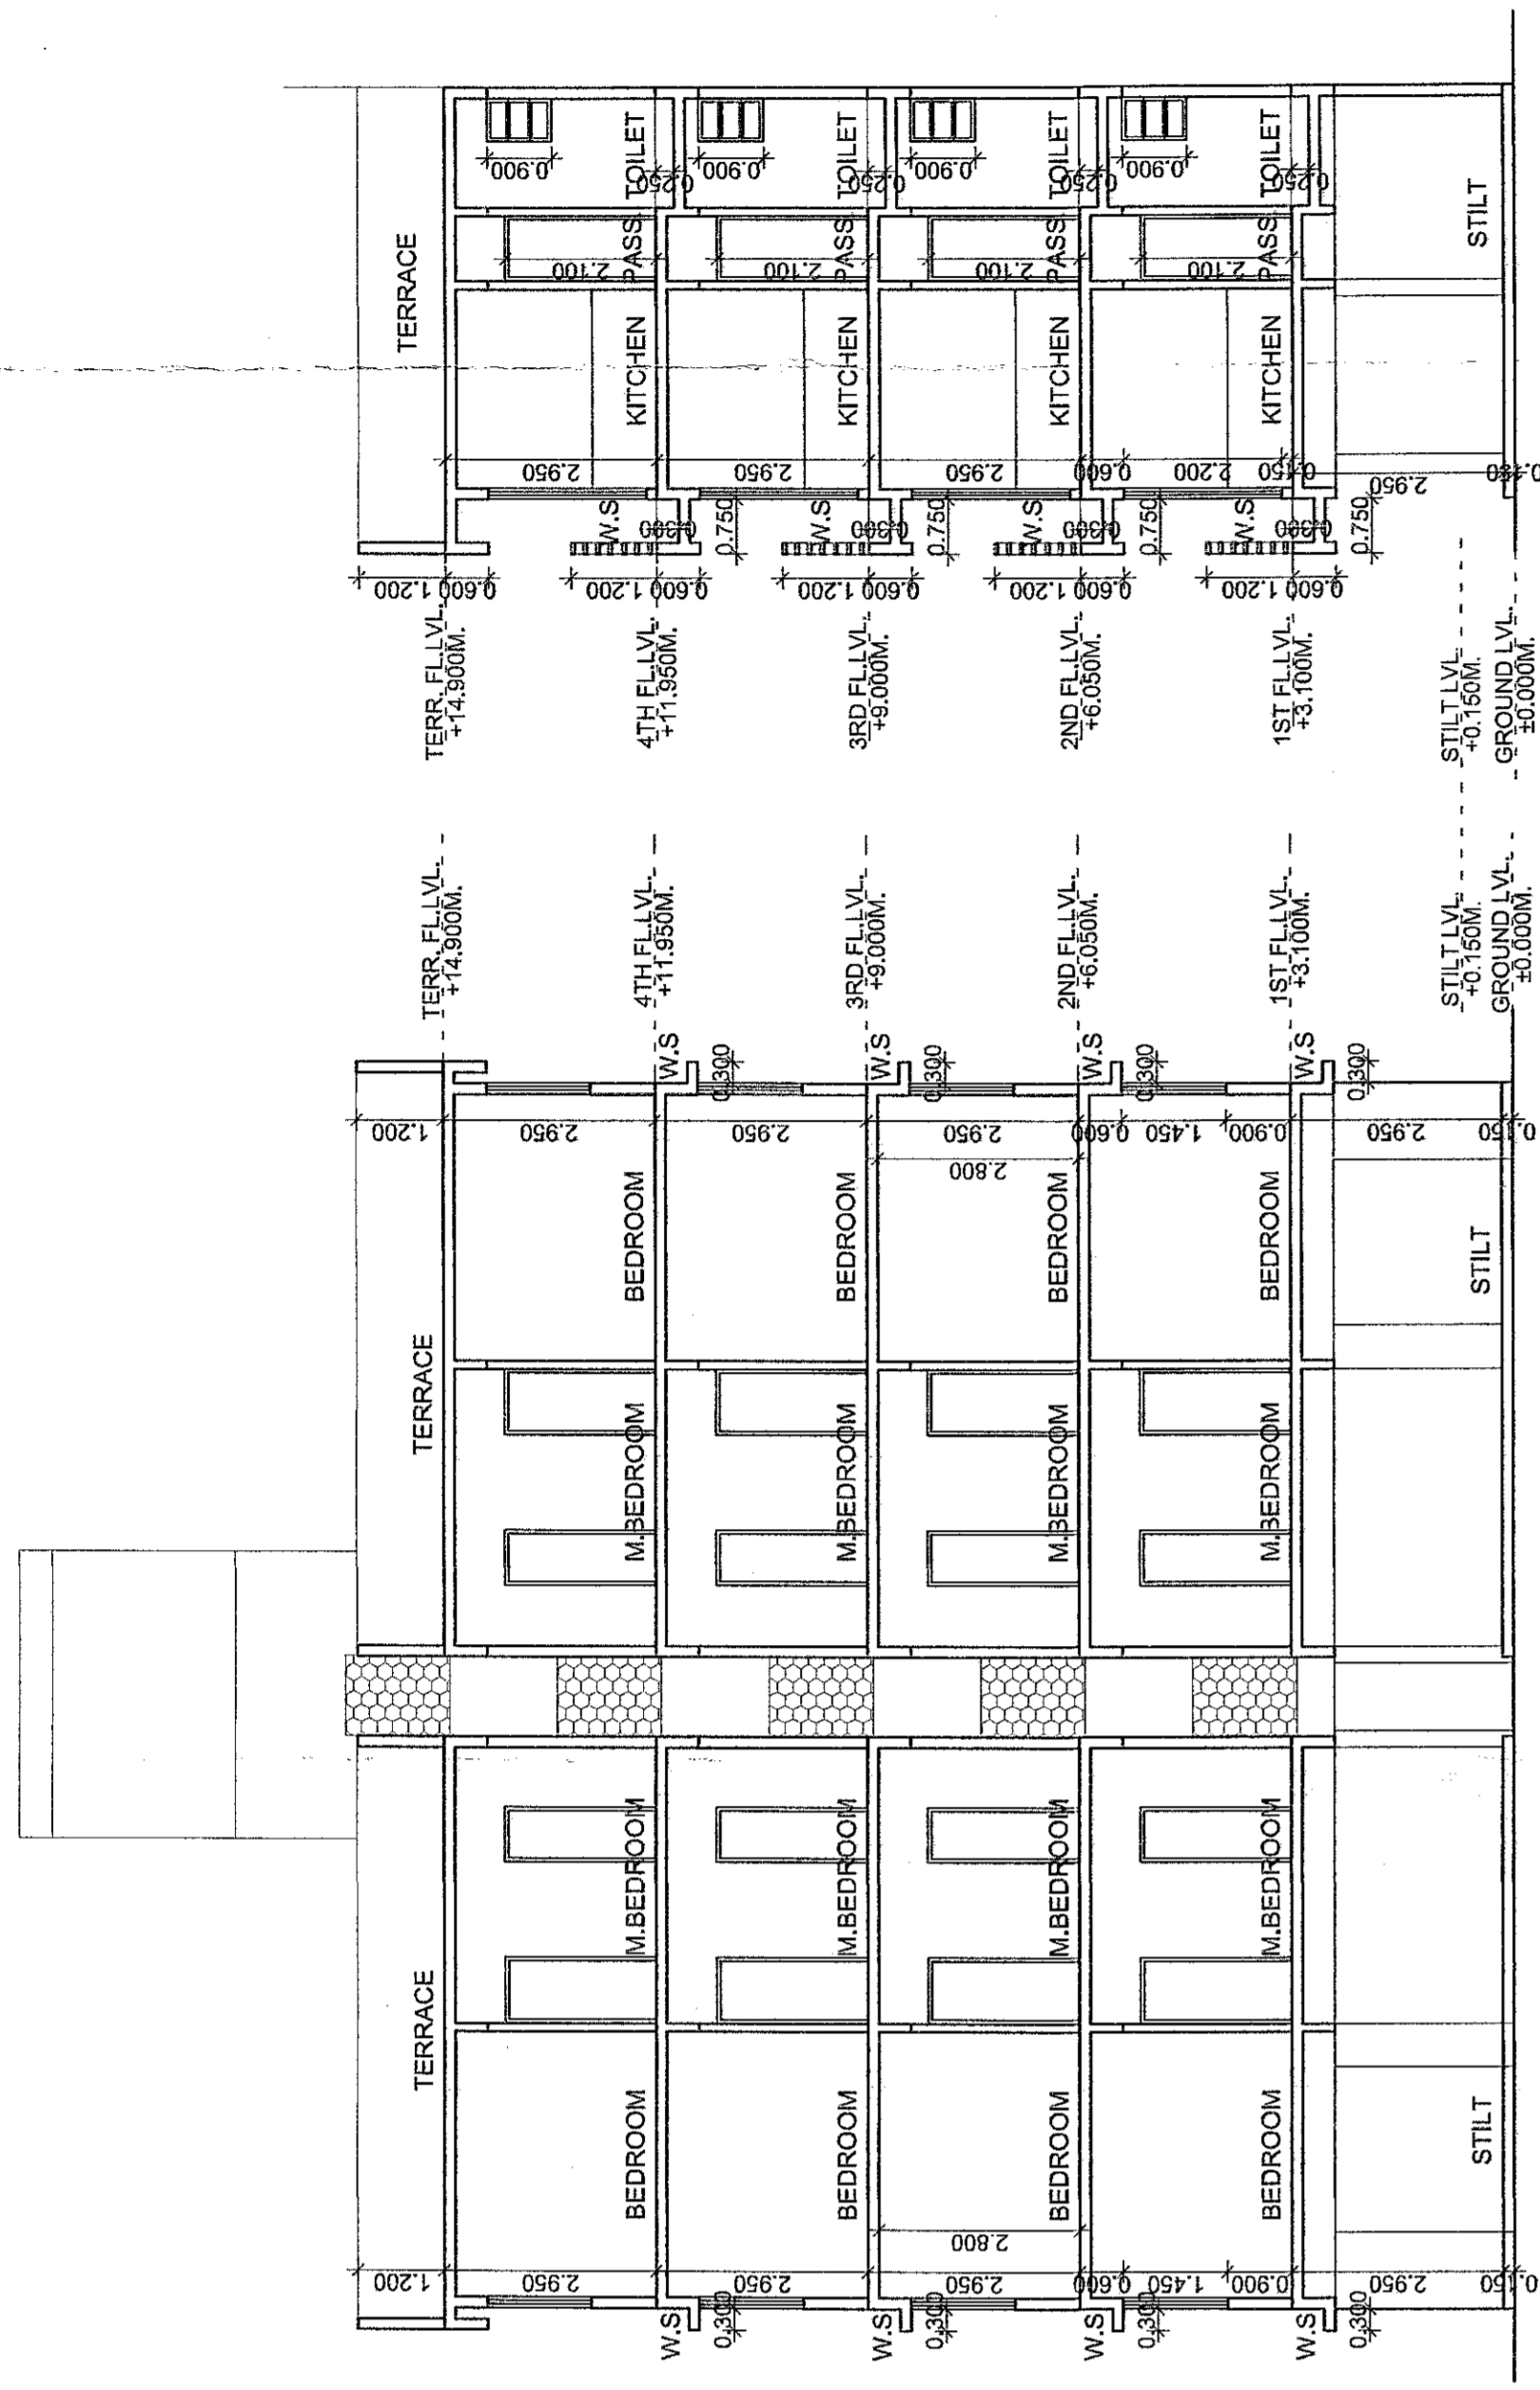

BUILDING NO. B2 & B5
SECTION C-C
 SCALE: 1:100

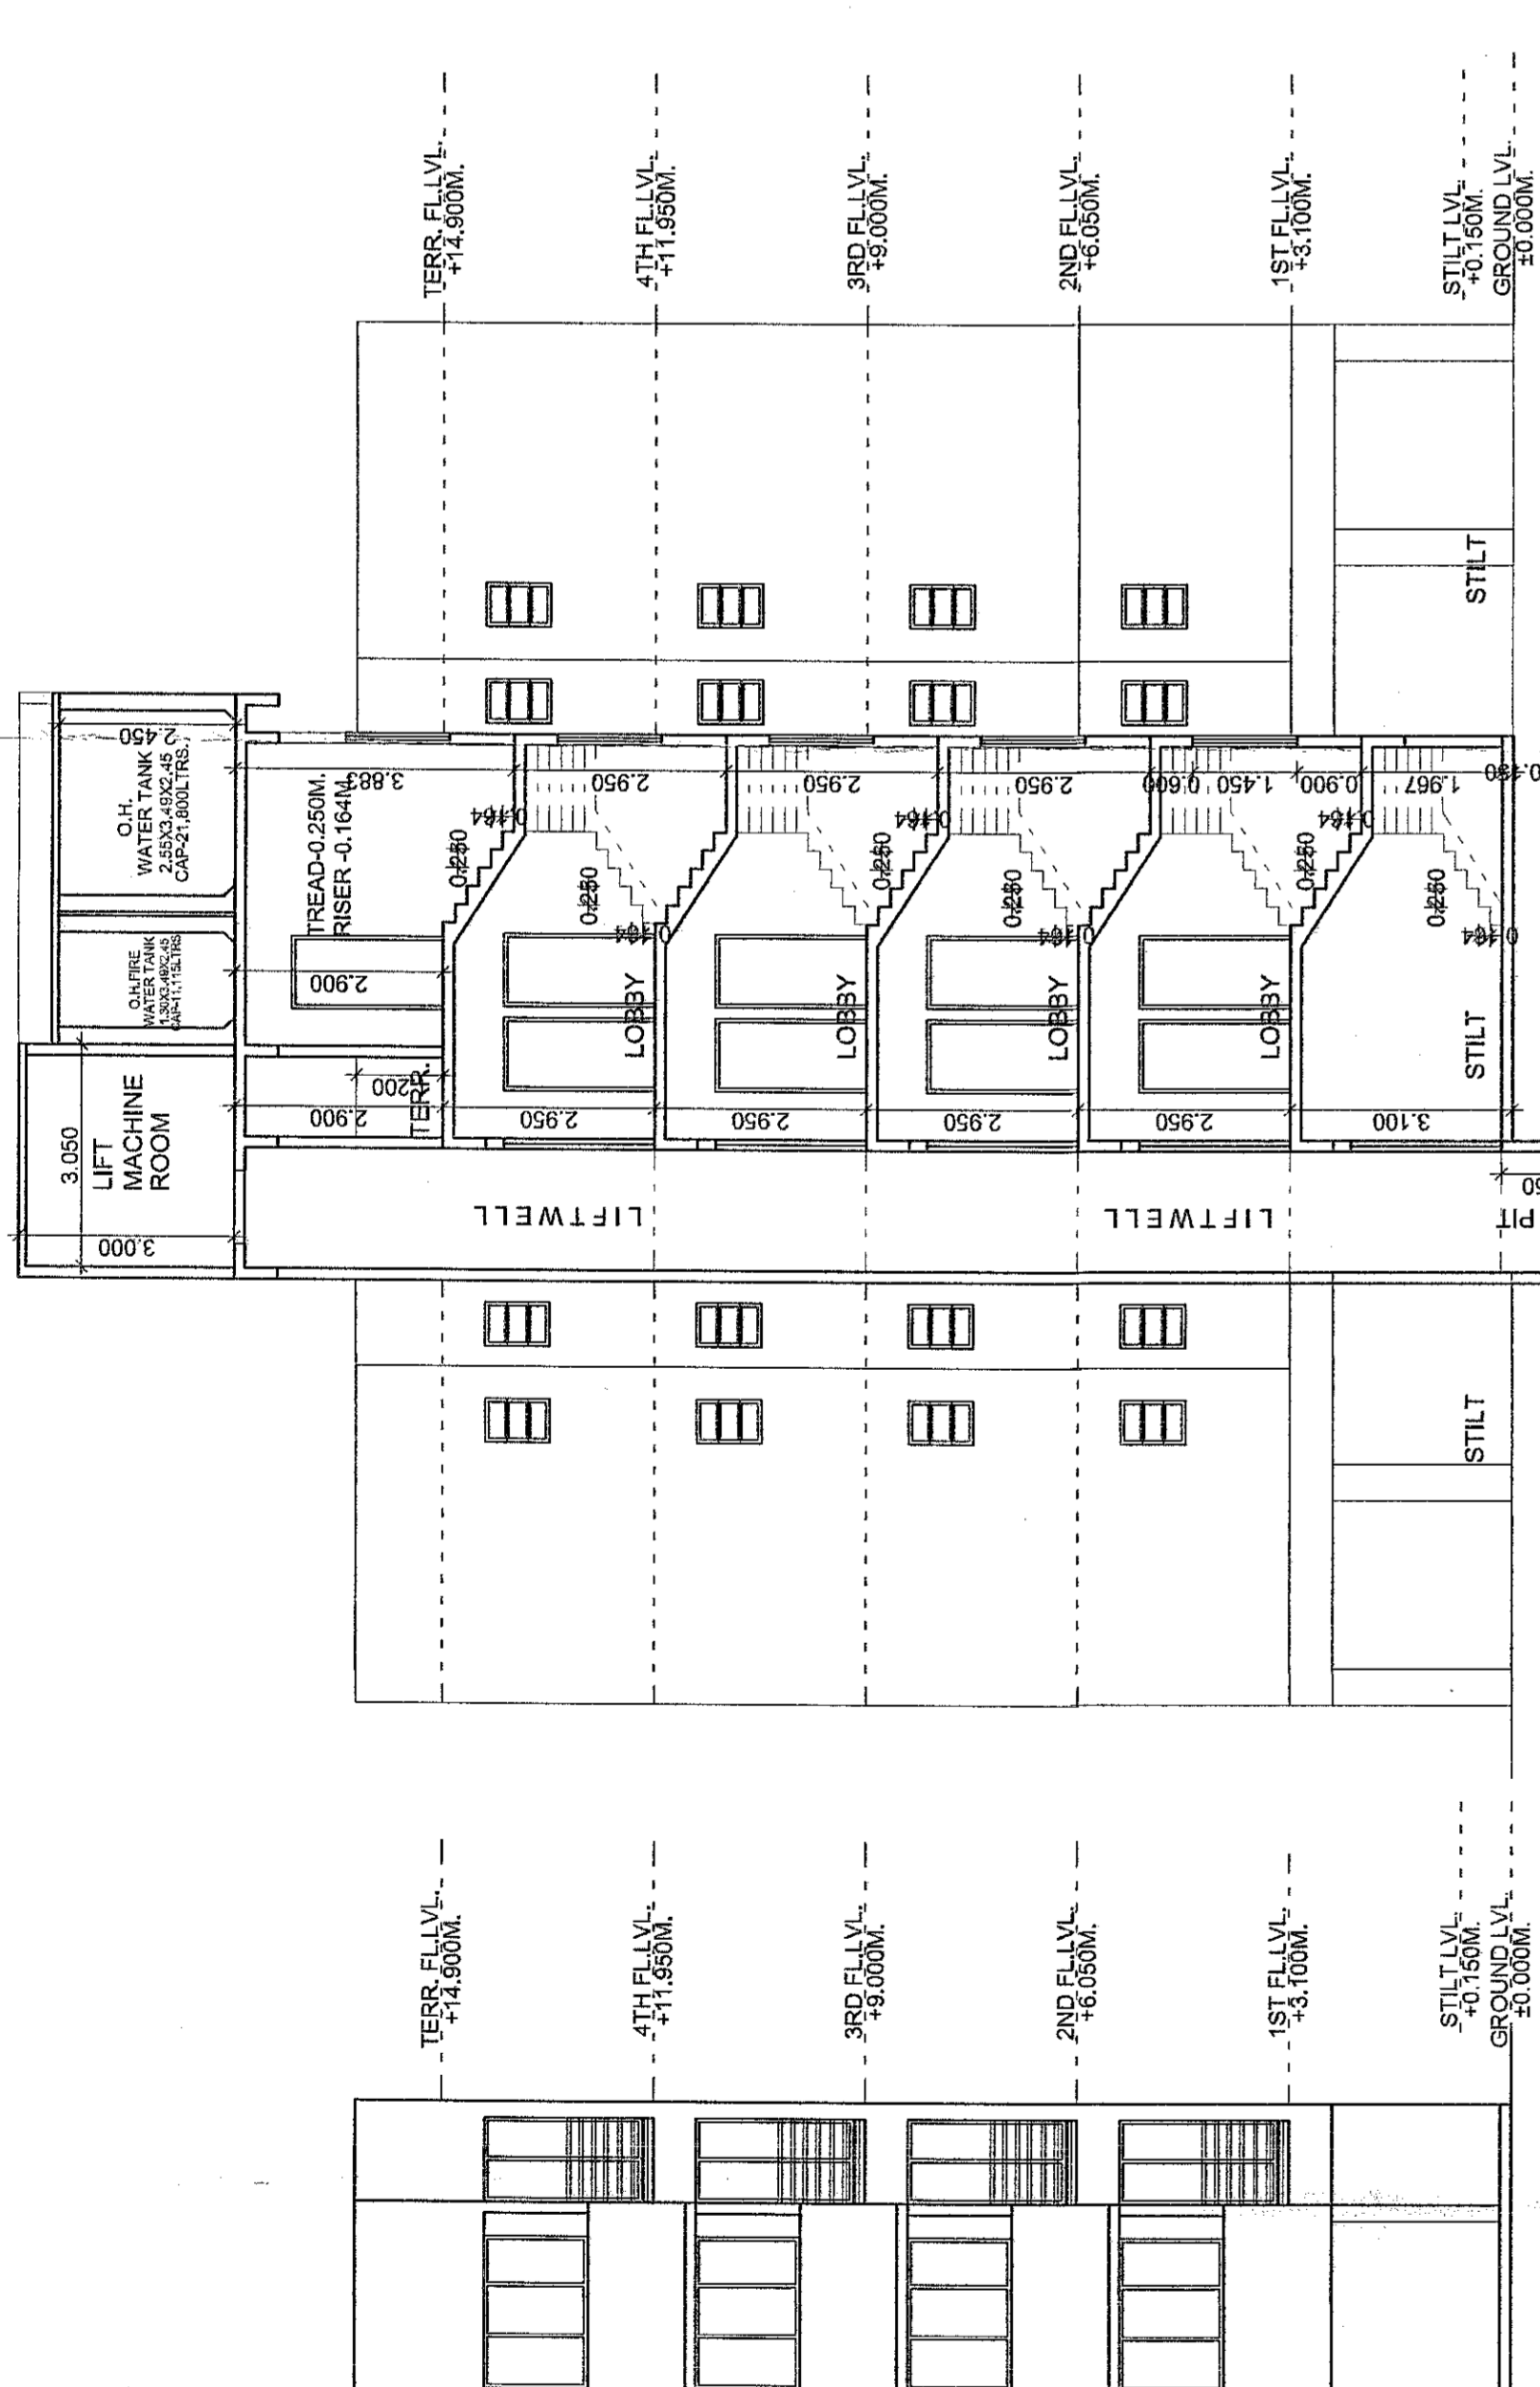


BUILDING NO. B2 & B5
SECTION A-A
 SCALE: 1:100

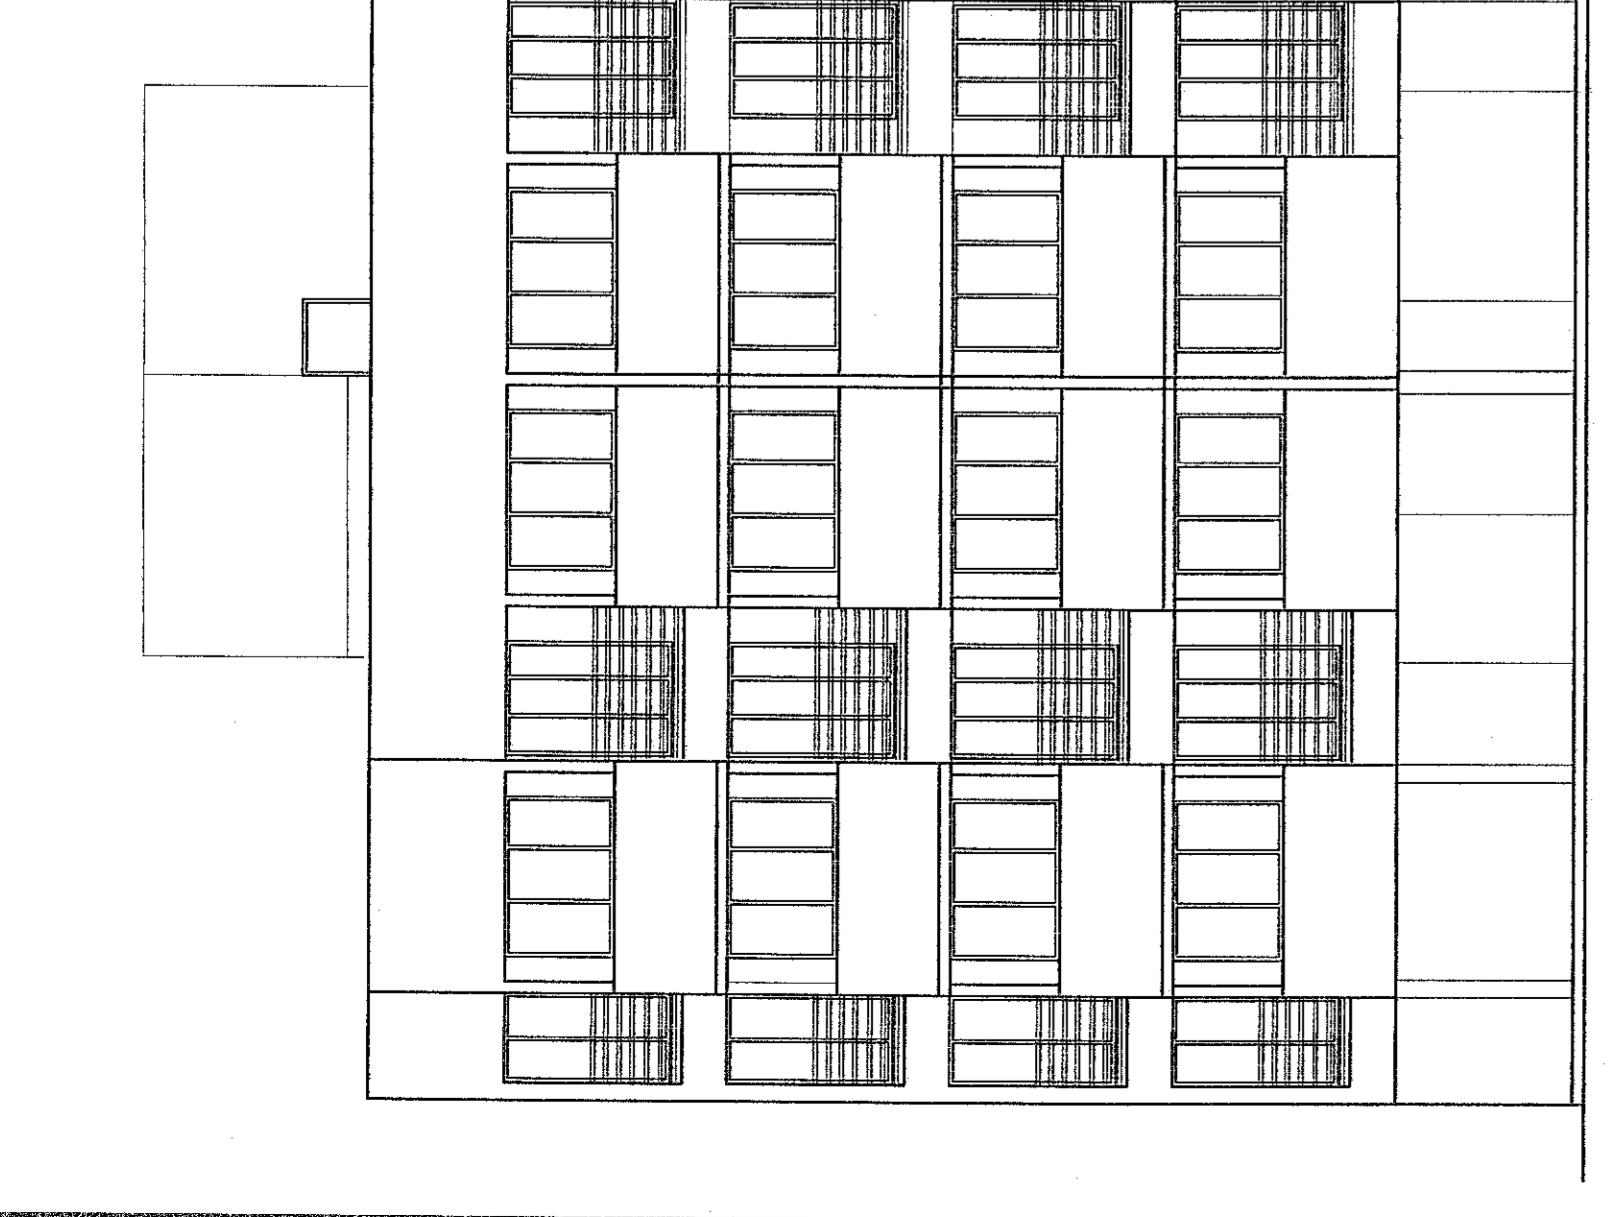


BUILDING NO. B1 TO B6
ELEVATION
 SCALE: 1:100

TEENEMENT AREA STATEMENT (TYPE-B)


BUILDING (WING-B1)		
FLOOR NO.	FLAT No.	B/U AREA
1ST TO 4TH	1	52.021
	2	52.021
	3	52.021
	4	52.021
BUILDING (WING-B2)		
1ST TO 4TH	1	52.021
	2	52.021
	3	52.021
	4	52.021
BUILDING (WING-B3)		
1ST TO 4TH	1	52.021
	2	52.021
	3	52.021
	4	52.021
BUILDING (WING-B4)		
1ST TO 4TH	1	52.021
	2	52.021
	3	52.021
	4	52.021
BUILDING (WING-B5)		
1ST TO 4TH	1	52.021
	2	52.021
	3	52.021
	4	52.021
BUILDING (WING-B6)		
1ST TO 4TH	1	52.021
	2	52.021
	3	52.021
	4	52.021

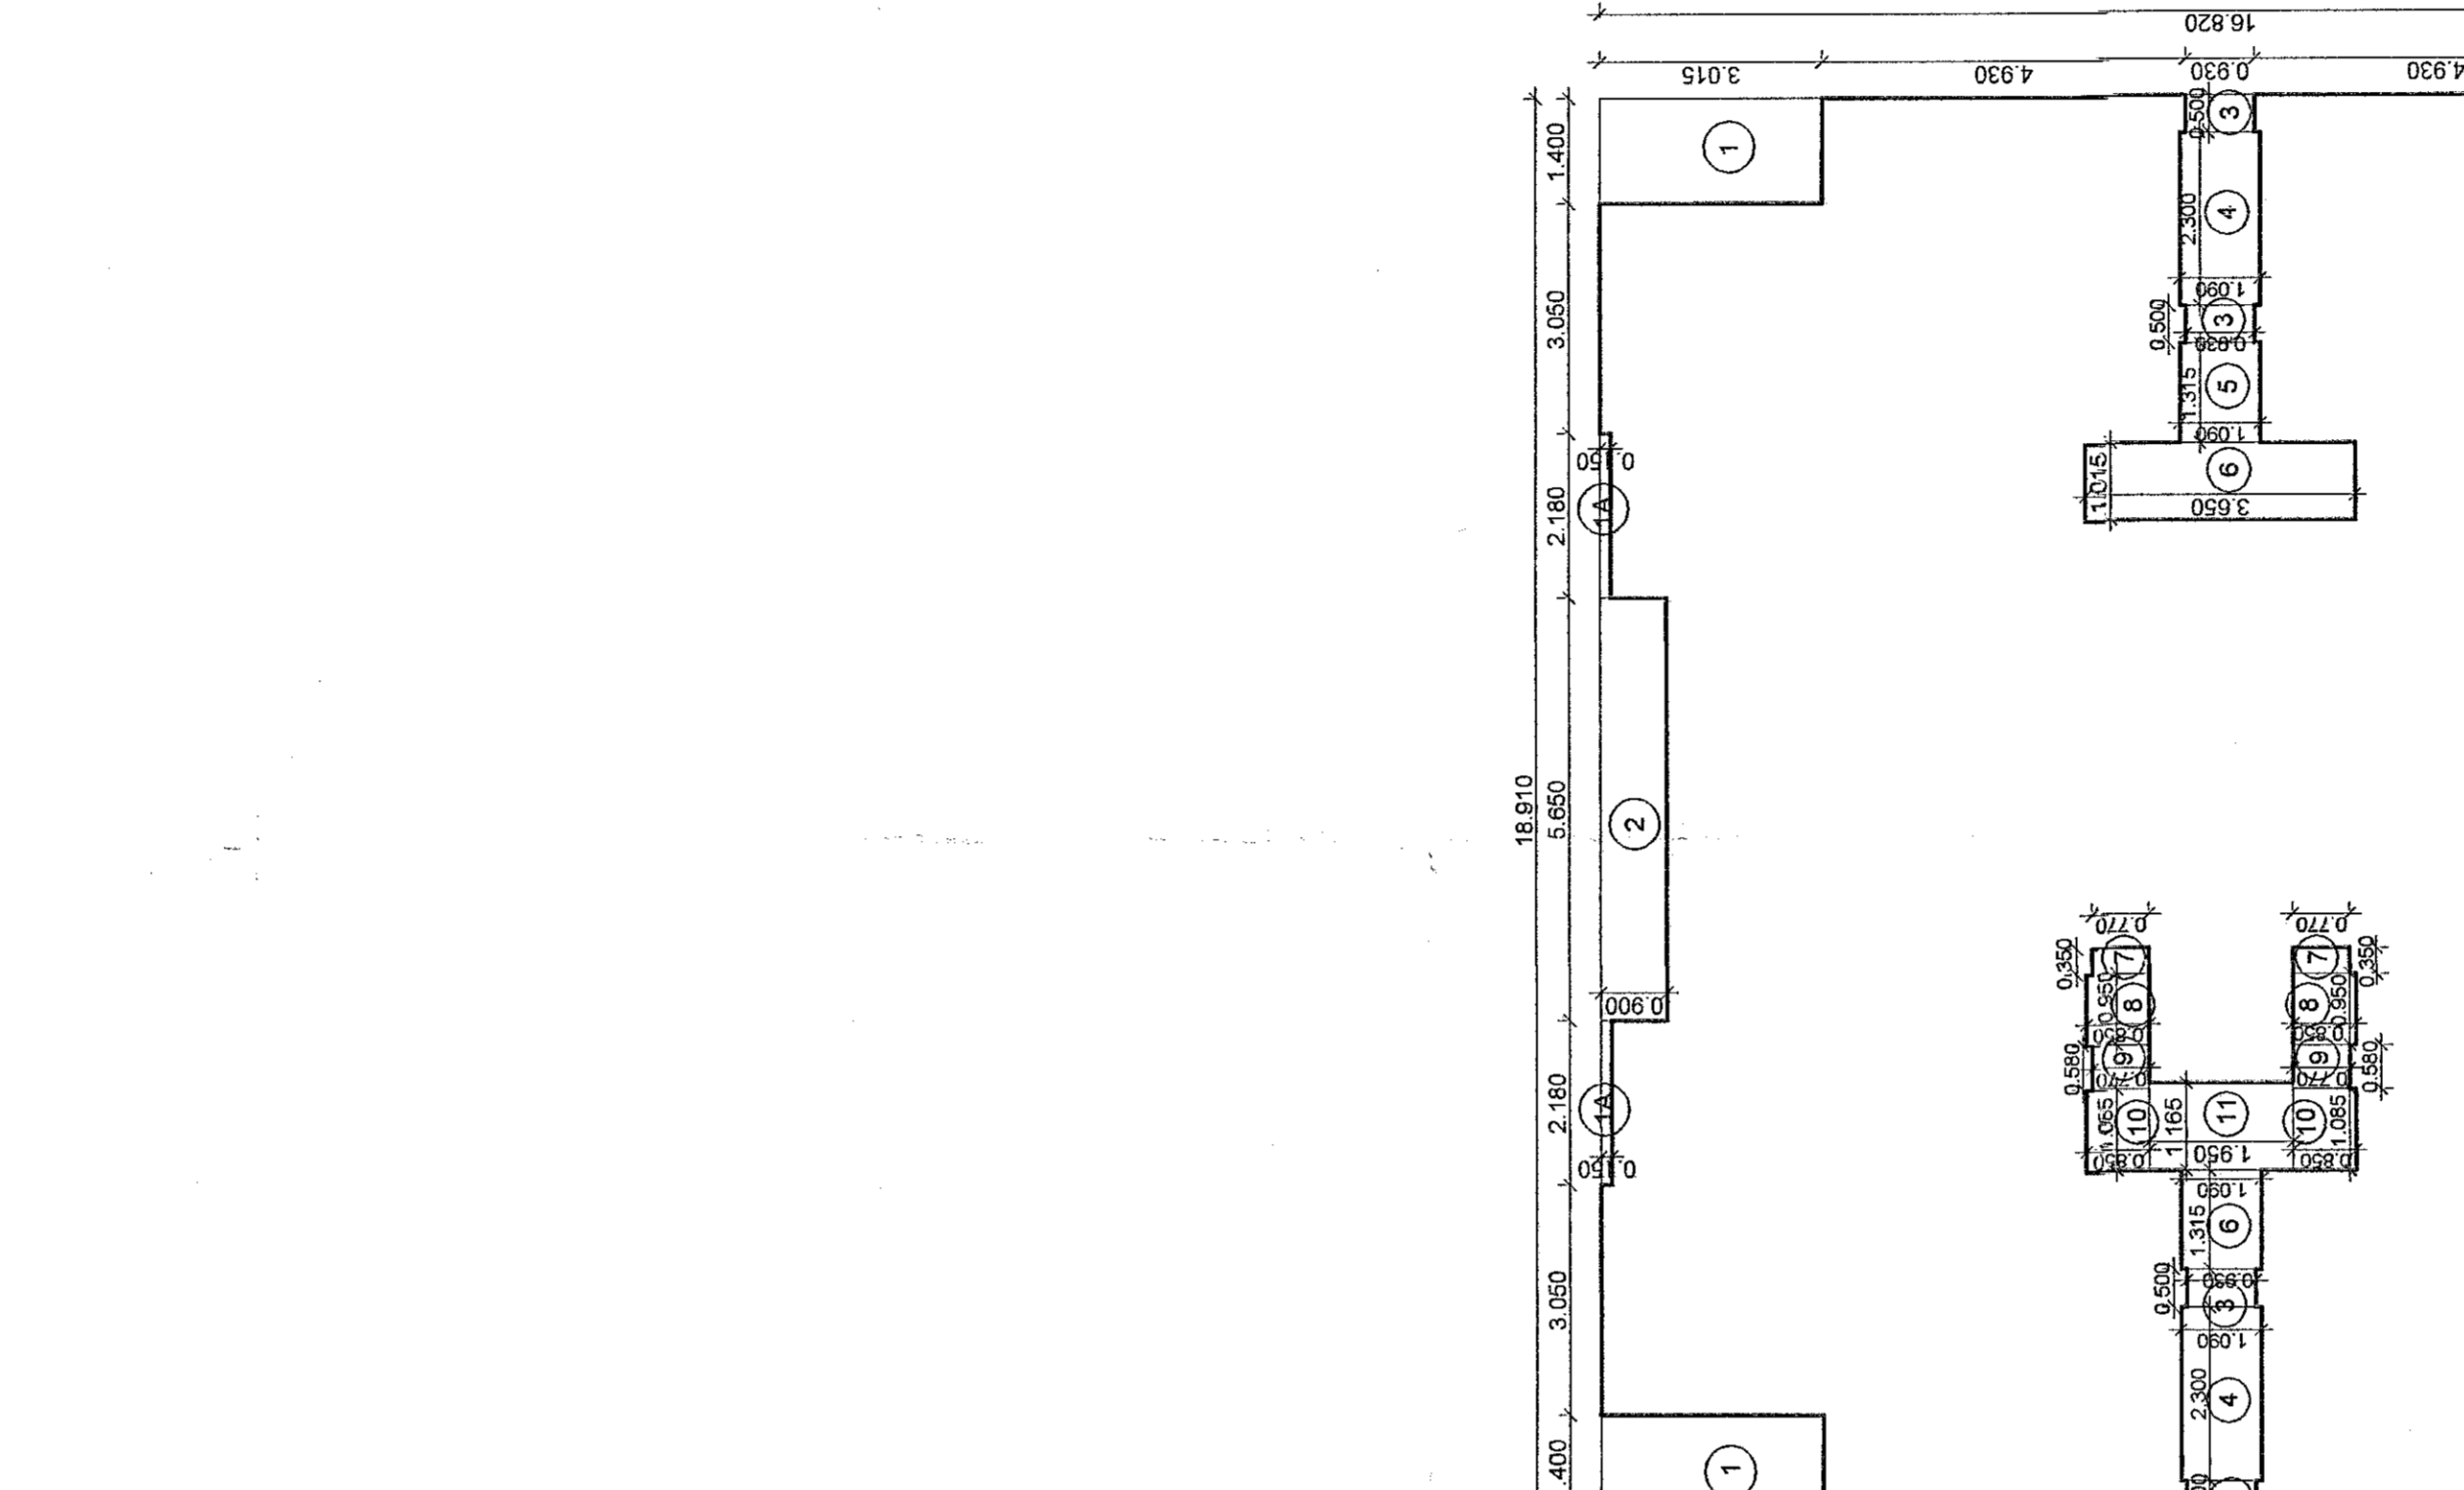

BUILDING NO. B1 TO B6
4TH FLOOR
 SCALE: 1:100

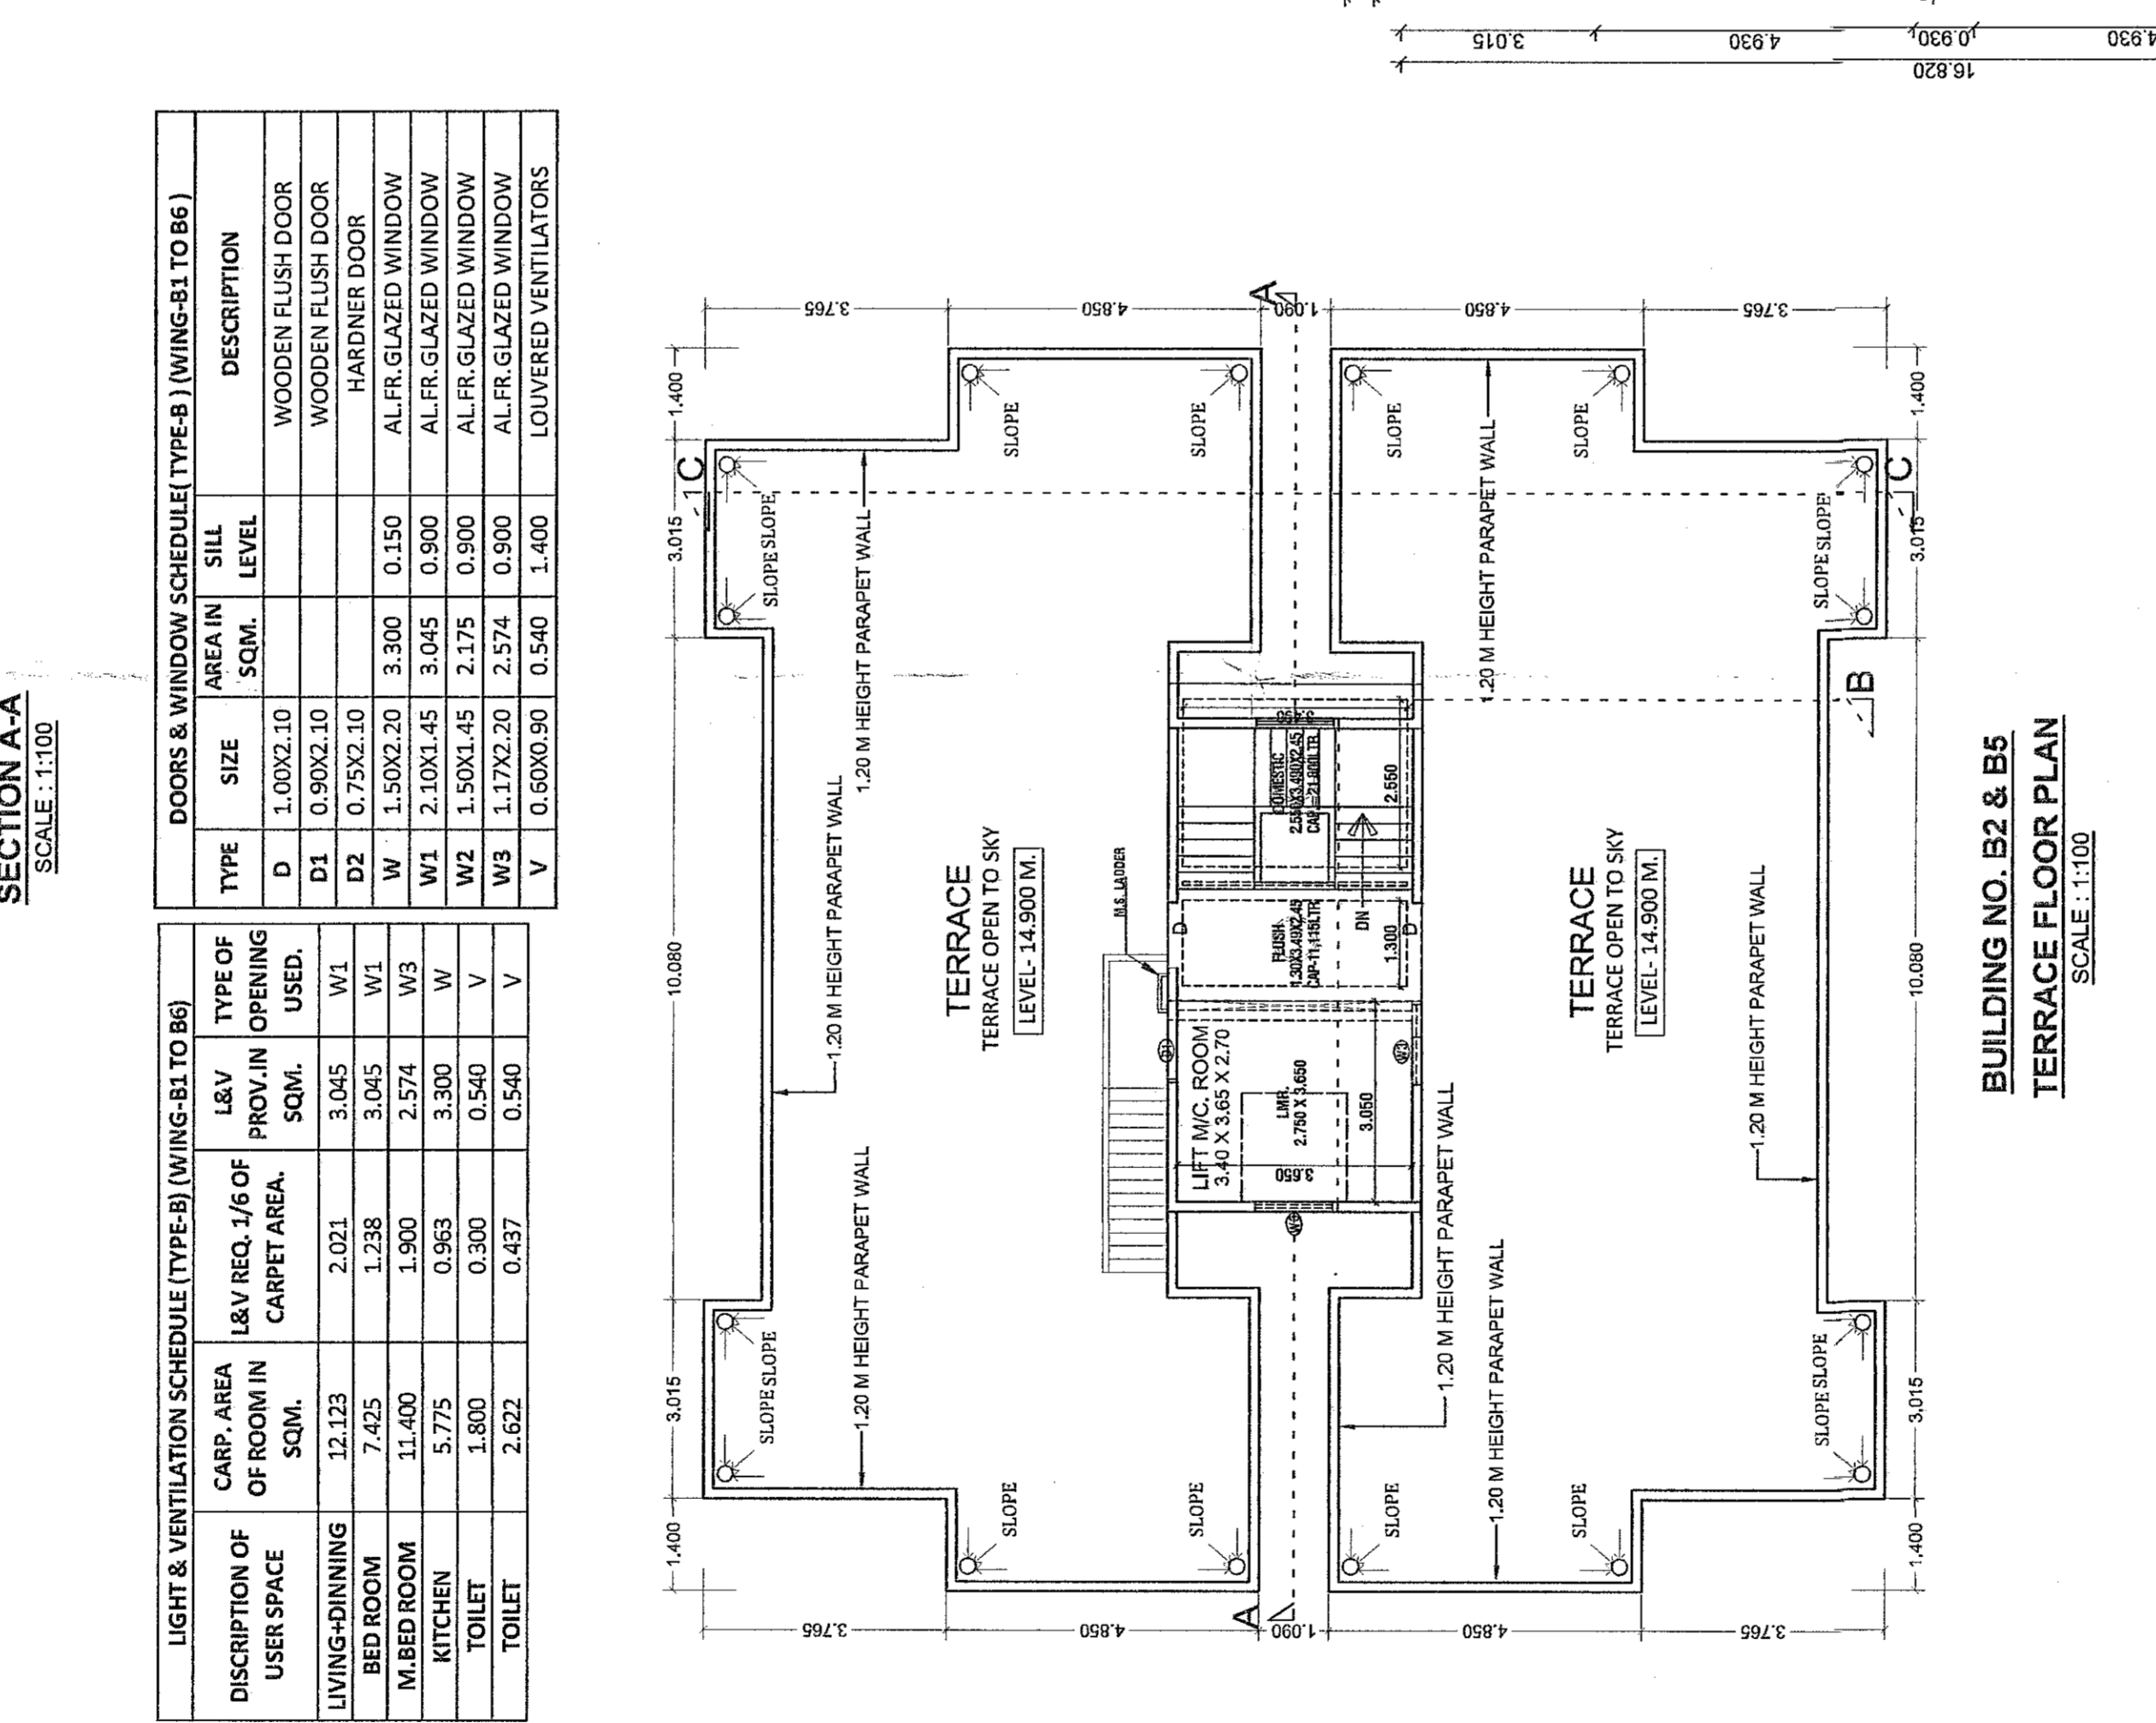


BUILDING NO. B2 & B5
TERRACE FLOOR PLAN
 SCALE: 1:100

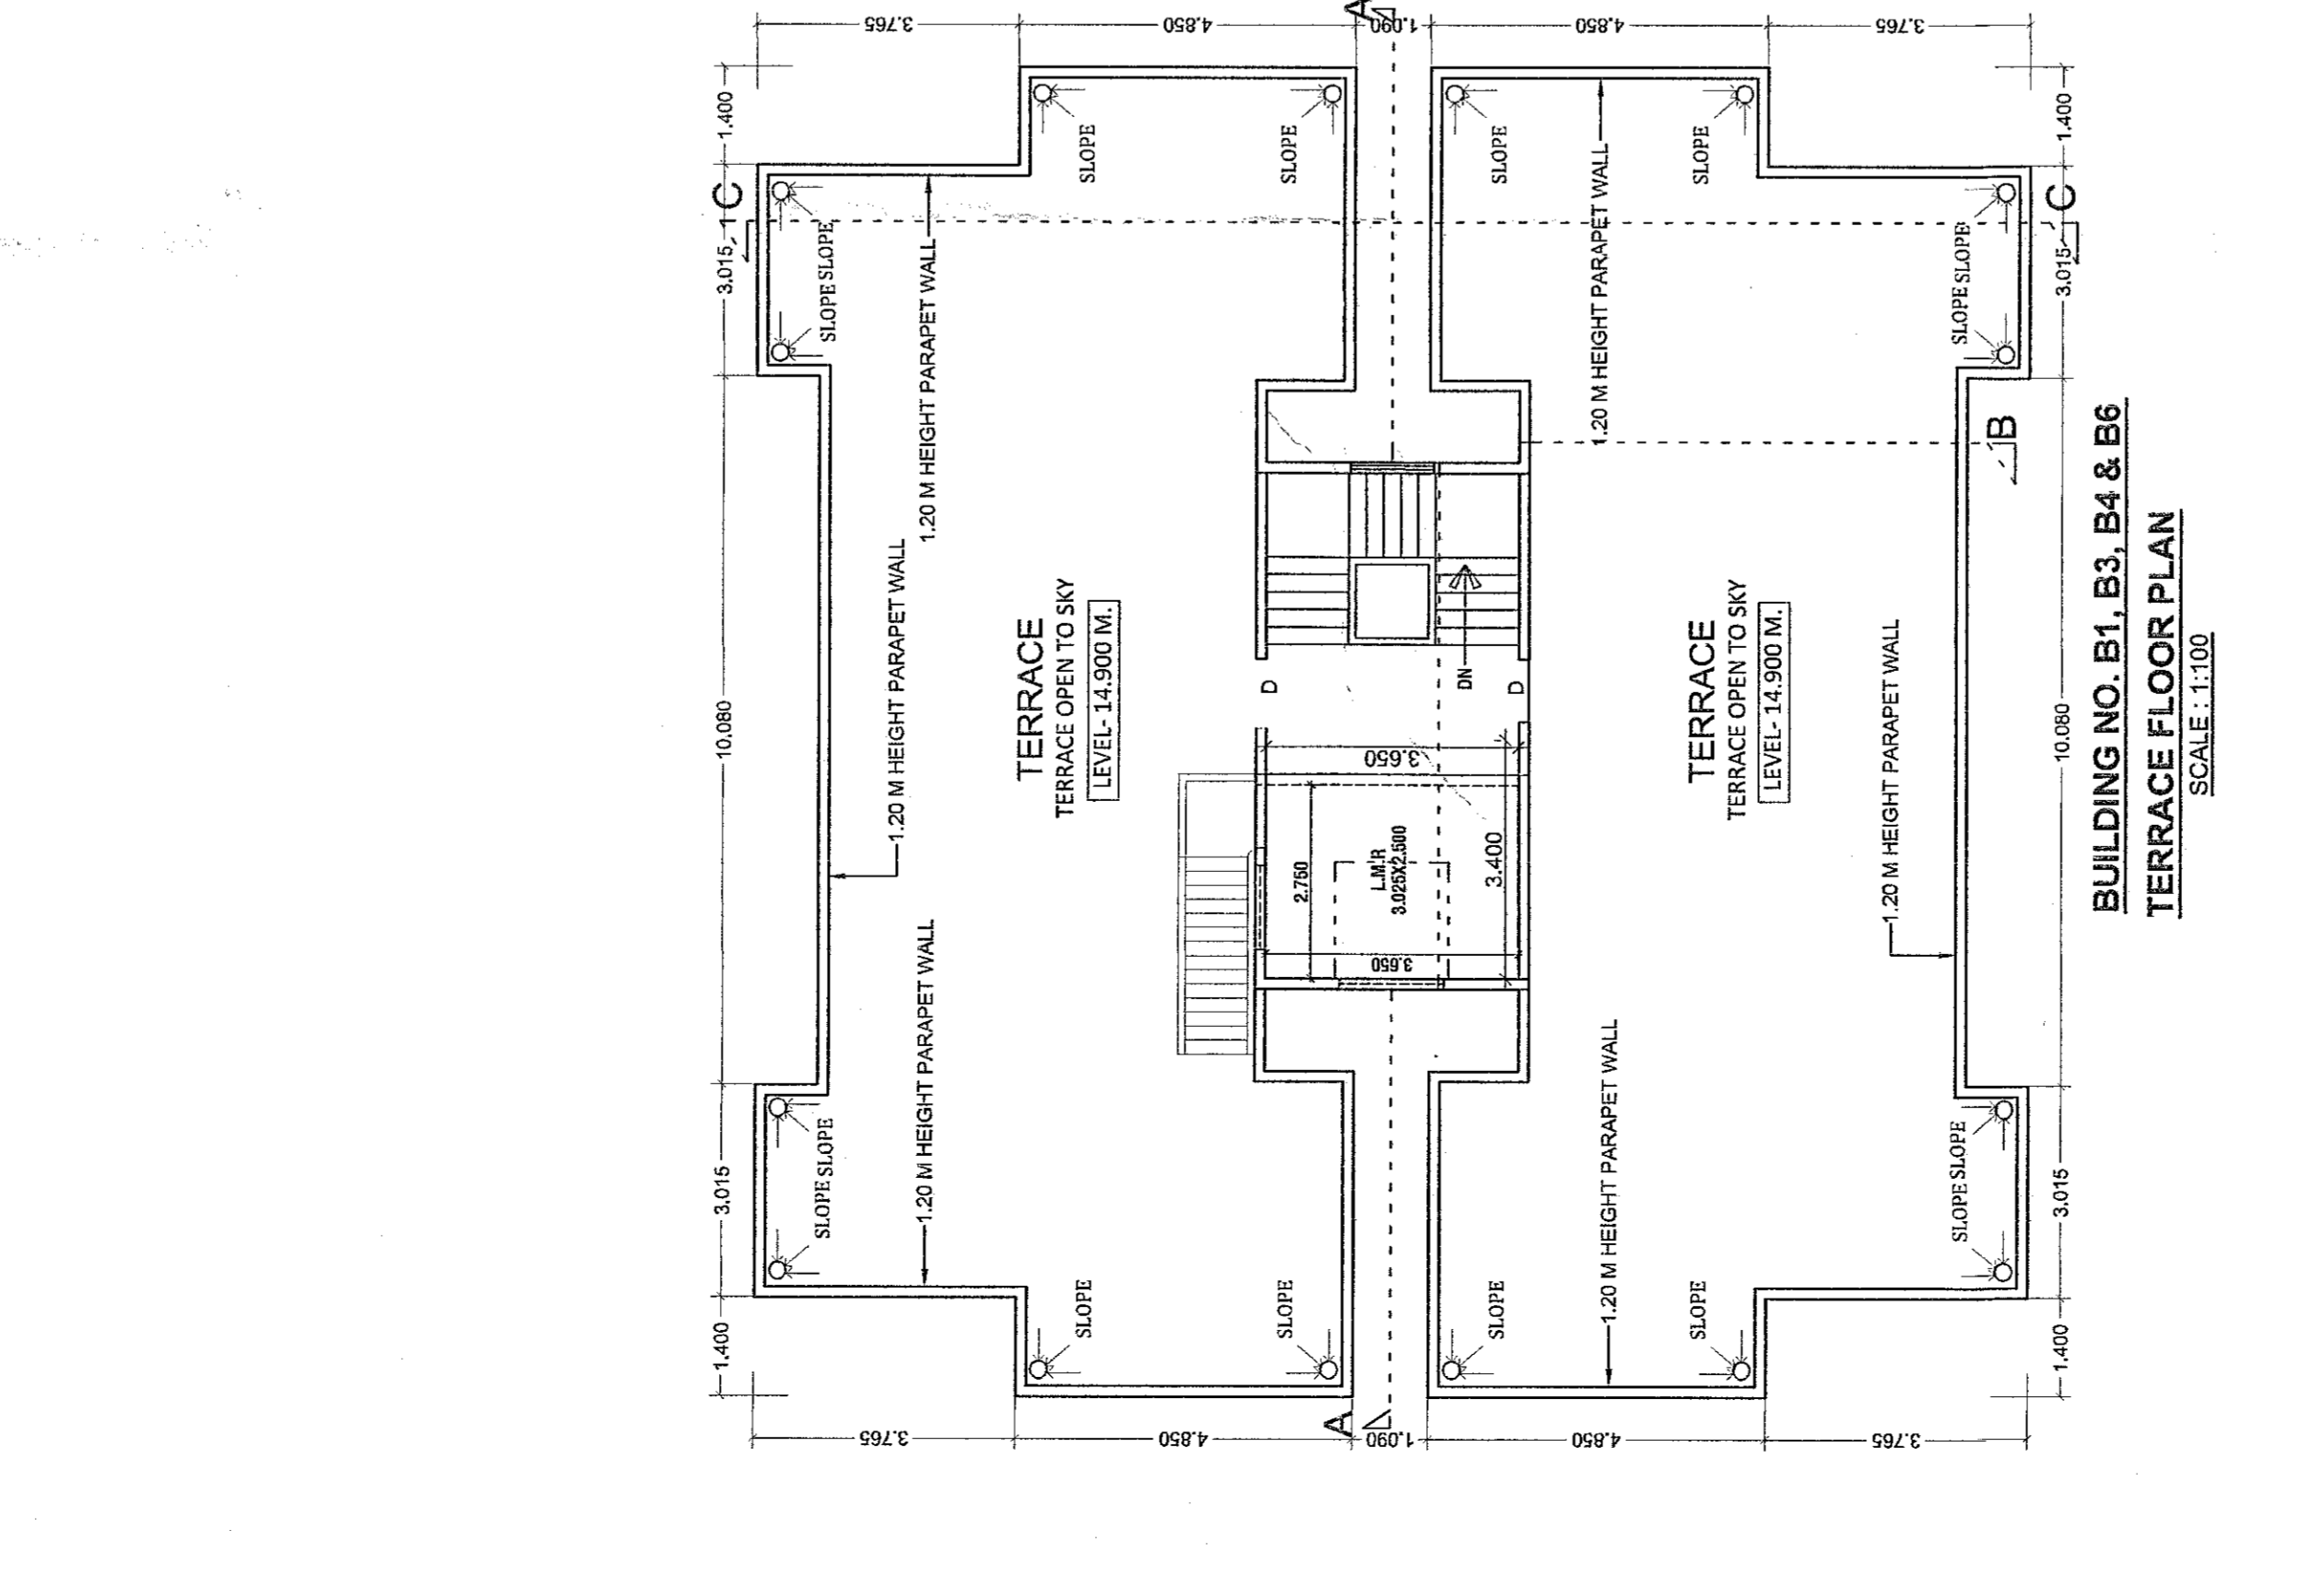


BUILDING NO. B1, B3, B4 & B6
TERRACE FLOOR PLAN
 SCALE: 1:100

4TH FLOOR


BUILDING NO.(B1 TO B6)	
ADDITION (A)	DEDUCTION (B)
18.810 X 16.820 X 1 = 318.066 SQ.MT	1.400 X 0.150 X 4 = 0.840 SQ.MT
TOTAL	16.984 SQ.MT
	1.800 X 0.900 X 2 = 3.240 SQ.MT
	0.500 X 0.900 X 4 = 1.800 SQ.MT
	2.300 X 1.090 X 2 = 5.014 SQ.MT
	1.315 X 1.090 X 2 = 2.867 SQ.MT
	0.350 X 0.770 X 2 = 0.539 SQ.MT
	0.950 X 0.850 X 2 = 1.615 SQ.MT
	0.580 X 0.770 X 2 = 0.893 SQ.MT
	1.085 X 0.850 X 2 = 1.845 SQ.MT
	1.165 X 1.950 X 1 = 2.272 SQ.MT
ROSS AREA (C) = A-B	318.066 - 48.971 = 269.095 SQ.MT
TOTAL BUILT UP AREA	269.095 SQ.MT

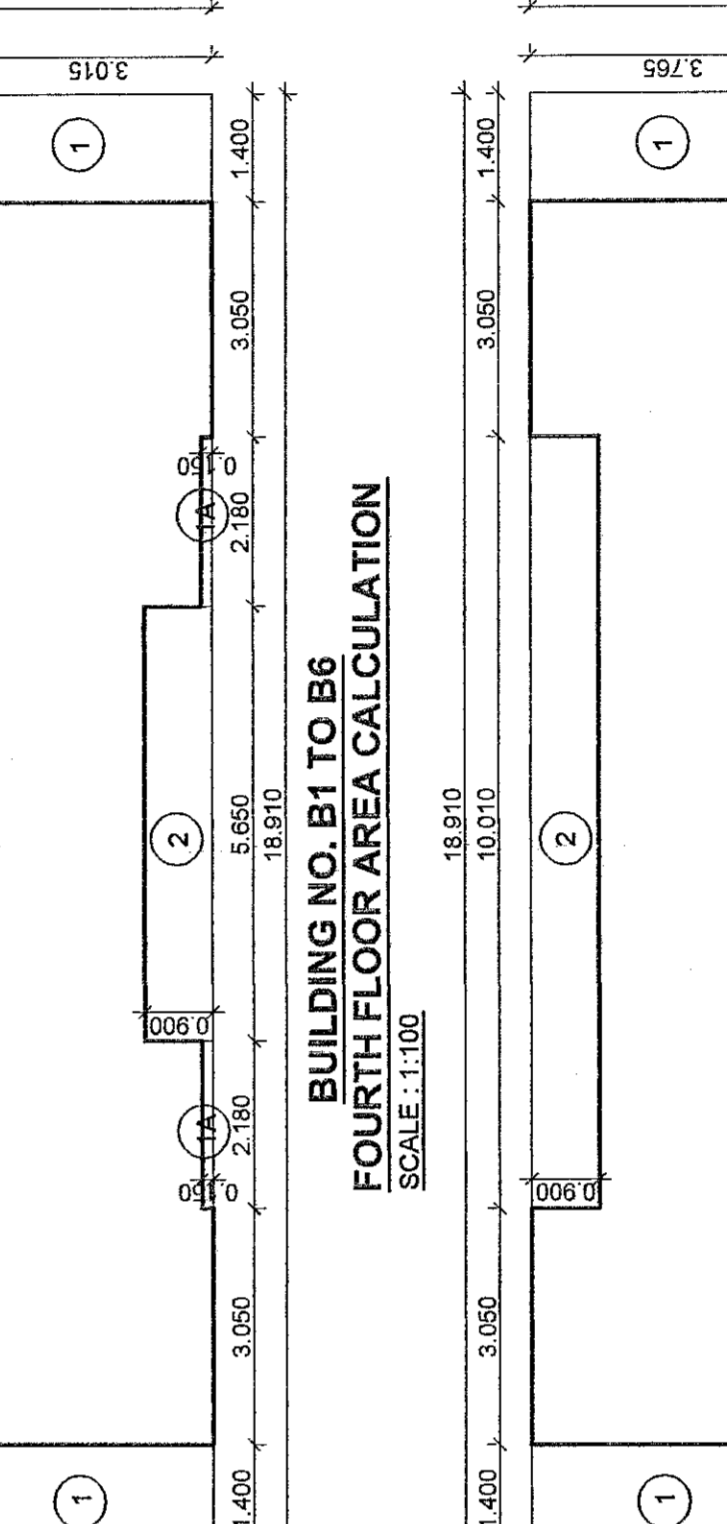

BUILDING NO. B1 TO B6
3RD FLOOR
 SCALE: 1:100

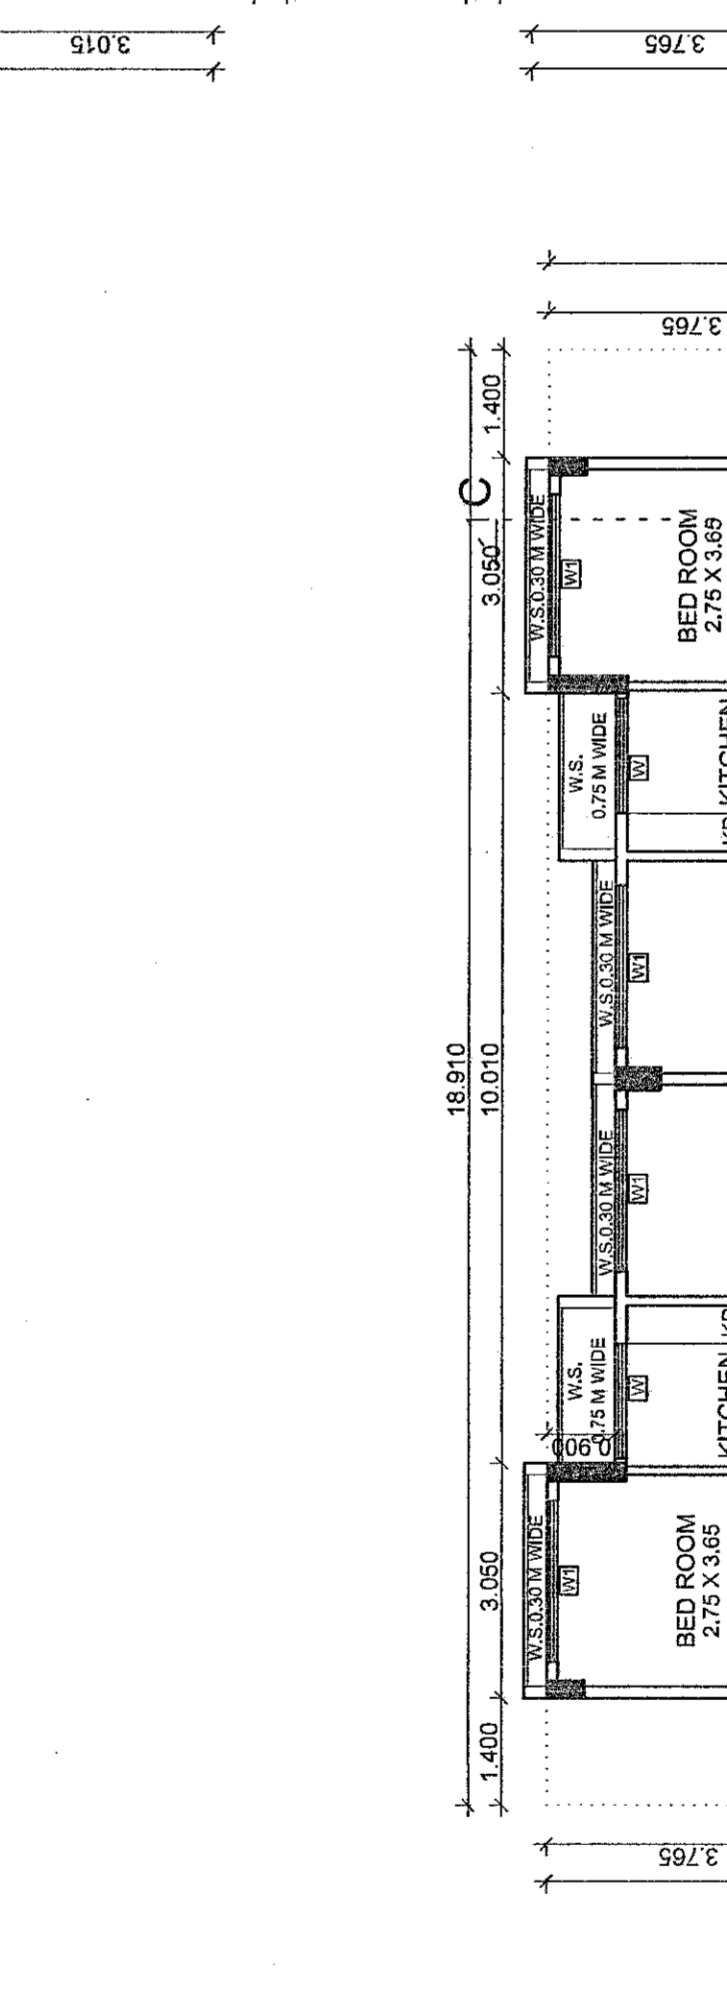


BUILDING NO. B1 TO B6
4TH FLOOR AREA CALCULATION
 SCALE: 1:100

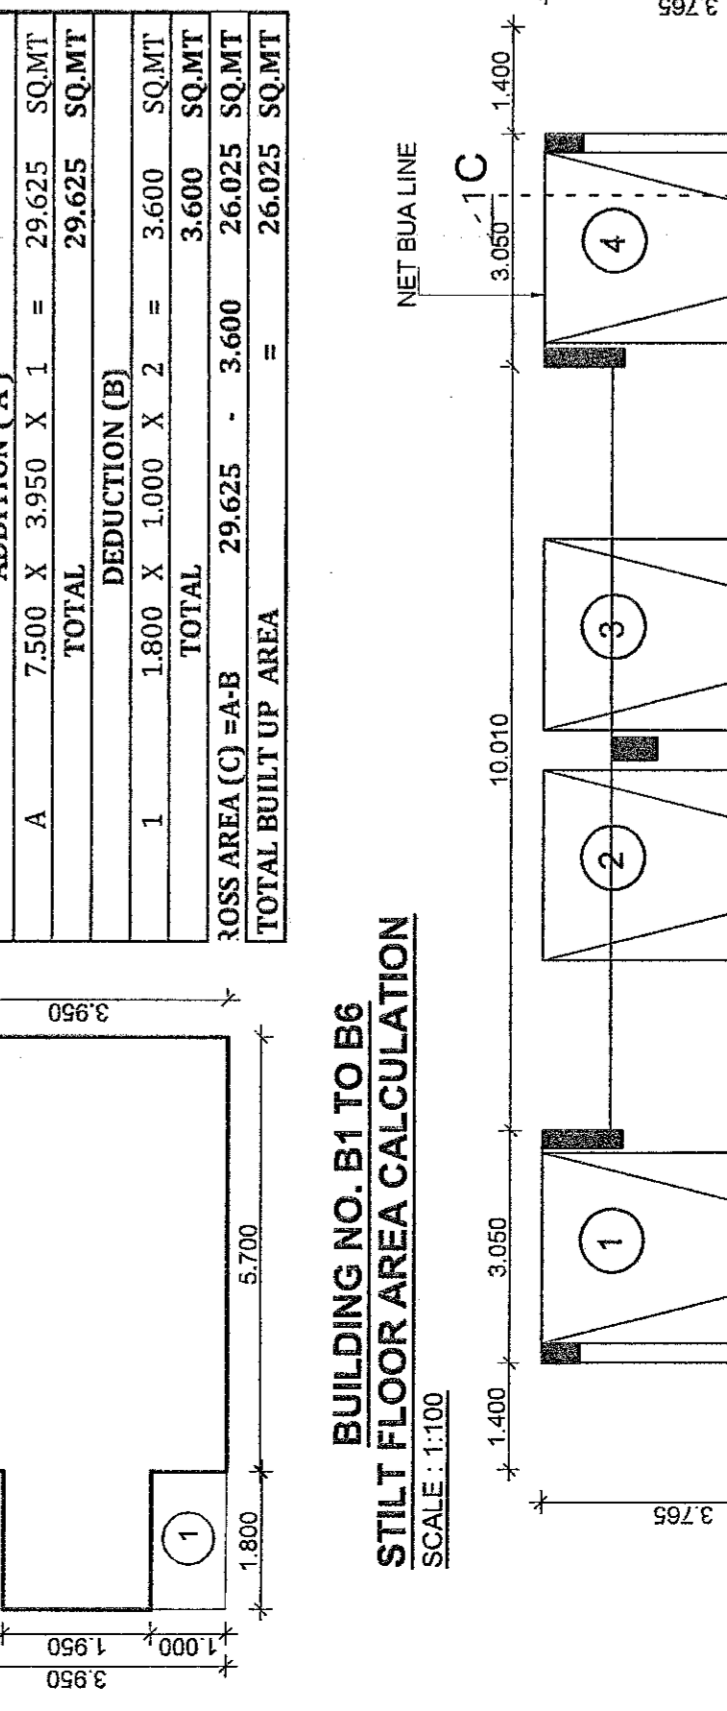


BUILDING NO. B1 TO B6
4TH FLOOR AREA CALCULATION
 SCALE: 1:100

5TH FLOOR


BUILDING NO.(B1 TO B6)	
ADDITION (A)	DEDUCTION (B)
18.810 X 16.820 X 1 = 318.066 SQ.MT	1.400 X 0.150 X 4 = 0.840 SQ.MT
TOTAL	16.984 SQ.MT
	1.800 X 0.900 X 2 = 3.240 SQ.MT
	0.500 X 0.900 X 4 = 1.800 SQ.MT
	2.300 X 1.090 X 2 = 5.014 SQ.MT
	1.315 X 1.090 X 2 = 2.867 SQ.MT
	0.350 X 0.770 X 2 = 0.539 SQ.MT
	0.950 X 0.850 X 2 = 1.615 SQ.MT
	0.580 X 0.770 X 2 = 0.893 SQ.MT
	1.085 X 0.850 X 2 = 1.845 SQ.MT
	1.165 X 1.950 X 1 = 2.272 SQ.MT
ROSS AREA (C) = A-B	318.066 - 48.971 = 269.095 SQ.MT
TOTAL BUILT UP AREA	269.095 SQ.MT

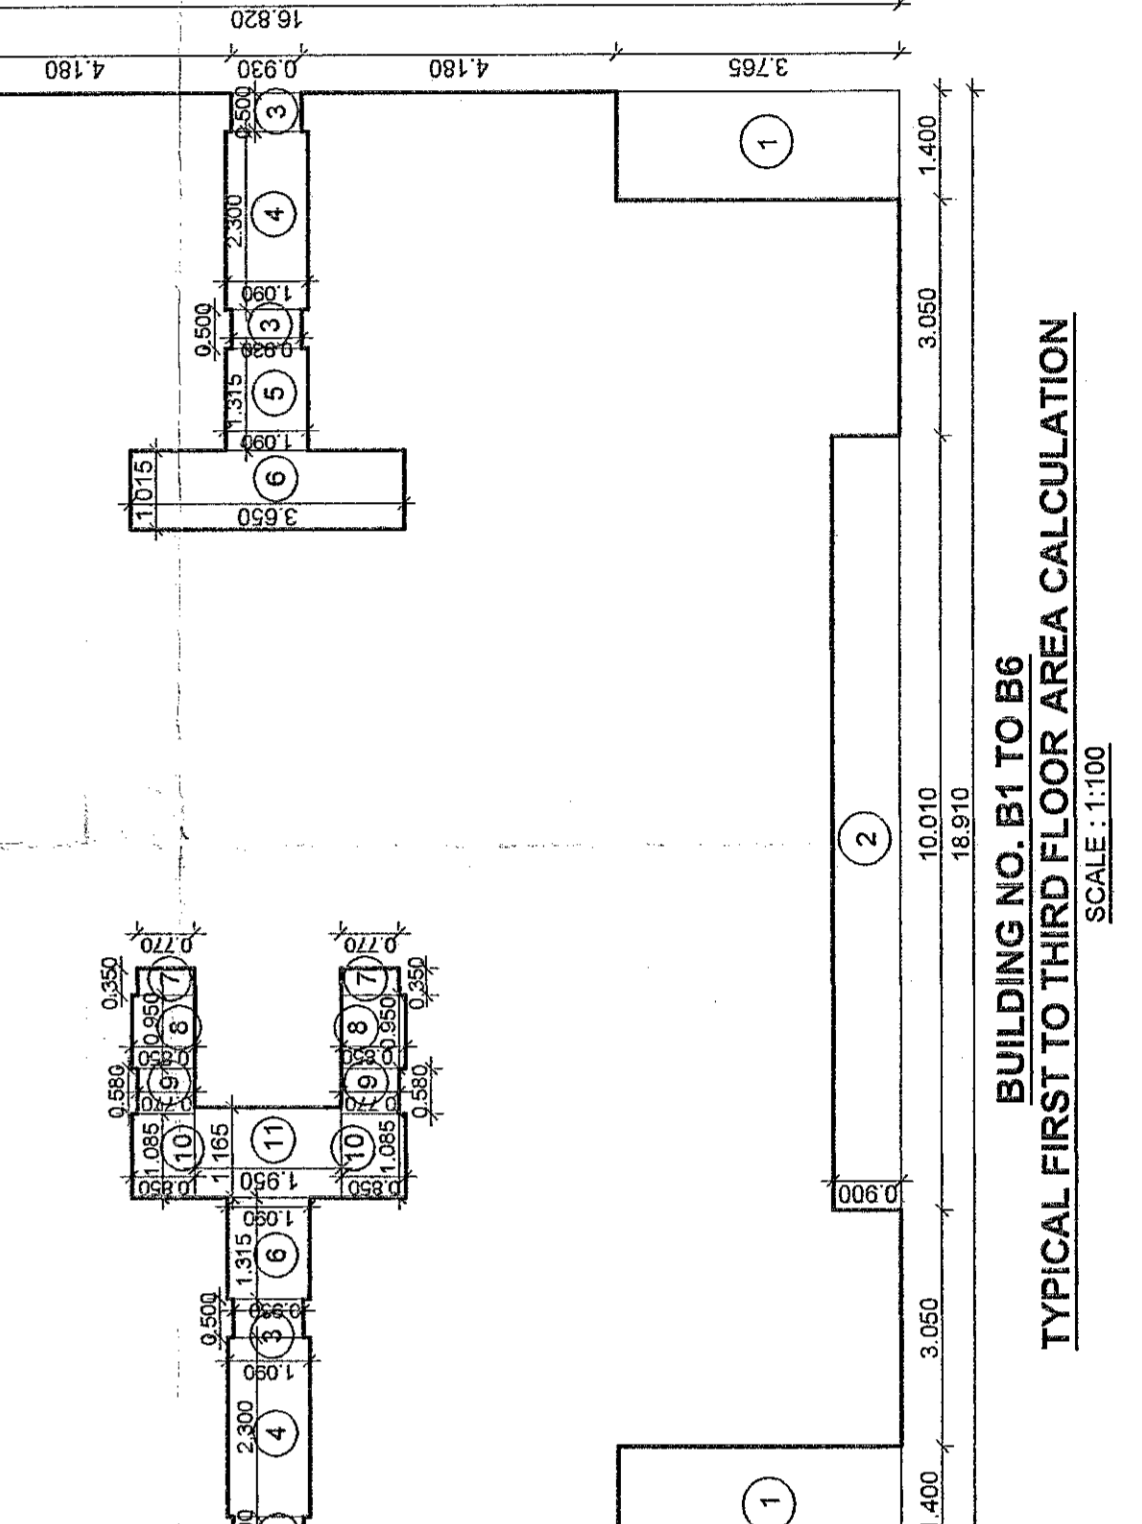

BUILDING NO. B1 TO B6
TYPICAL FIRST TO THIRD FLOOR AREA CALCULATION
 SCALE: 1:100

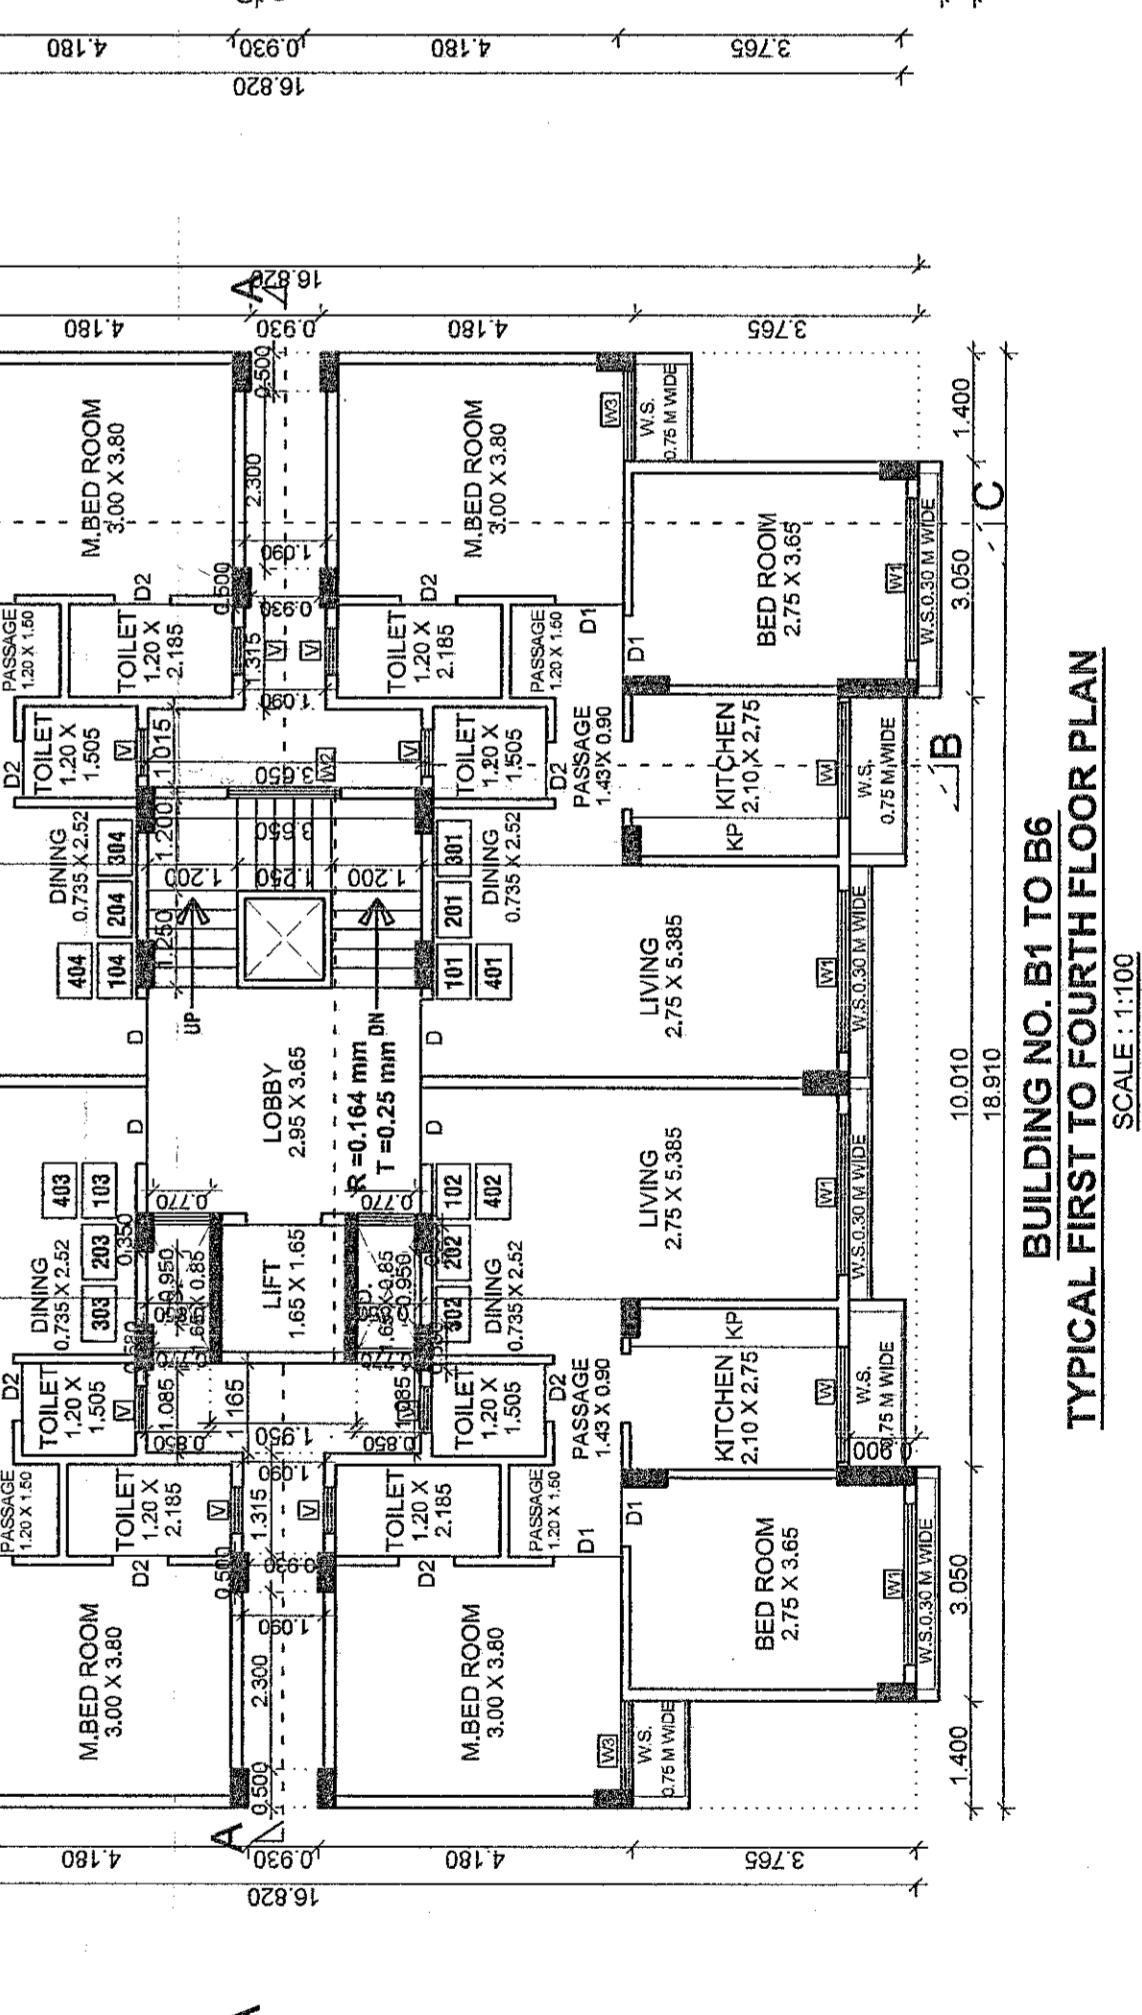

BUILDING NO. B1 TO B6
TYPICAL FIRST FLOOR PLAN
 SCALE: 1:100

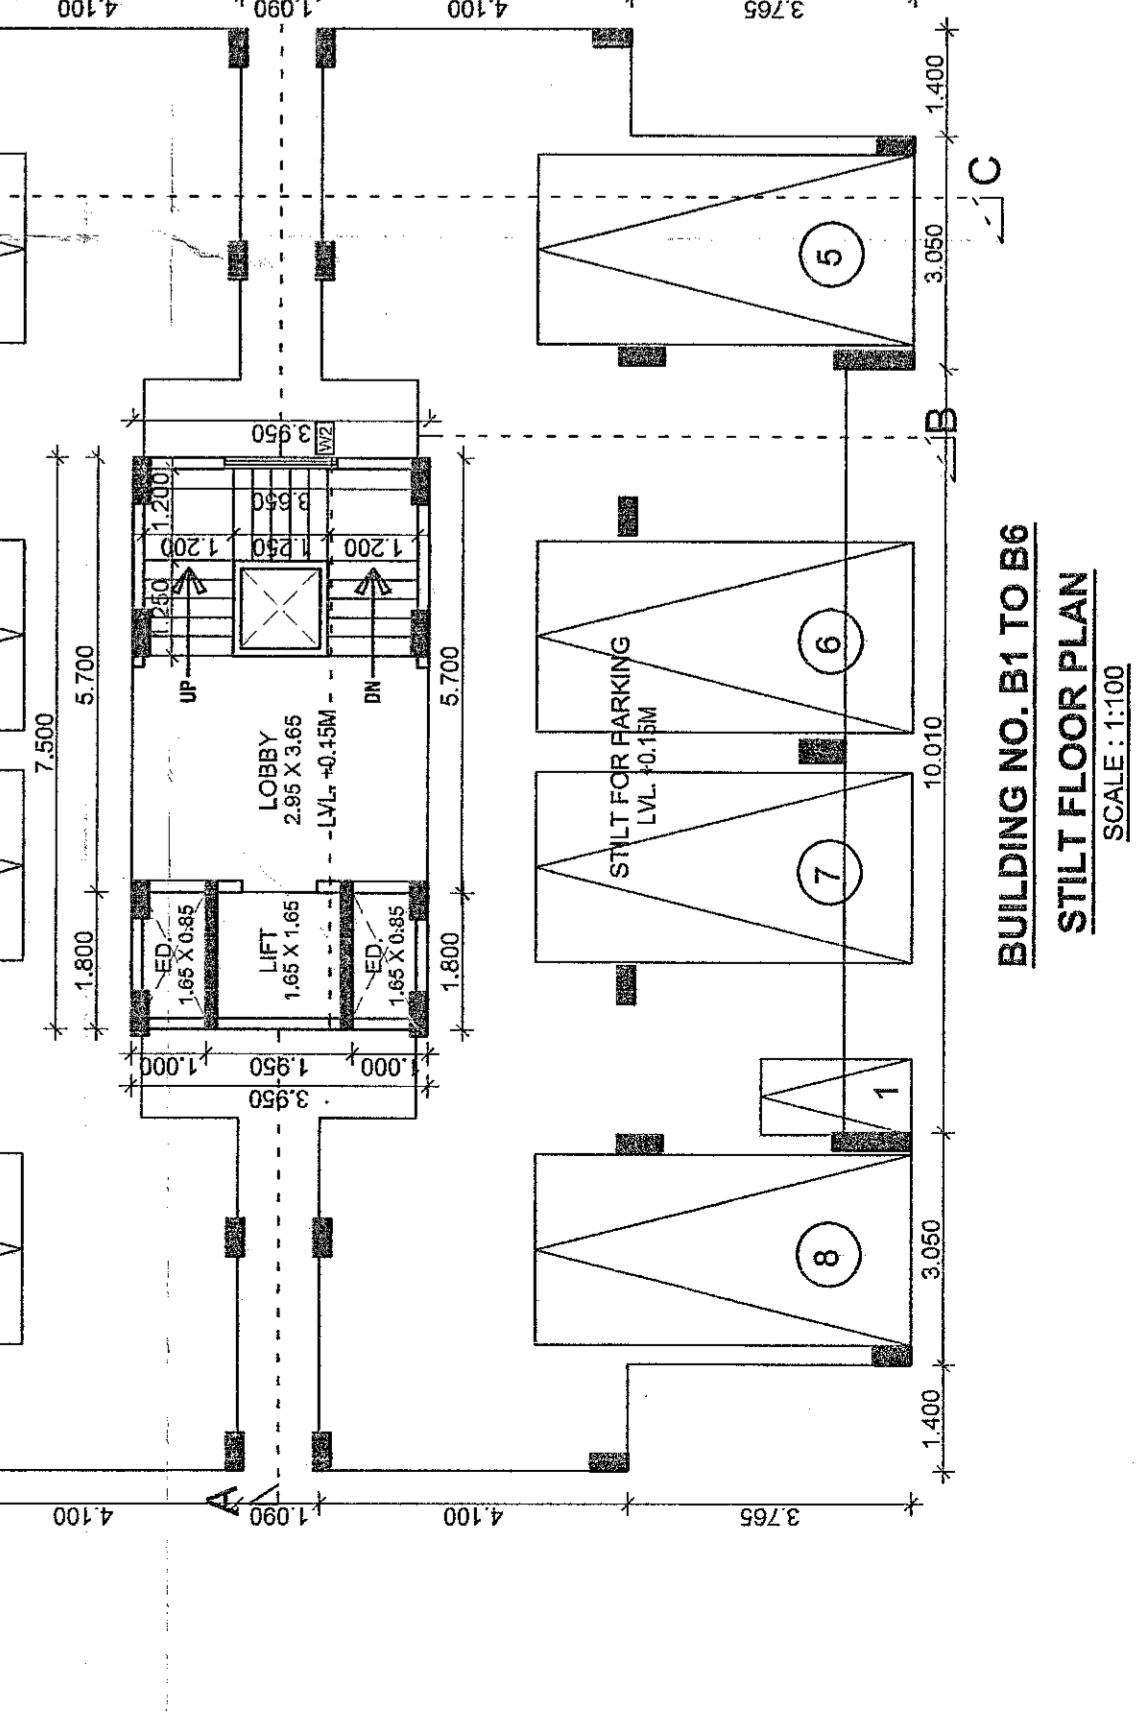

BUILDING NO. B1 TO B6
TYPICAL FIRST FLOOR PLAN
 SCALE: 1:100

CONCEPT
 DESIGN CELL
 Architects & Associates
 OFF: G-9, 1ST FL., NEIGHBORHOOD SHOPPING COMPLEX,
 SEC-14,REBULI, NAVI MUMBAI 400706. PH: 9822920111.

OWNER NAME & SIGN
 M/S ARIHANT AASHYANA PVT. LTD.
 MR. ASHOK B. CHHAJER
 ARCHITECT NAME & SIGN
 ARCH. PIYUSH TAK
 REG. NO. CA/28272201

DESCRIPTION OF PROPOSAL & PROPERTY
 AS BUILT DRAWINGS FOR PART OCCUPANCY OF
 BUILDINGS ON GUT. NO. 87/2, AT VILLAGE-MAHODAR
 TALUKA-PANVEL, DIST-RANGAD.

DATE 17/02/2018
SCALE 1:100
DRN. BY ...

BUILT UP AREA SUMMARY IN SQ.MT.

FLOOR	WING-B1	WING-B2	WING-B3	WING-B4	WING-B5	WING-B6
GROUND FLOOR	298.383	258.355	284.353	284.353	284.353	284.353
1ST FLOOR	298.383	258.355	284.353	284.353	284.353	284.353
2ND FLOOR	298.383	258.355	284.353	284.353	284.353	284.353
3RD FLOOR	298.383	258.355	284.353	284.353	284.353	284.353
4TH FLOOR	298.383	258.355	284.353	284.353	284.353	284.353
5TH FLOOR	298.383	258.355	284.353	284.353	284.353	284.353
TOTAL	1491.915	1291.773	1421.813	1421.813	1421.813	1421.813