

APPROVING AUTHORITY

TESTED



Gokul (Manik) Laxmanrao Jaybhawe
Special Executive Officer,
Gidon Nashik

B. W. M.

OWNER'S SIGNATURE

1) PLOT AREA UND → 35.28 M²
(APPROX)

2) SCHEME BUILT UP → 18.06 SQM

3) FUTURE EXTENSION → 7.70 SQM (approx)
(G.F.)

4) FIRST FLOOR B | UP → 14.616 SQM

5) STAIR CASE AREA → 4.38 SQM

F F & STAIR CASE

= 18.996 SQM T (APPROX)

TREAD = 25 CM

RISER = 19 CM

NAME OF TENEMENT HOLDER *Sr B.A. Wani*

TENEMENT NO.


↳ N-32/N2/4/5

as amended in Red.
the conditions mentioned in
the letter no. BPINT/NSK/ADM/

01/172/1973/2010

[Signature]

stant Exe. Engineer

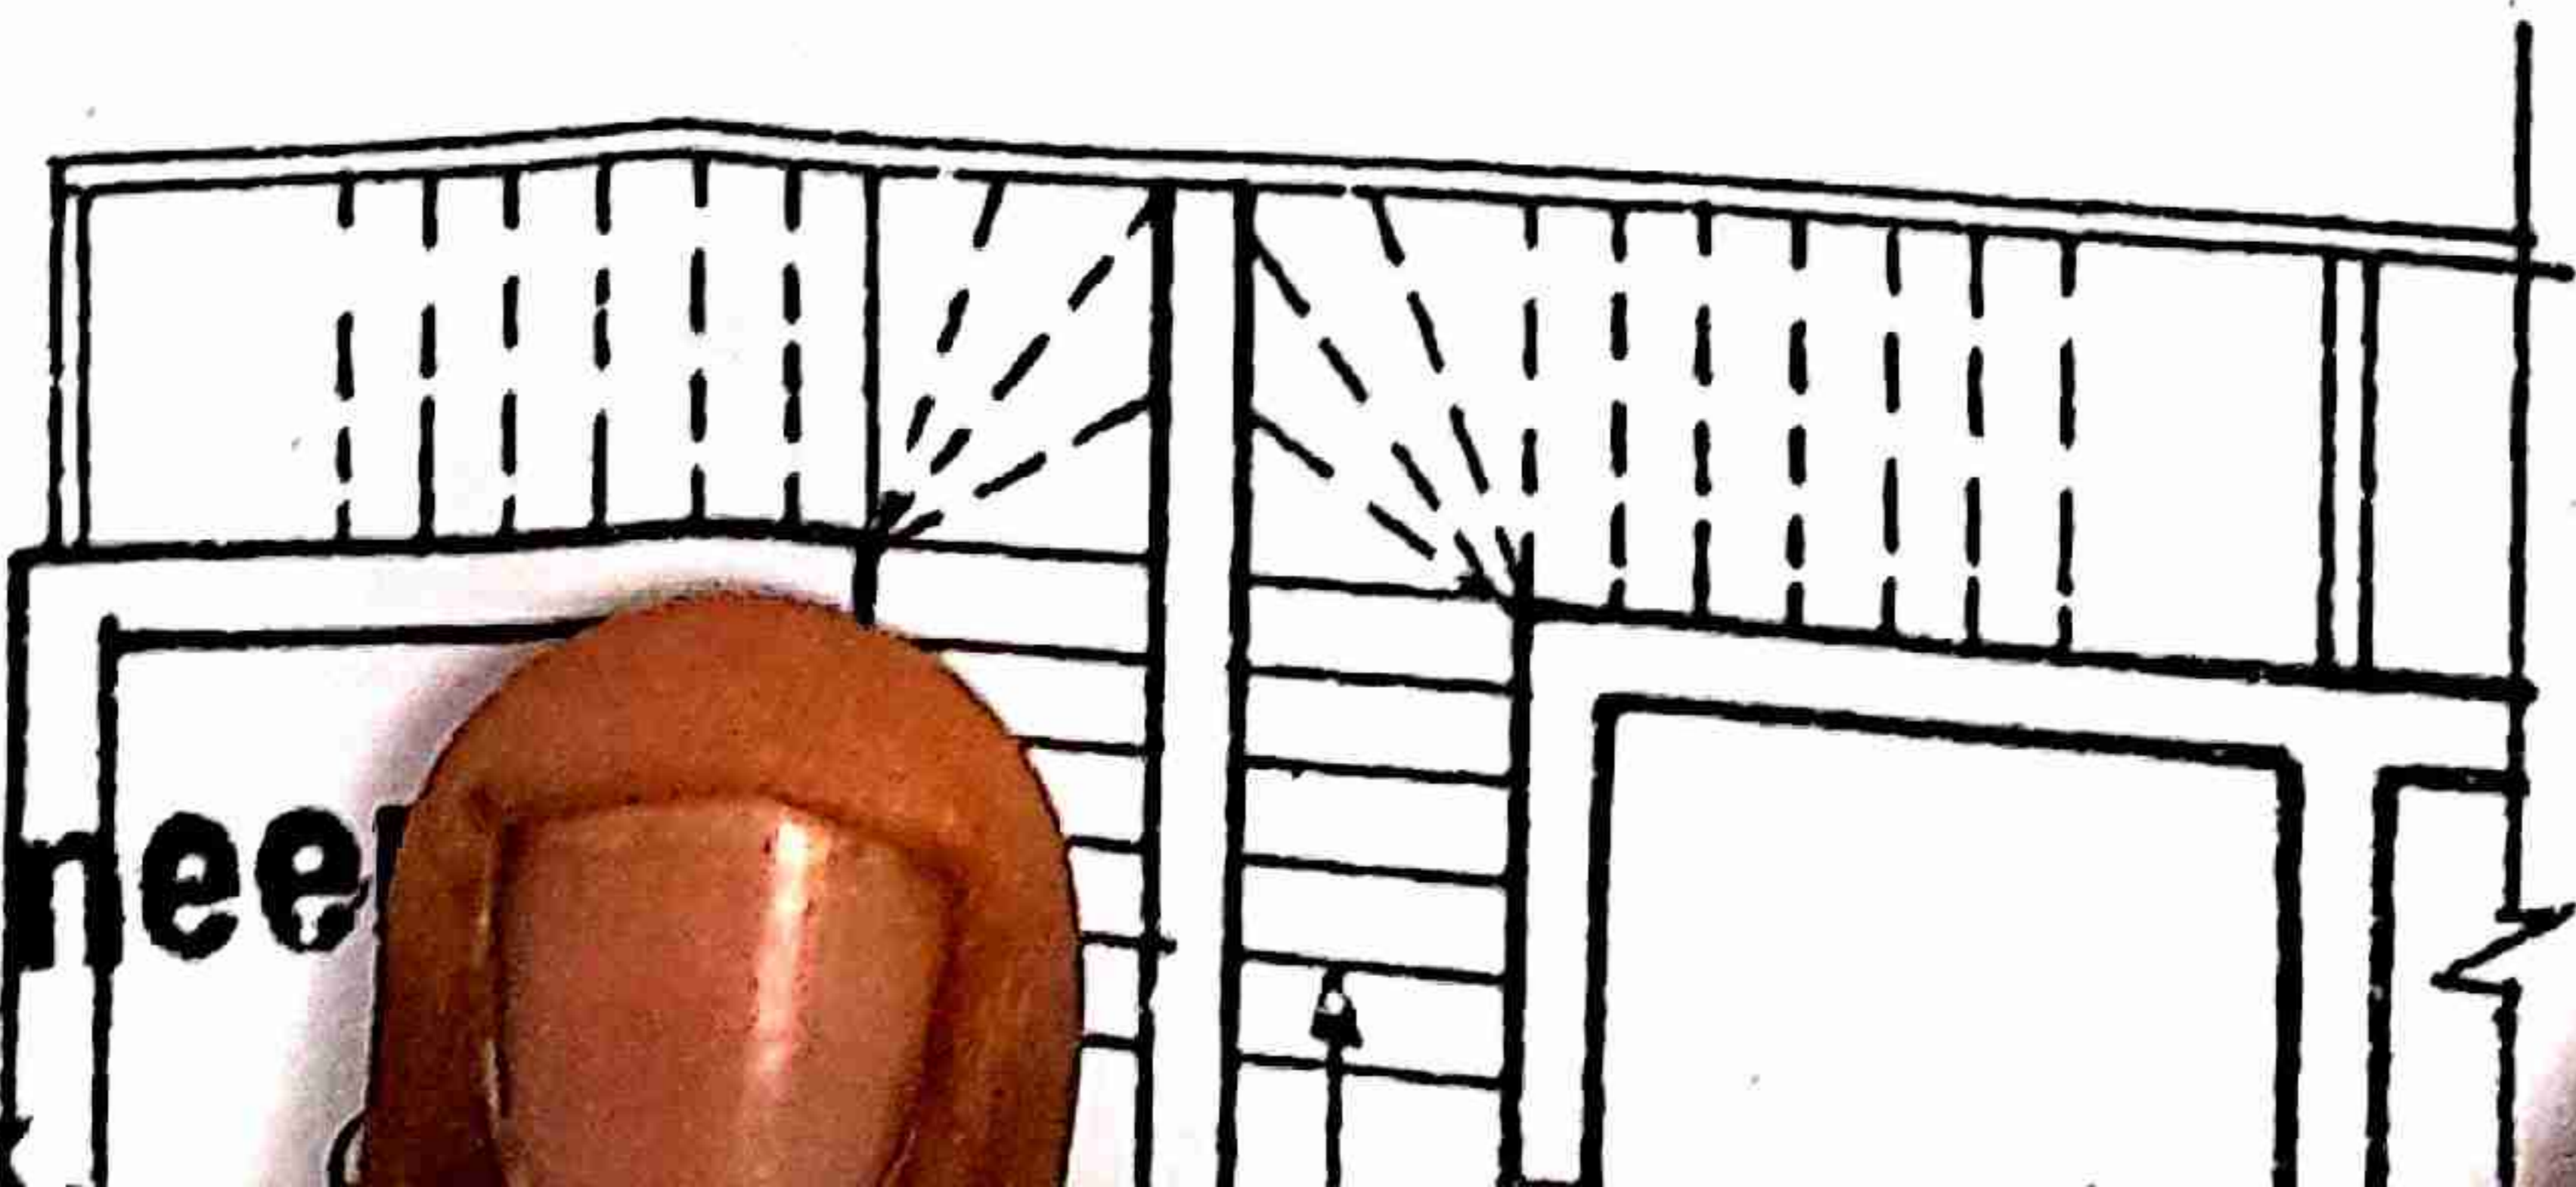

CIDCO LTD

PLANNING (NT) NEW AURANGABAD

TYPE DESIGN WITH
ADDITIONAL CONST.
NEW NASHIK.

LIGN-32

HOUSING SCHEEM

NO

LOCATION

IIIrd

SCALE-1:100

DRAWN BY-

R.L. NIRHALI

ASST PLANNER -


R.M. MANKAR

ASSO / SR-PLANNER -

R.Y. PHADKE

मजल्यावर पहिल्या मजल्यावर
पर्यायानगी देण्यात येत आहे. या
मजल्यावर पर्यायानगी देण्यात येणारी मजली

2100

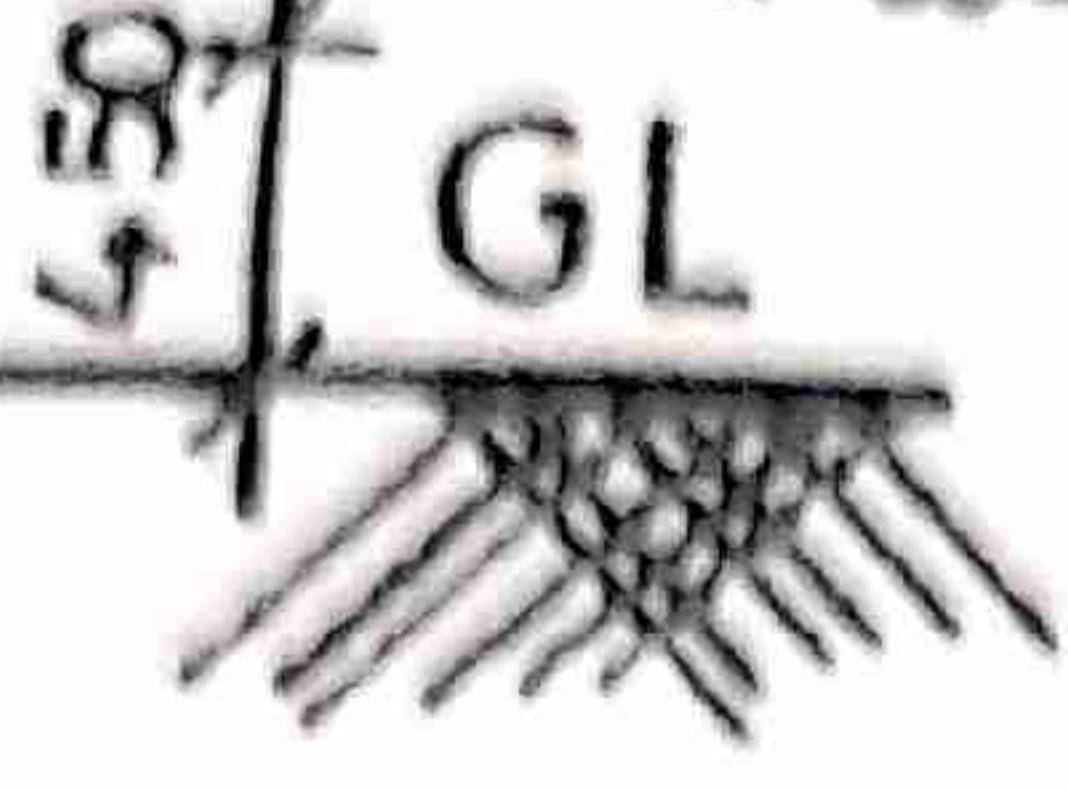

TION AT A A

NAME OF TENEMENT


Approved as amended in Red.
Subject to the conditions mentioned in
this office letter no. BP/INT/NSK/ADM/
2009-2010/172


TENEMENT NO. 7

Dated 19/3/2010

[Signature]
Assistant Exe. Engineer
CIDCO New Nashik.

Allowable / Proposed Built-up Area shown in Colour Red.


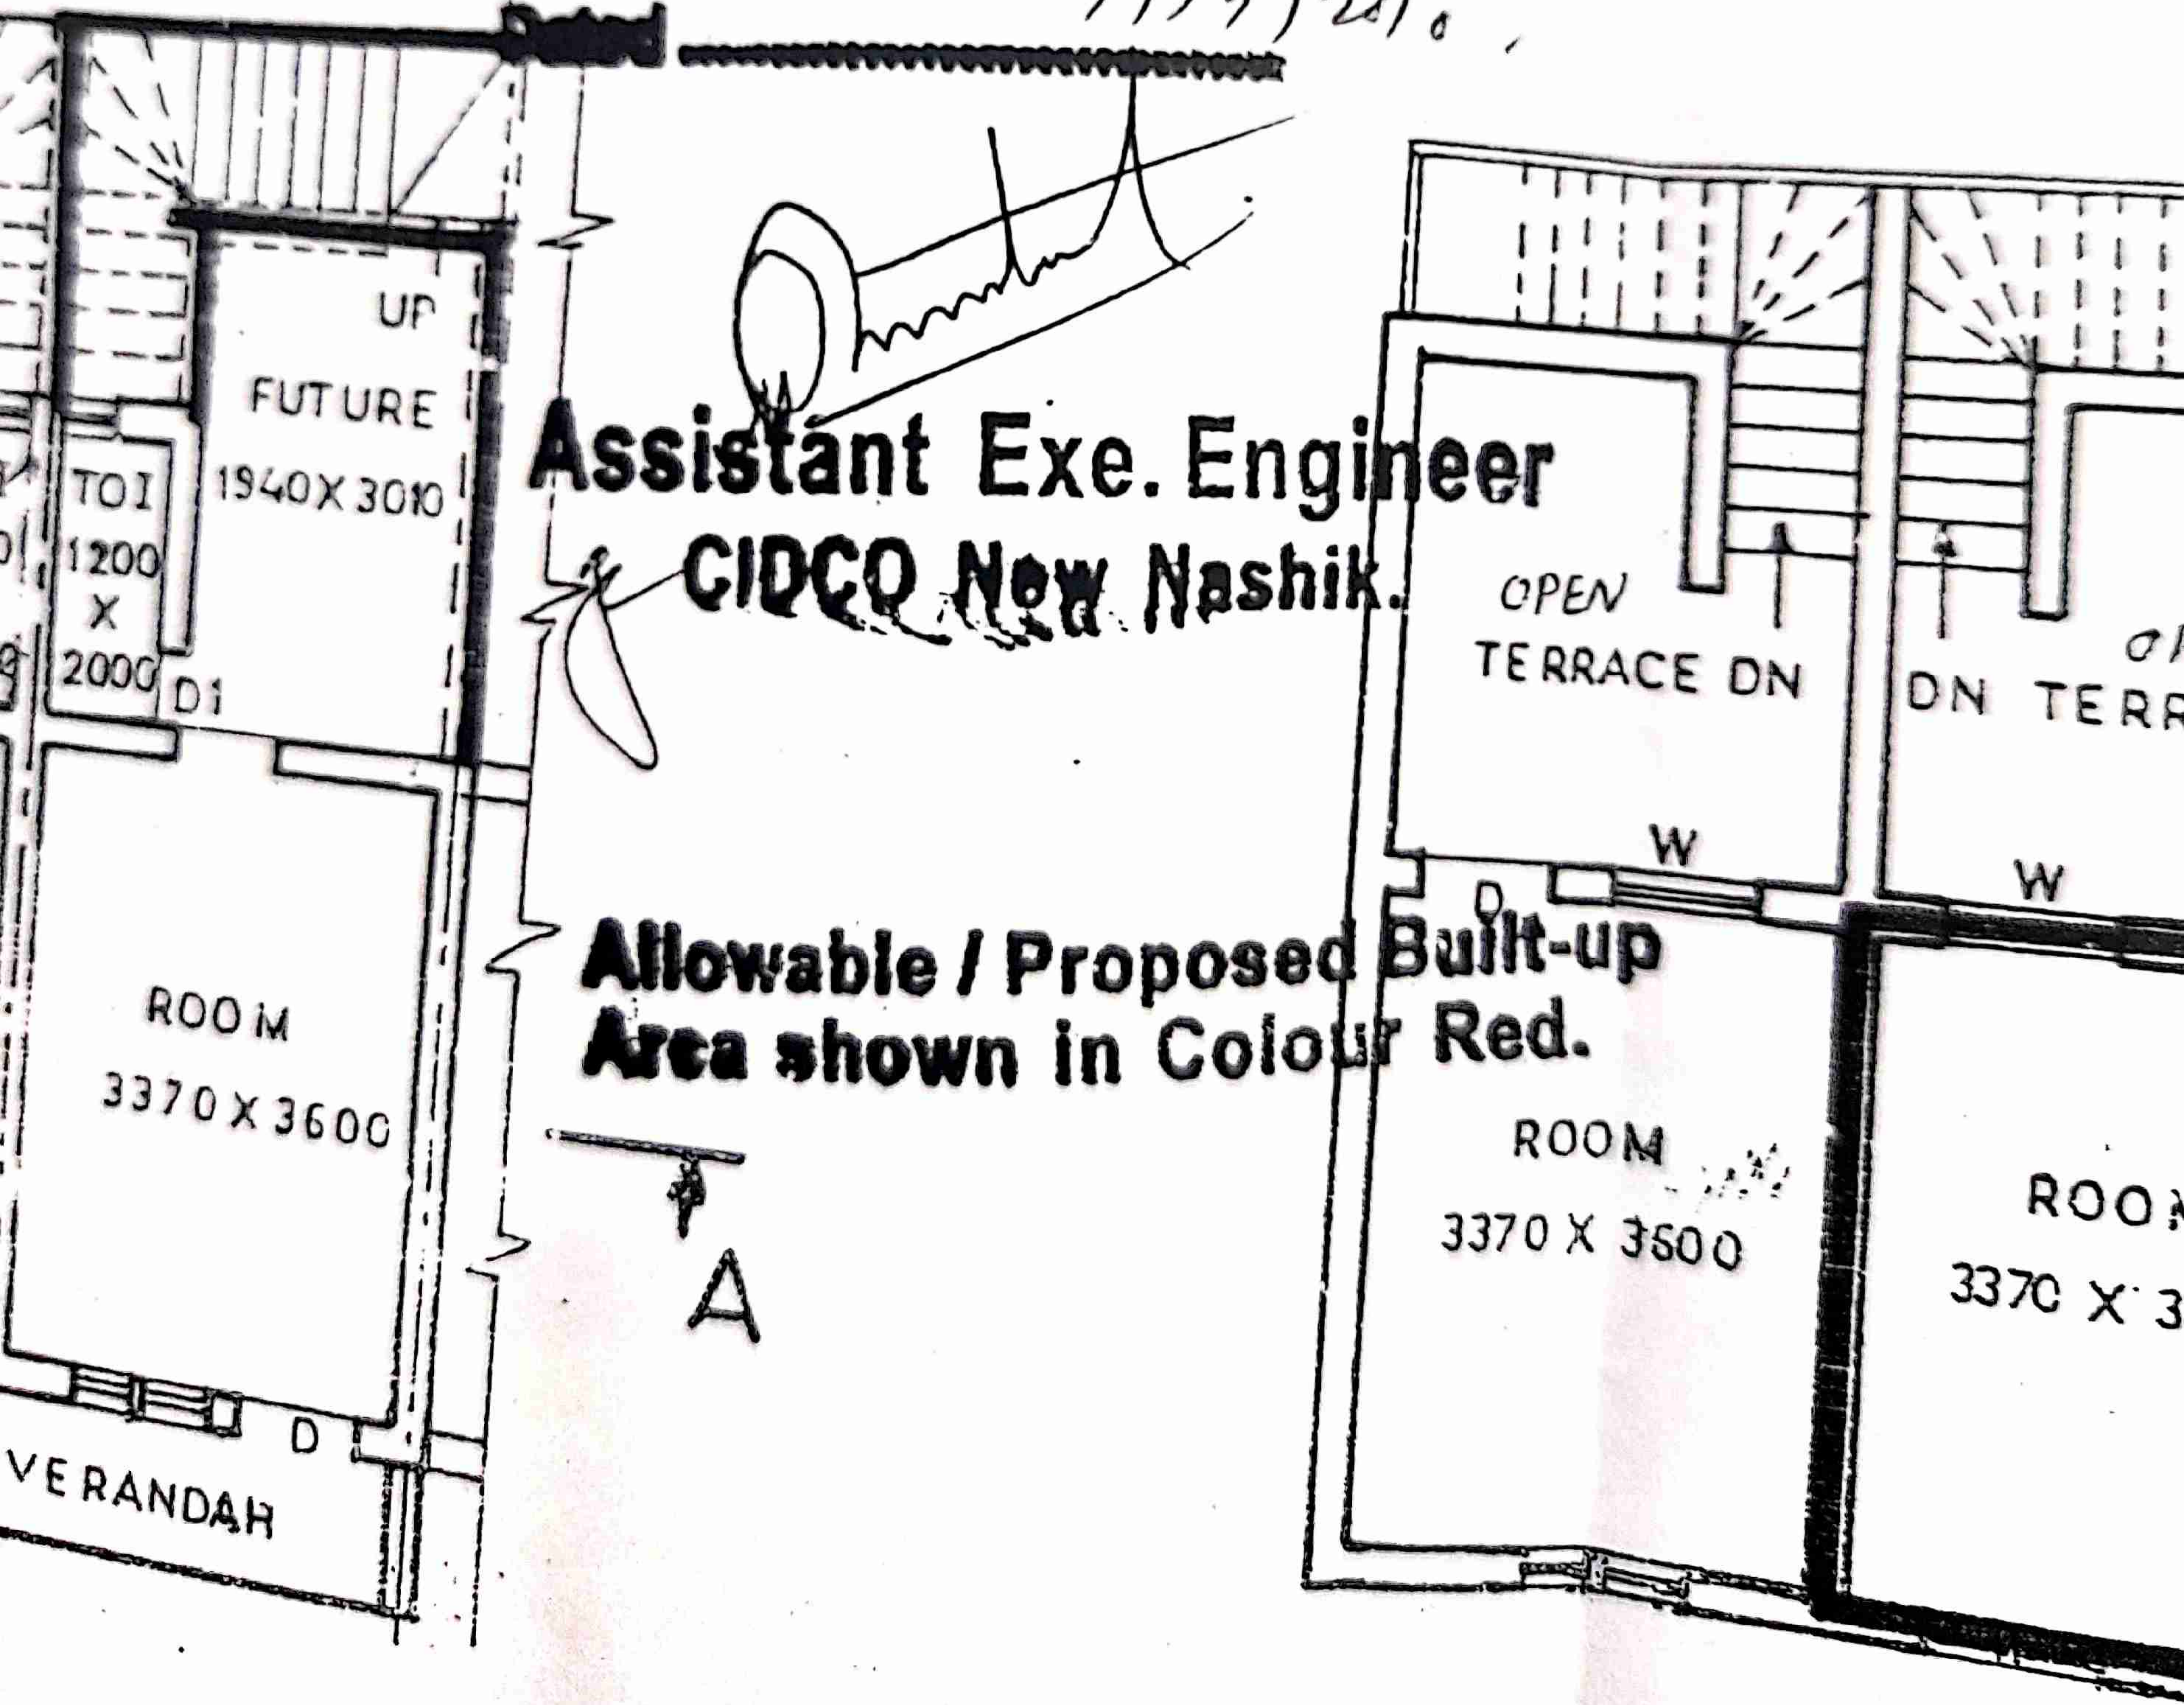


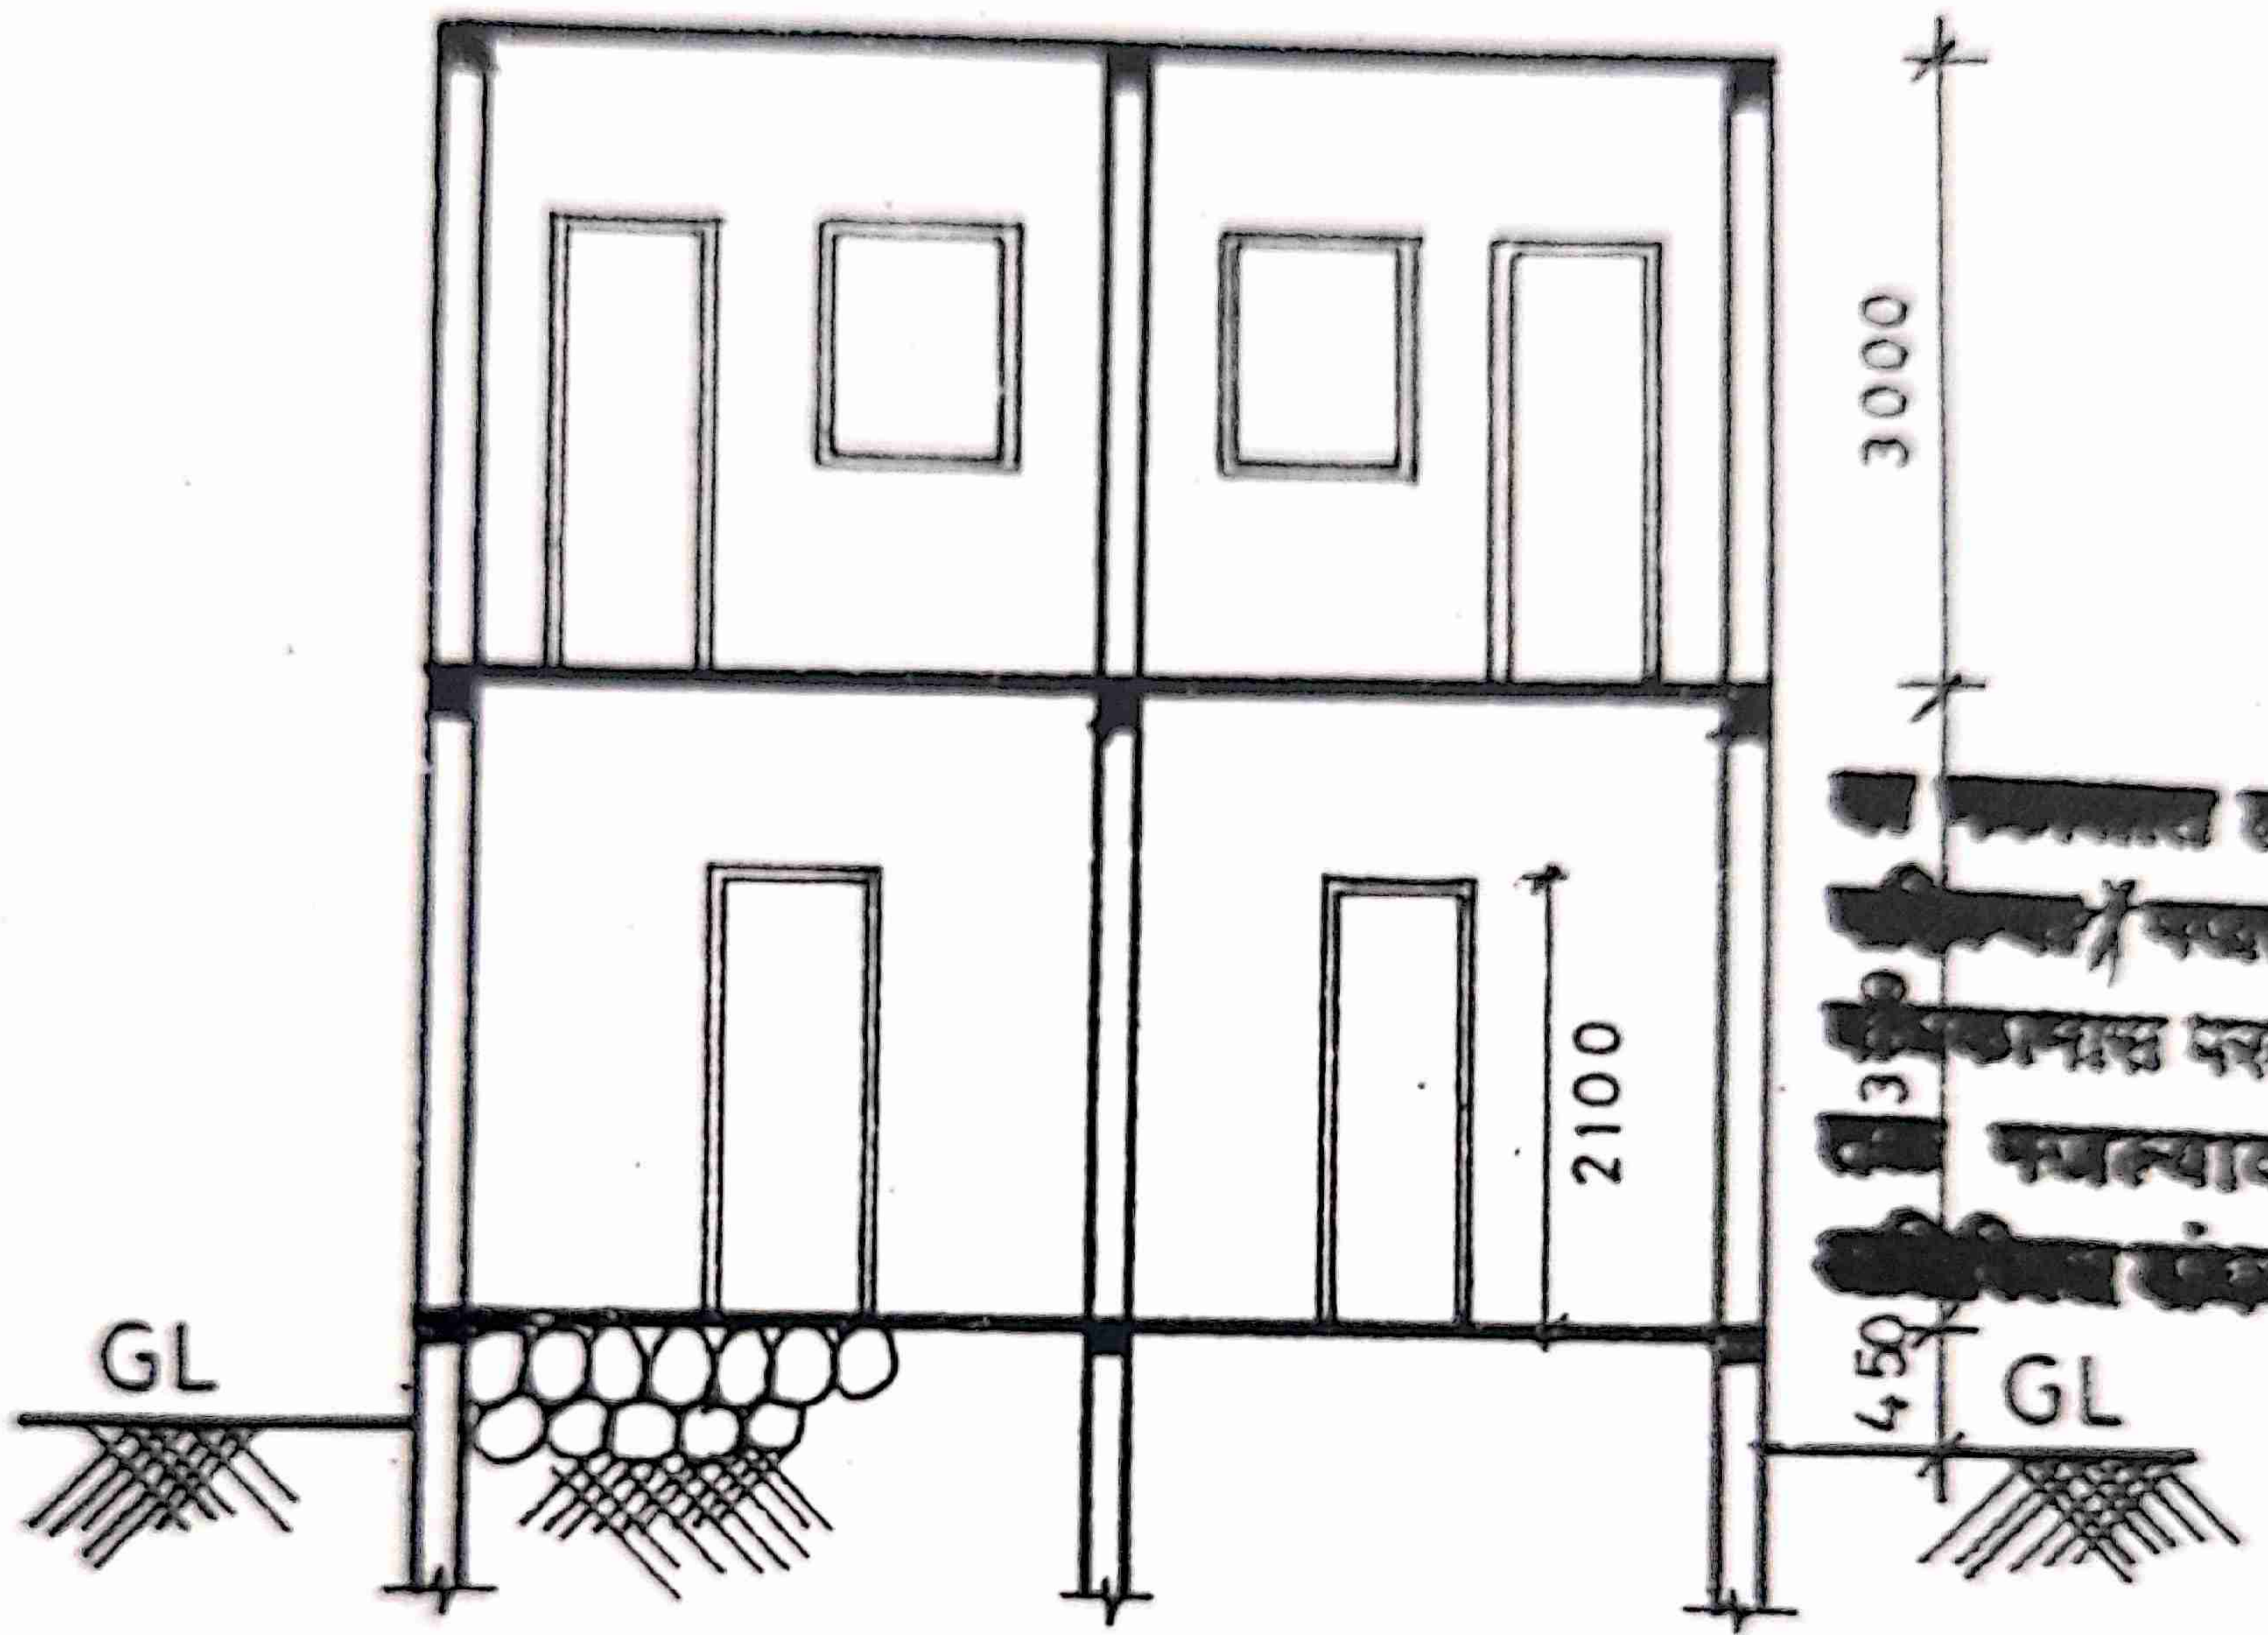

[Illegible text]
 [Illegible text]
SECTION AT A A

Approved as amended
 Subject to the
 this office letter
 2009/2010/172

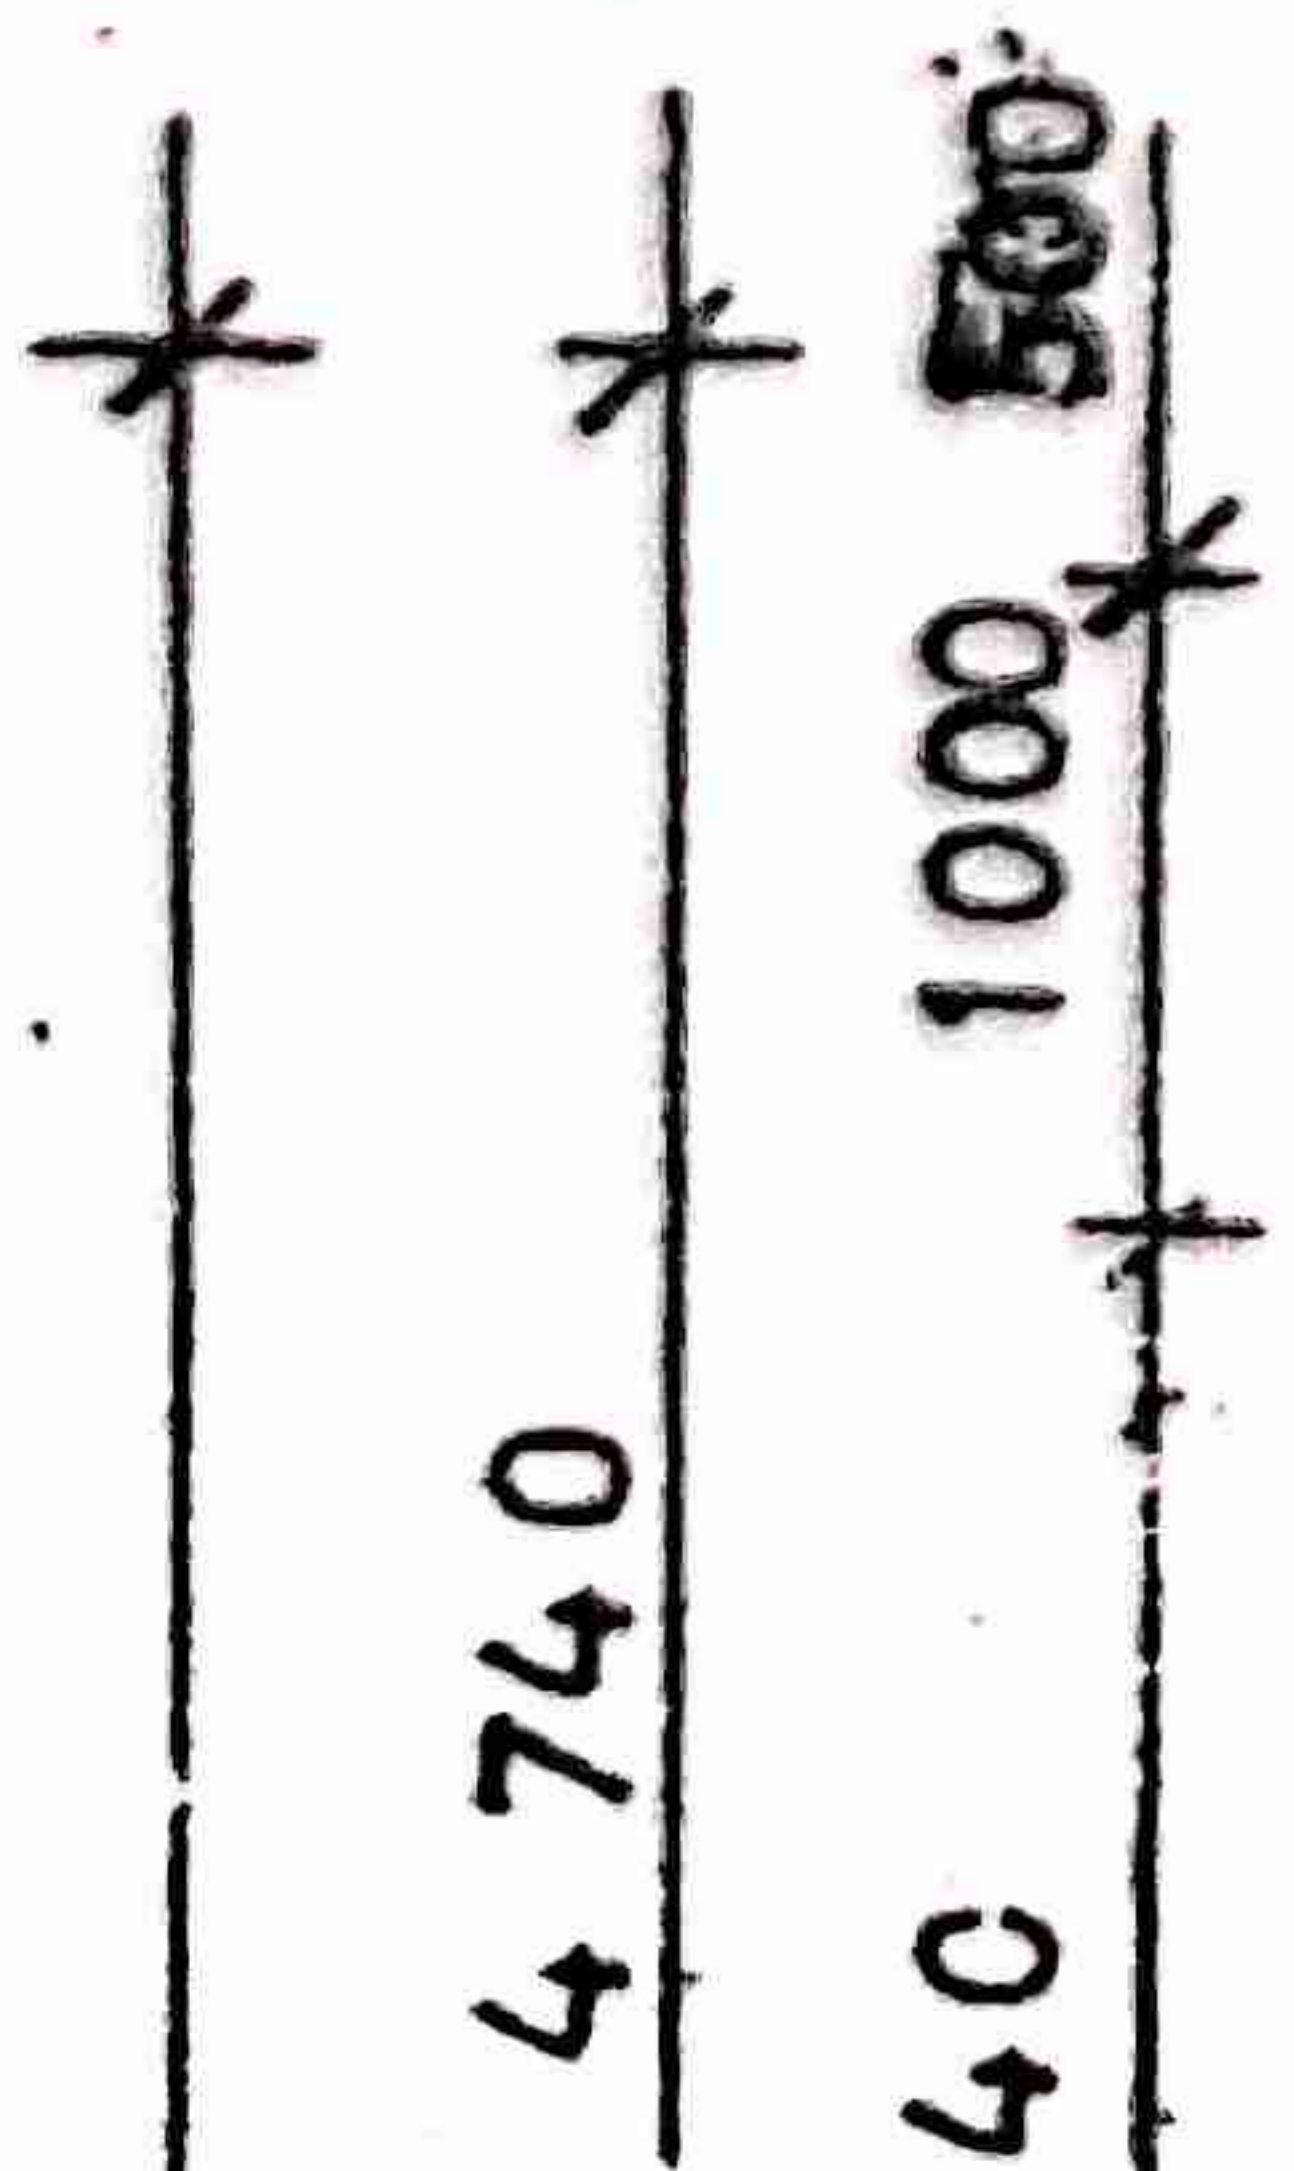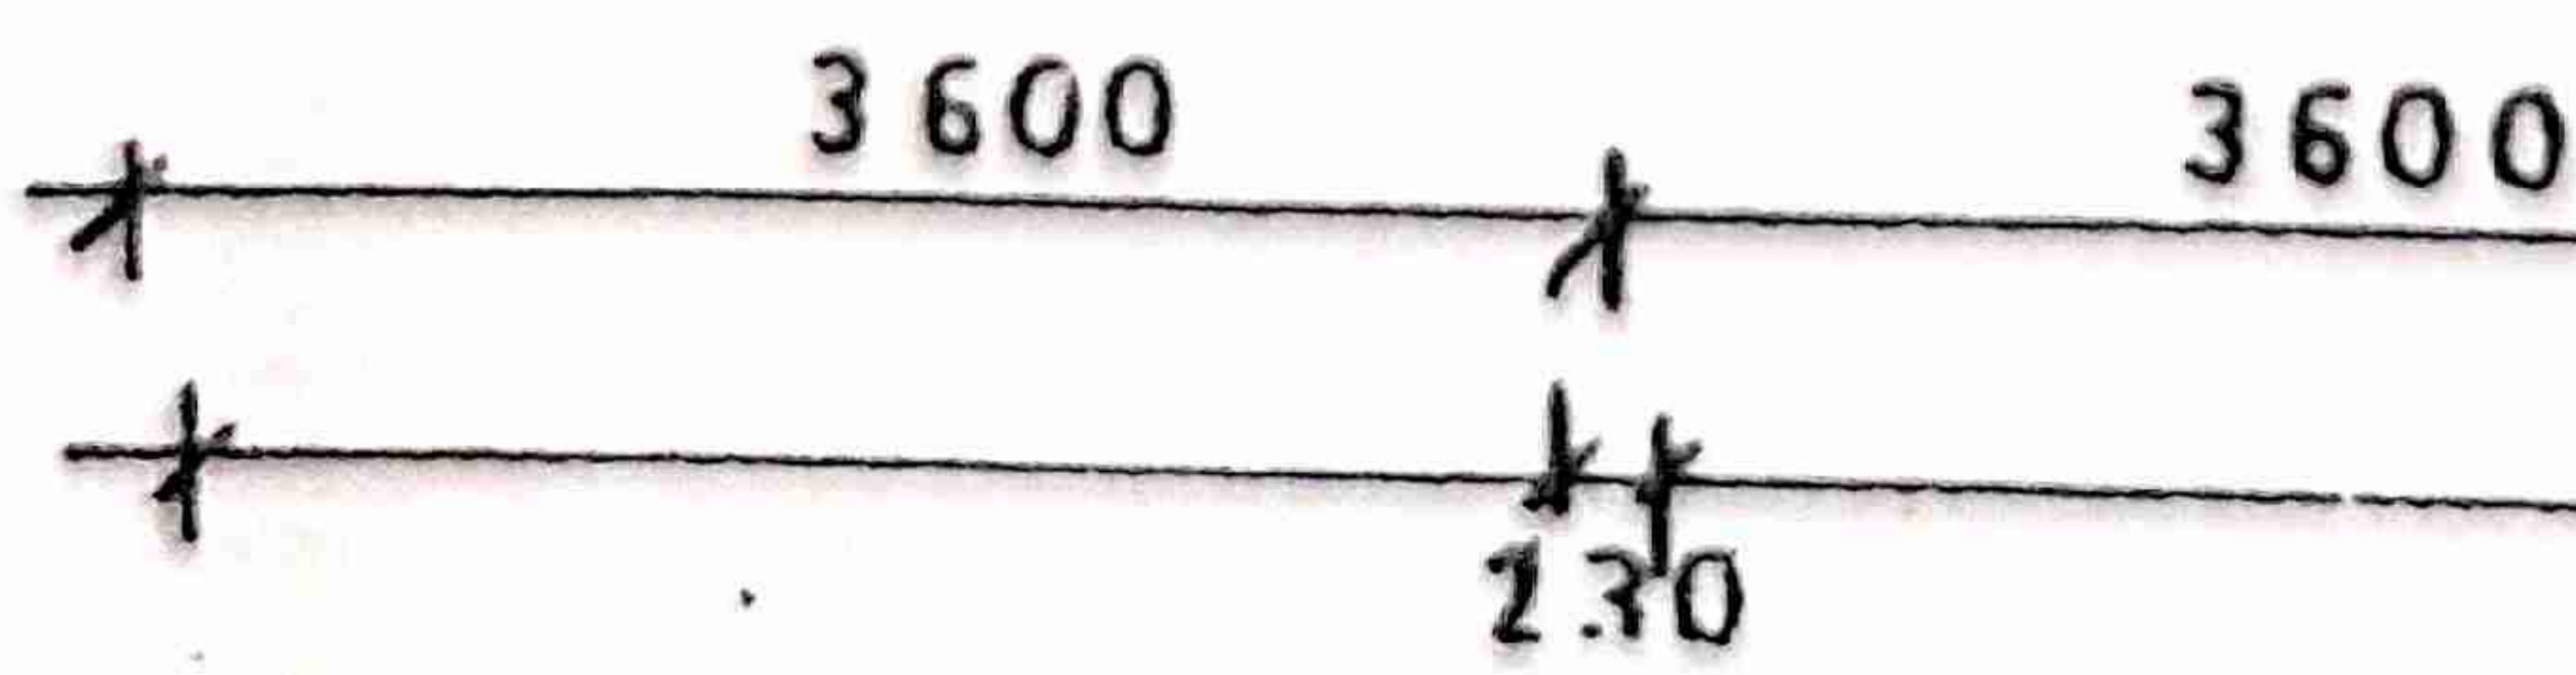

[Handwritten signature]
 [Illegible text]


SECTION AT A A

Approved as amended
Subject to the
this office letter
2009/2010/17


Dated

Assistant
CIDCO

Allowable
Area show

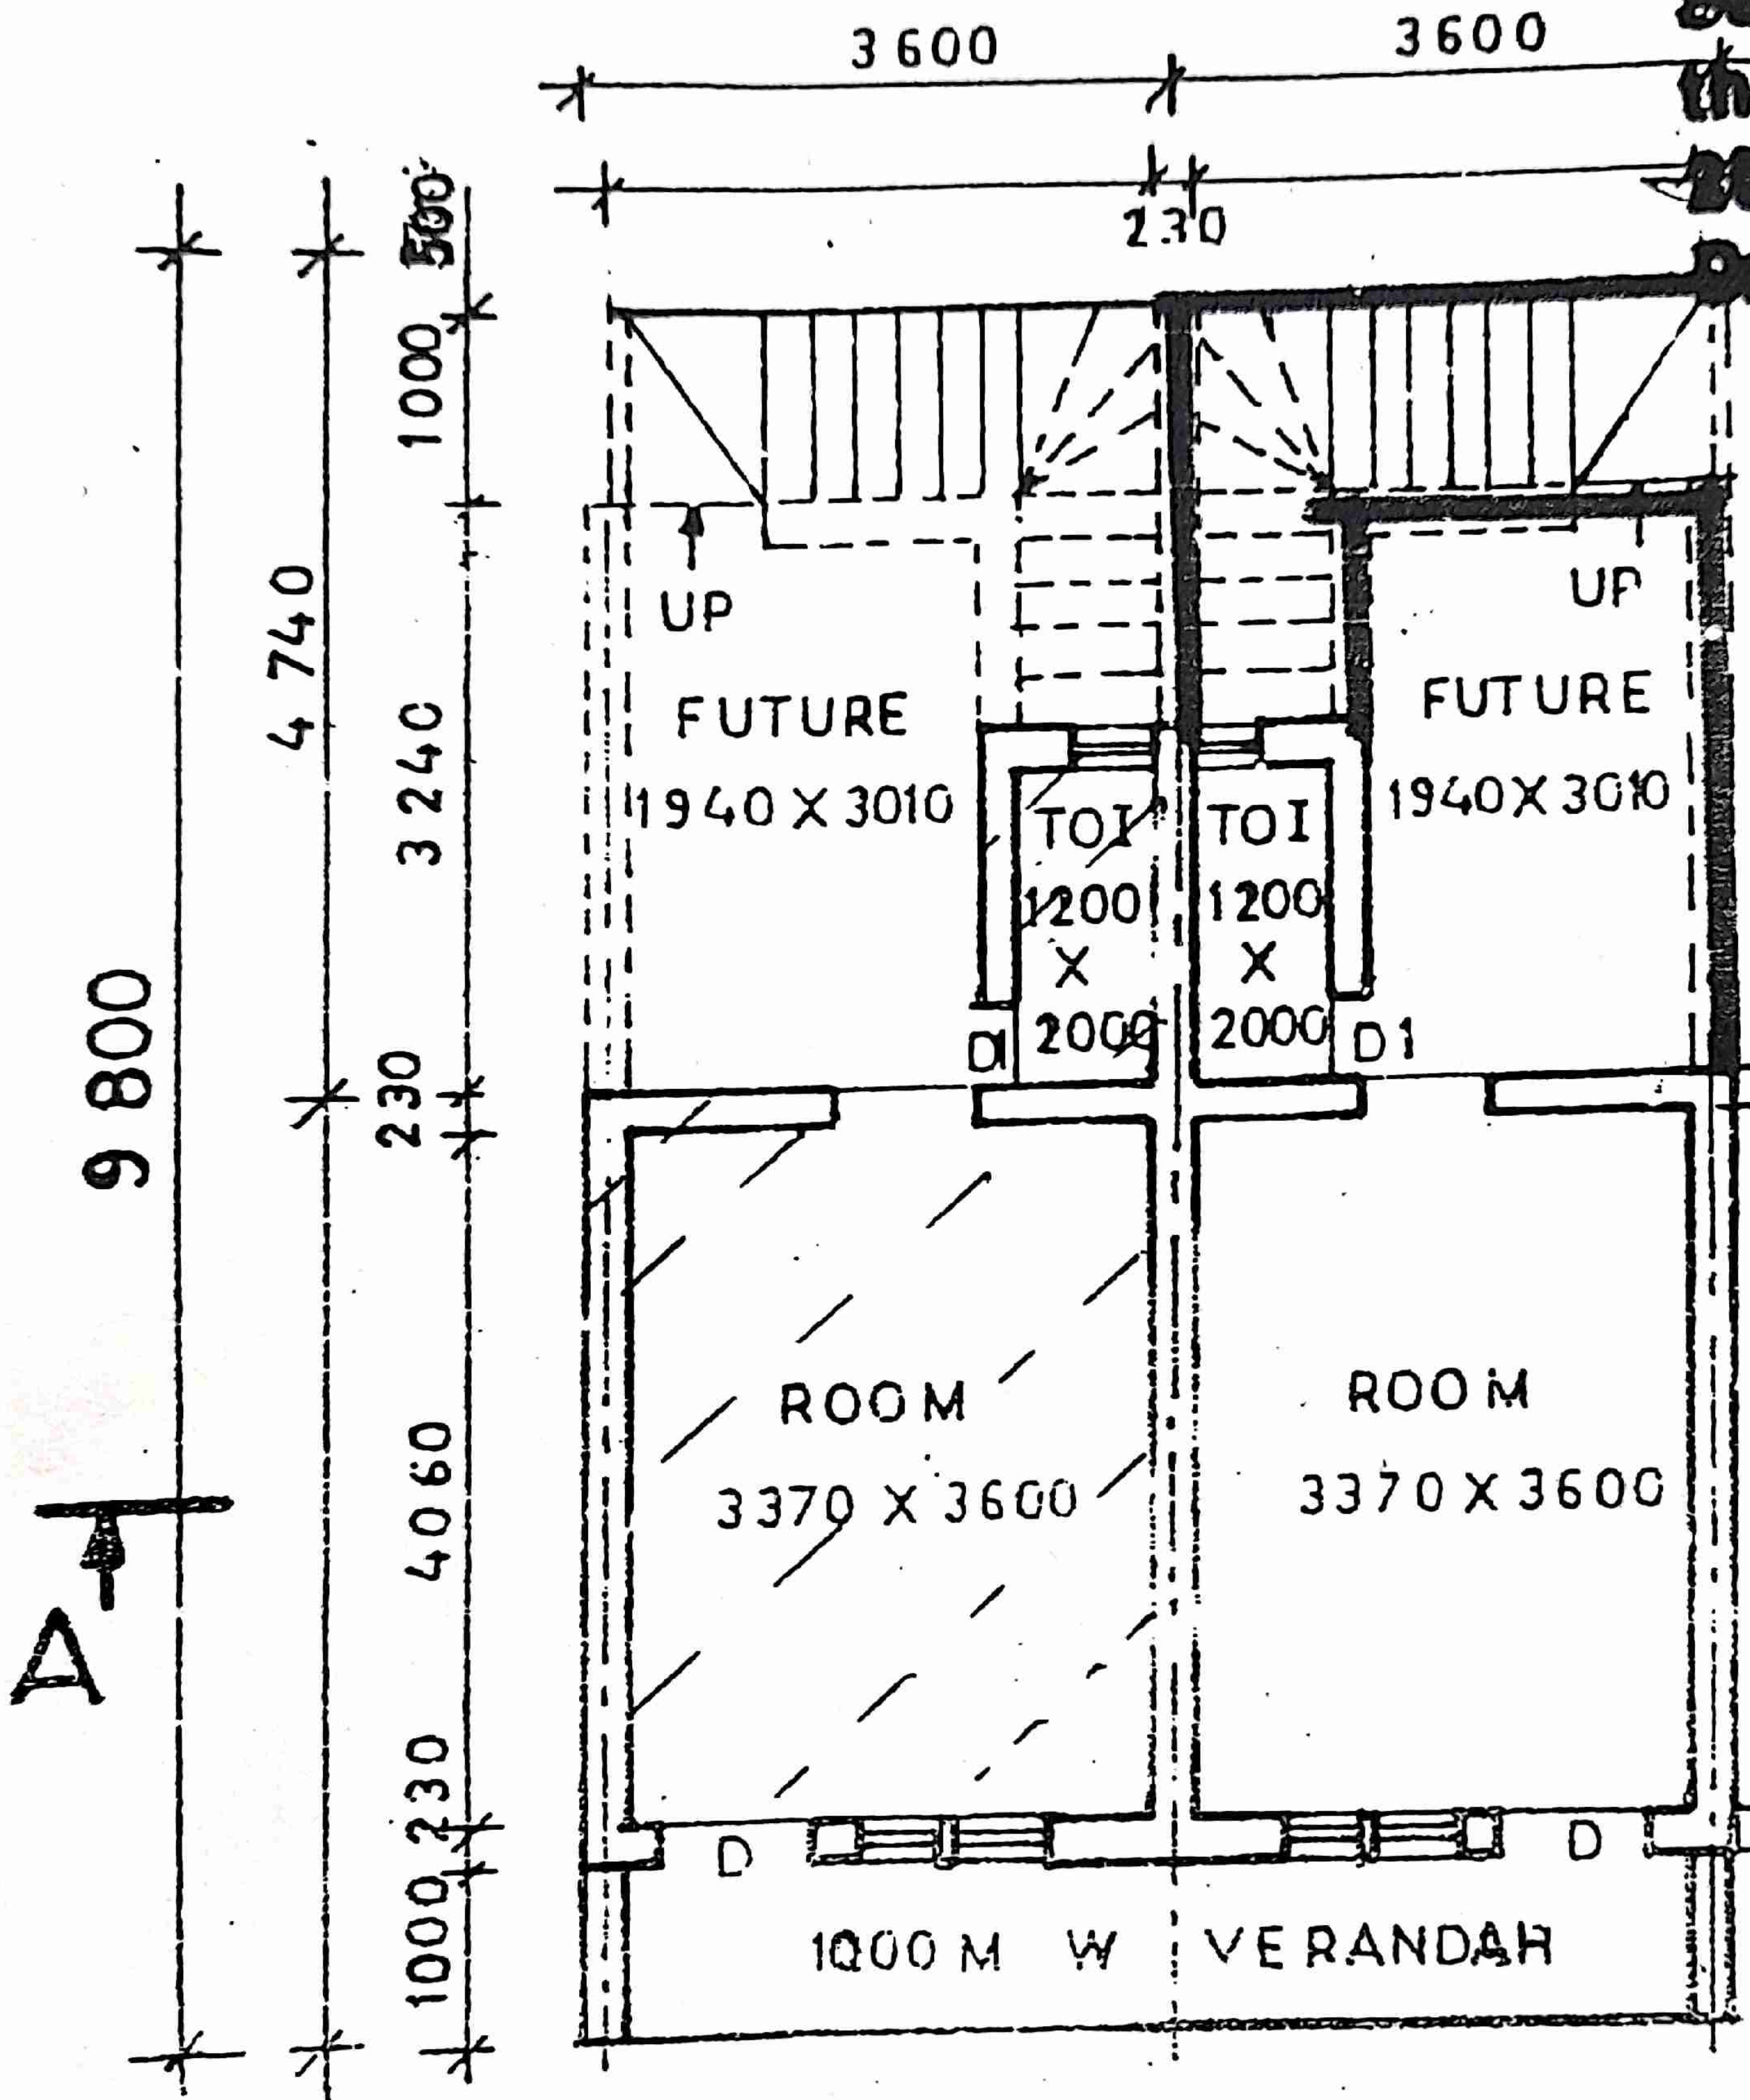

GROUND FLOOR PLAN

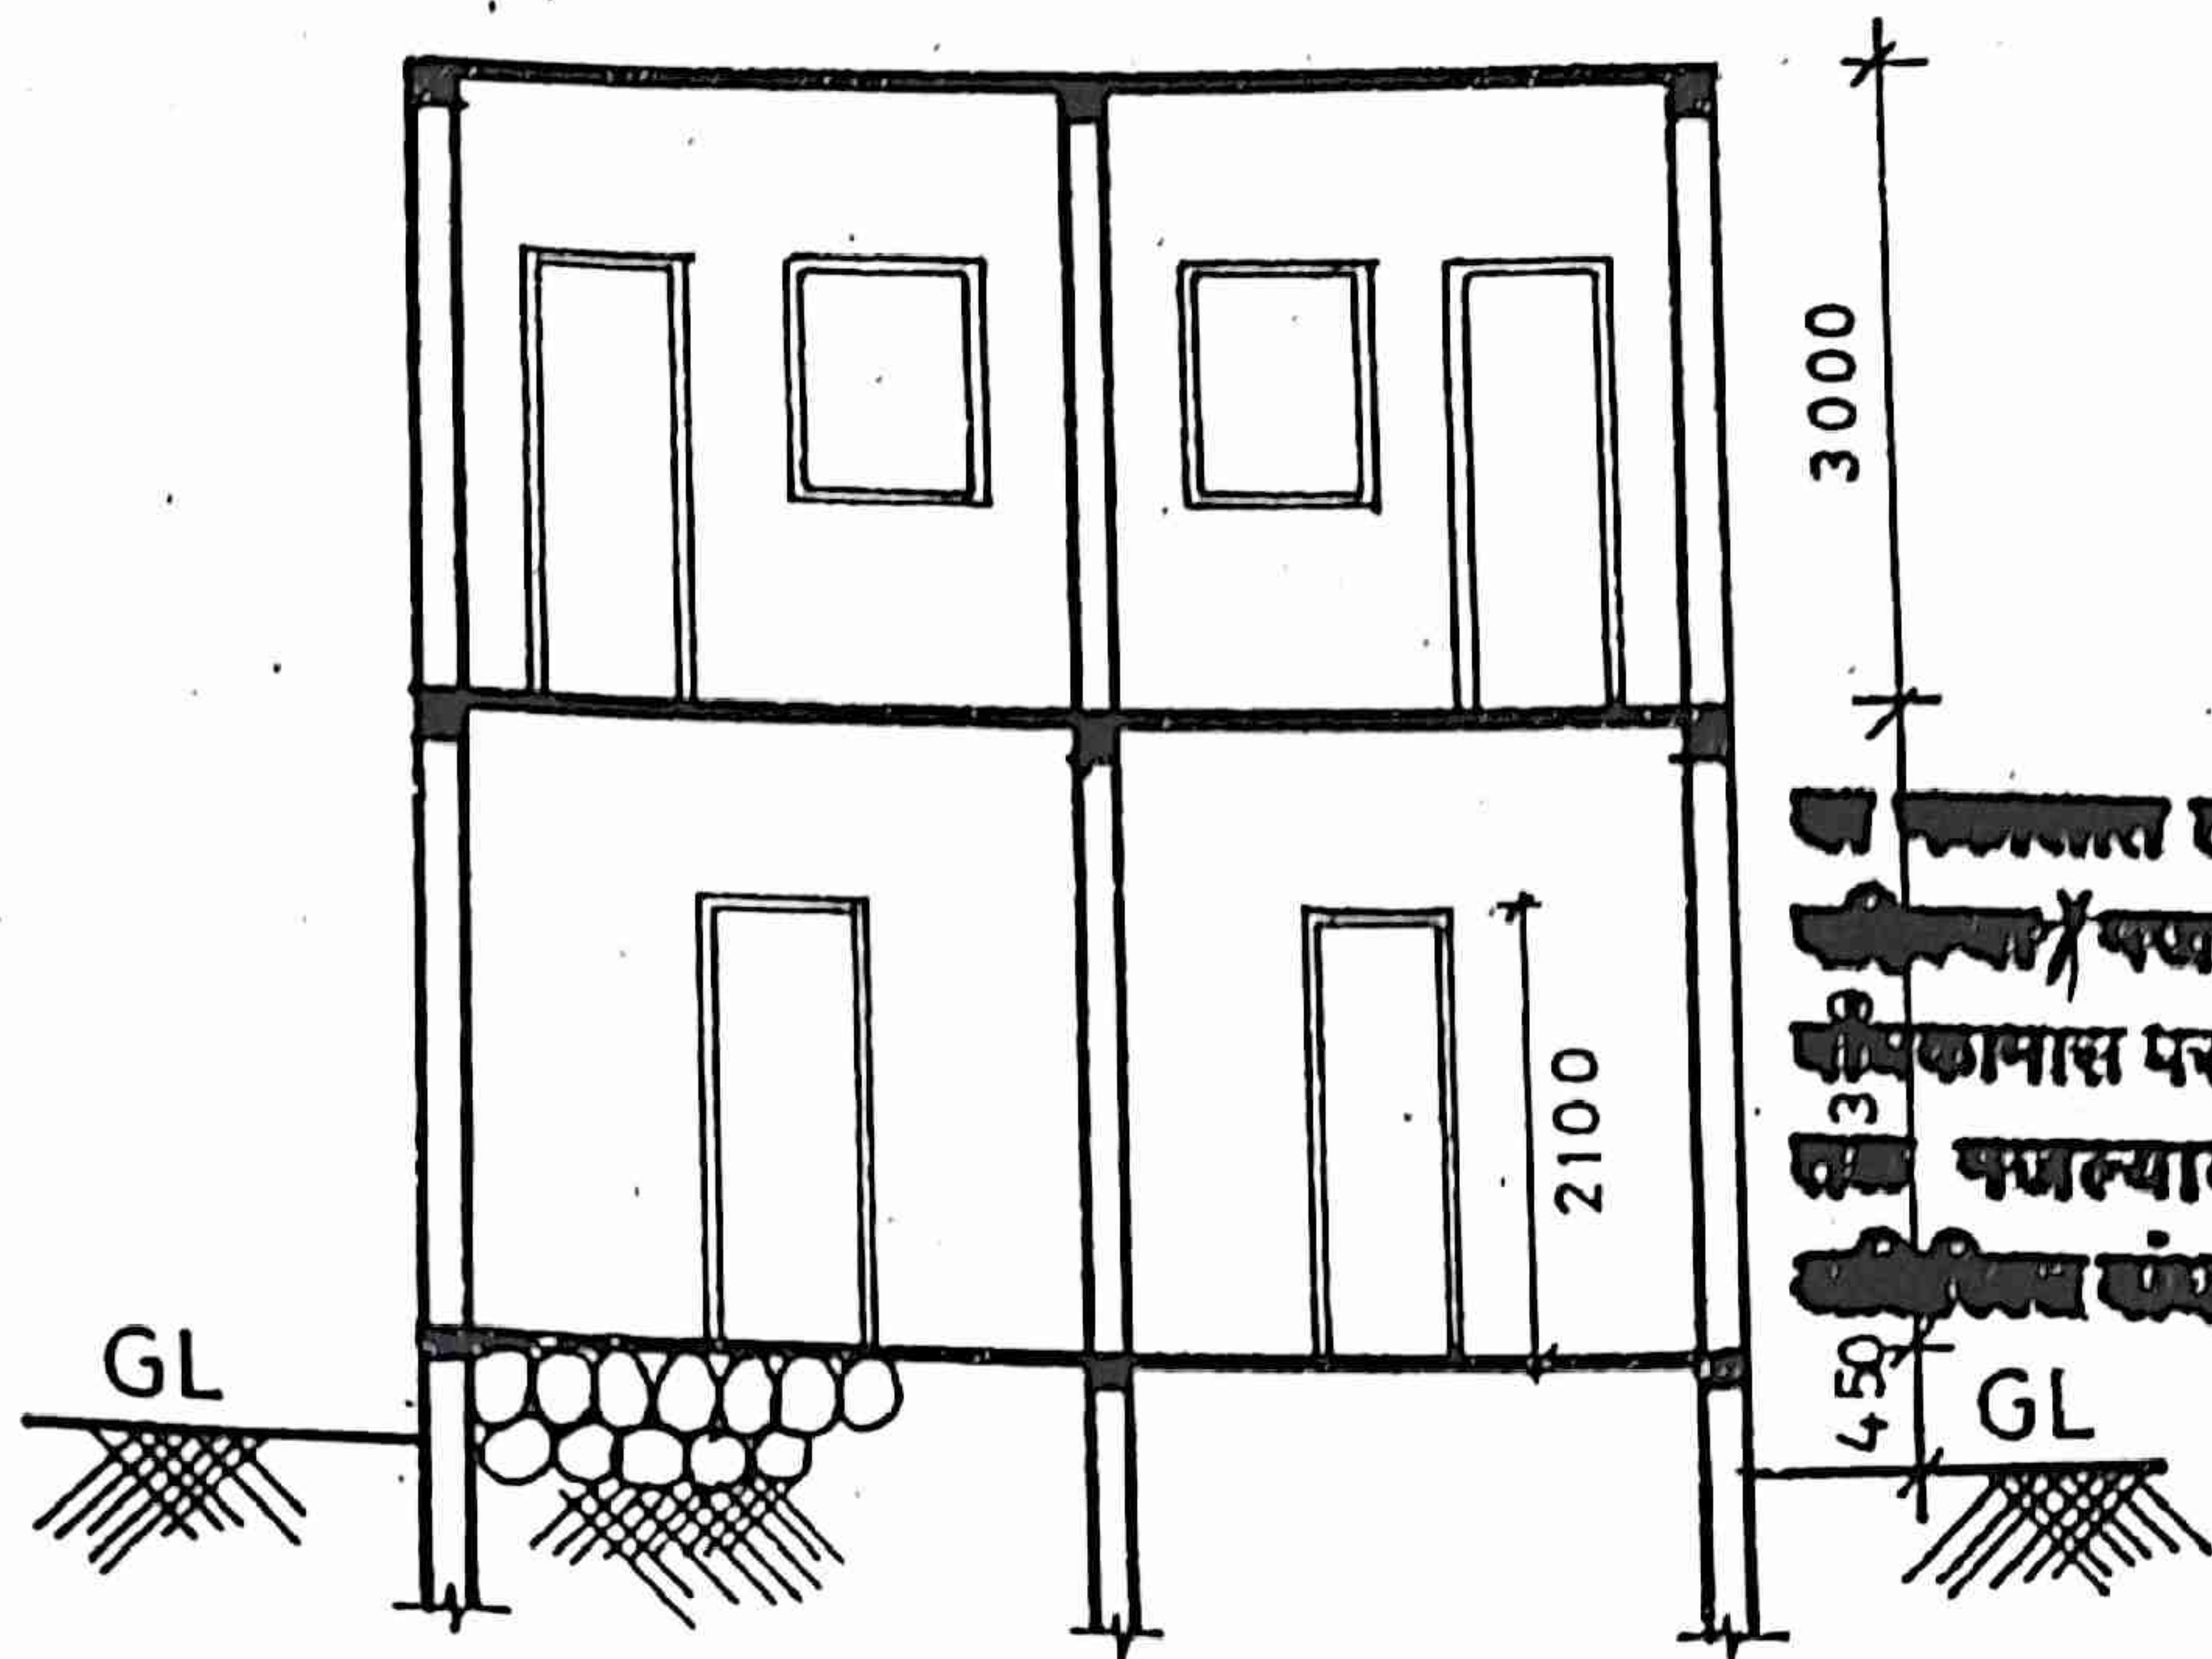

SECTION AT A A

- 1) PLOT AREA UND
- 2) SCHEME BUILT UP
- 3) FUTURE EXTENSION (G.
- 4) FIRST FLOOR B (UP


का पत्रात लाल रंगाने दर्शविलेले तसेच पहिल्या/पहिल्याचे केवळ २६.६६...
 बांधकामास परवानगी देण्यात येत आहे. या...
 तसेच पहिल्यावर / पहिल्या मजल्यावर...
 बांधकामास परवानगी देण्यात येत आहे.

5) STAIR CASE AREA
 F F & STAIR C

NAME OF TENEMENT HOLD

TENEMENT NO. 7 N-32


Approved as amended in Red.
 Subject to the conditions mentioned in
 this office letter no. BPINT/NSK/ADM/
 2009/2010/172/19/3/2010

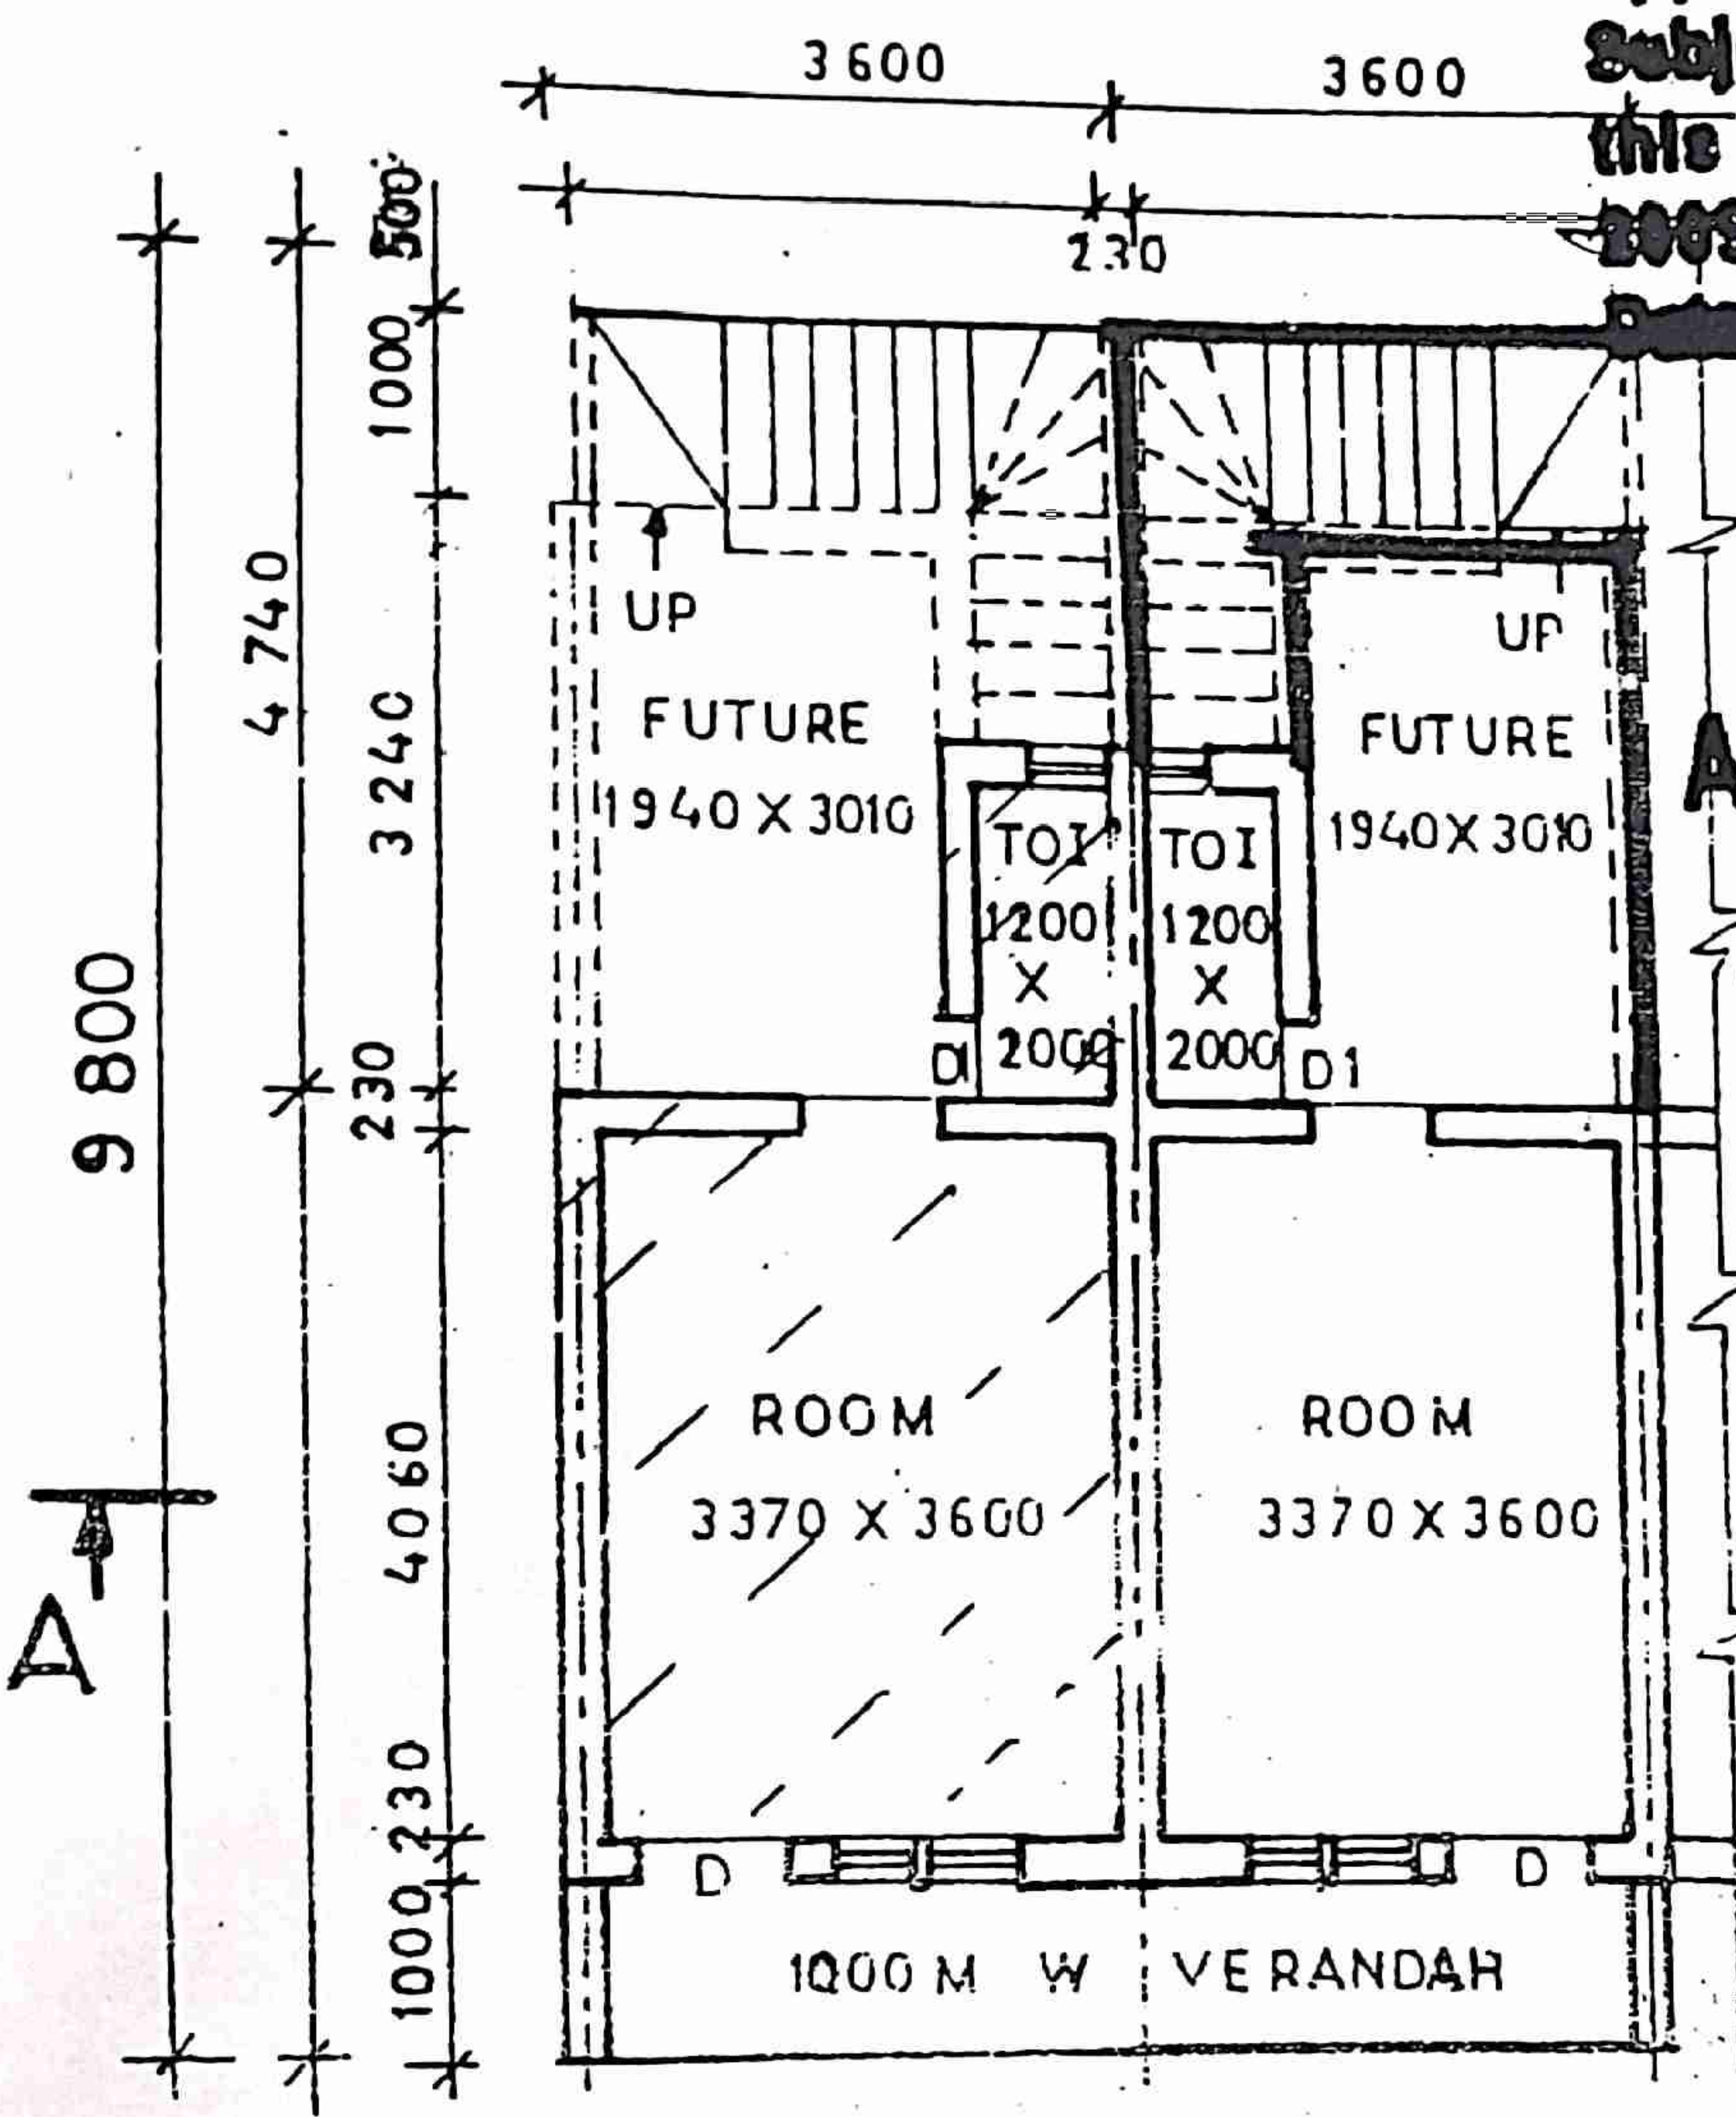

GROUND FLOOR PLAN

Assistant Exe. Engineer
CIDCO New Nashik.

Allowable / Proposed Built-up Area shown in Colour Red.

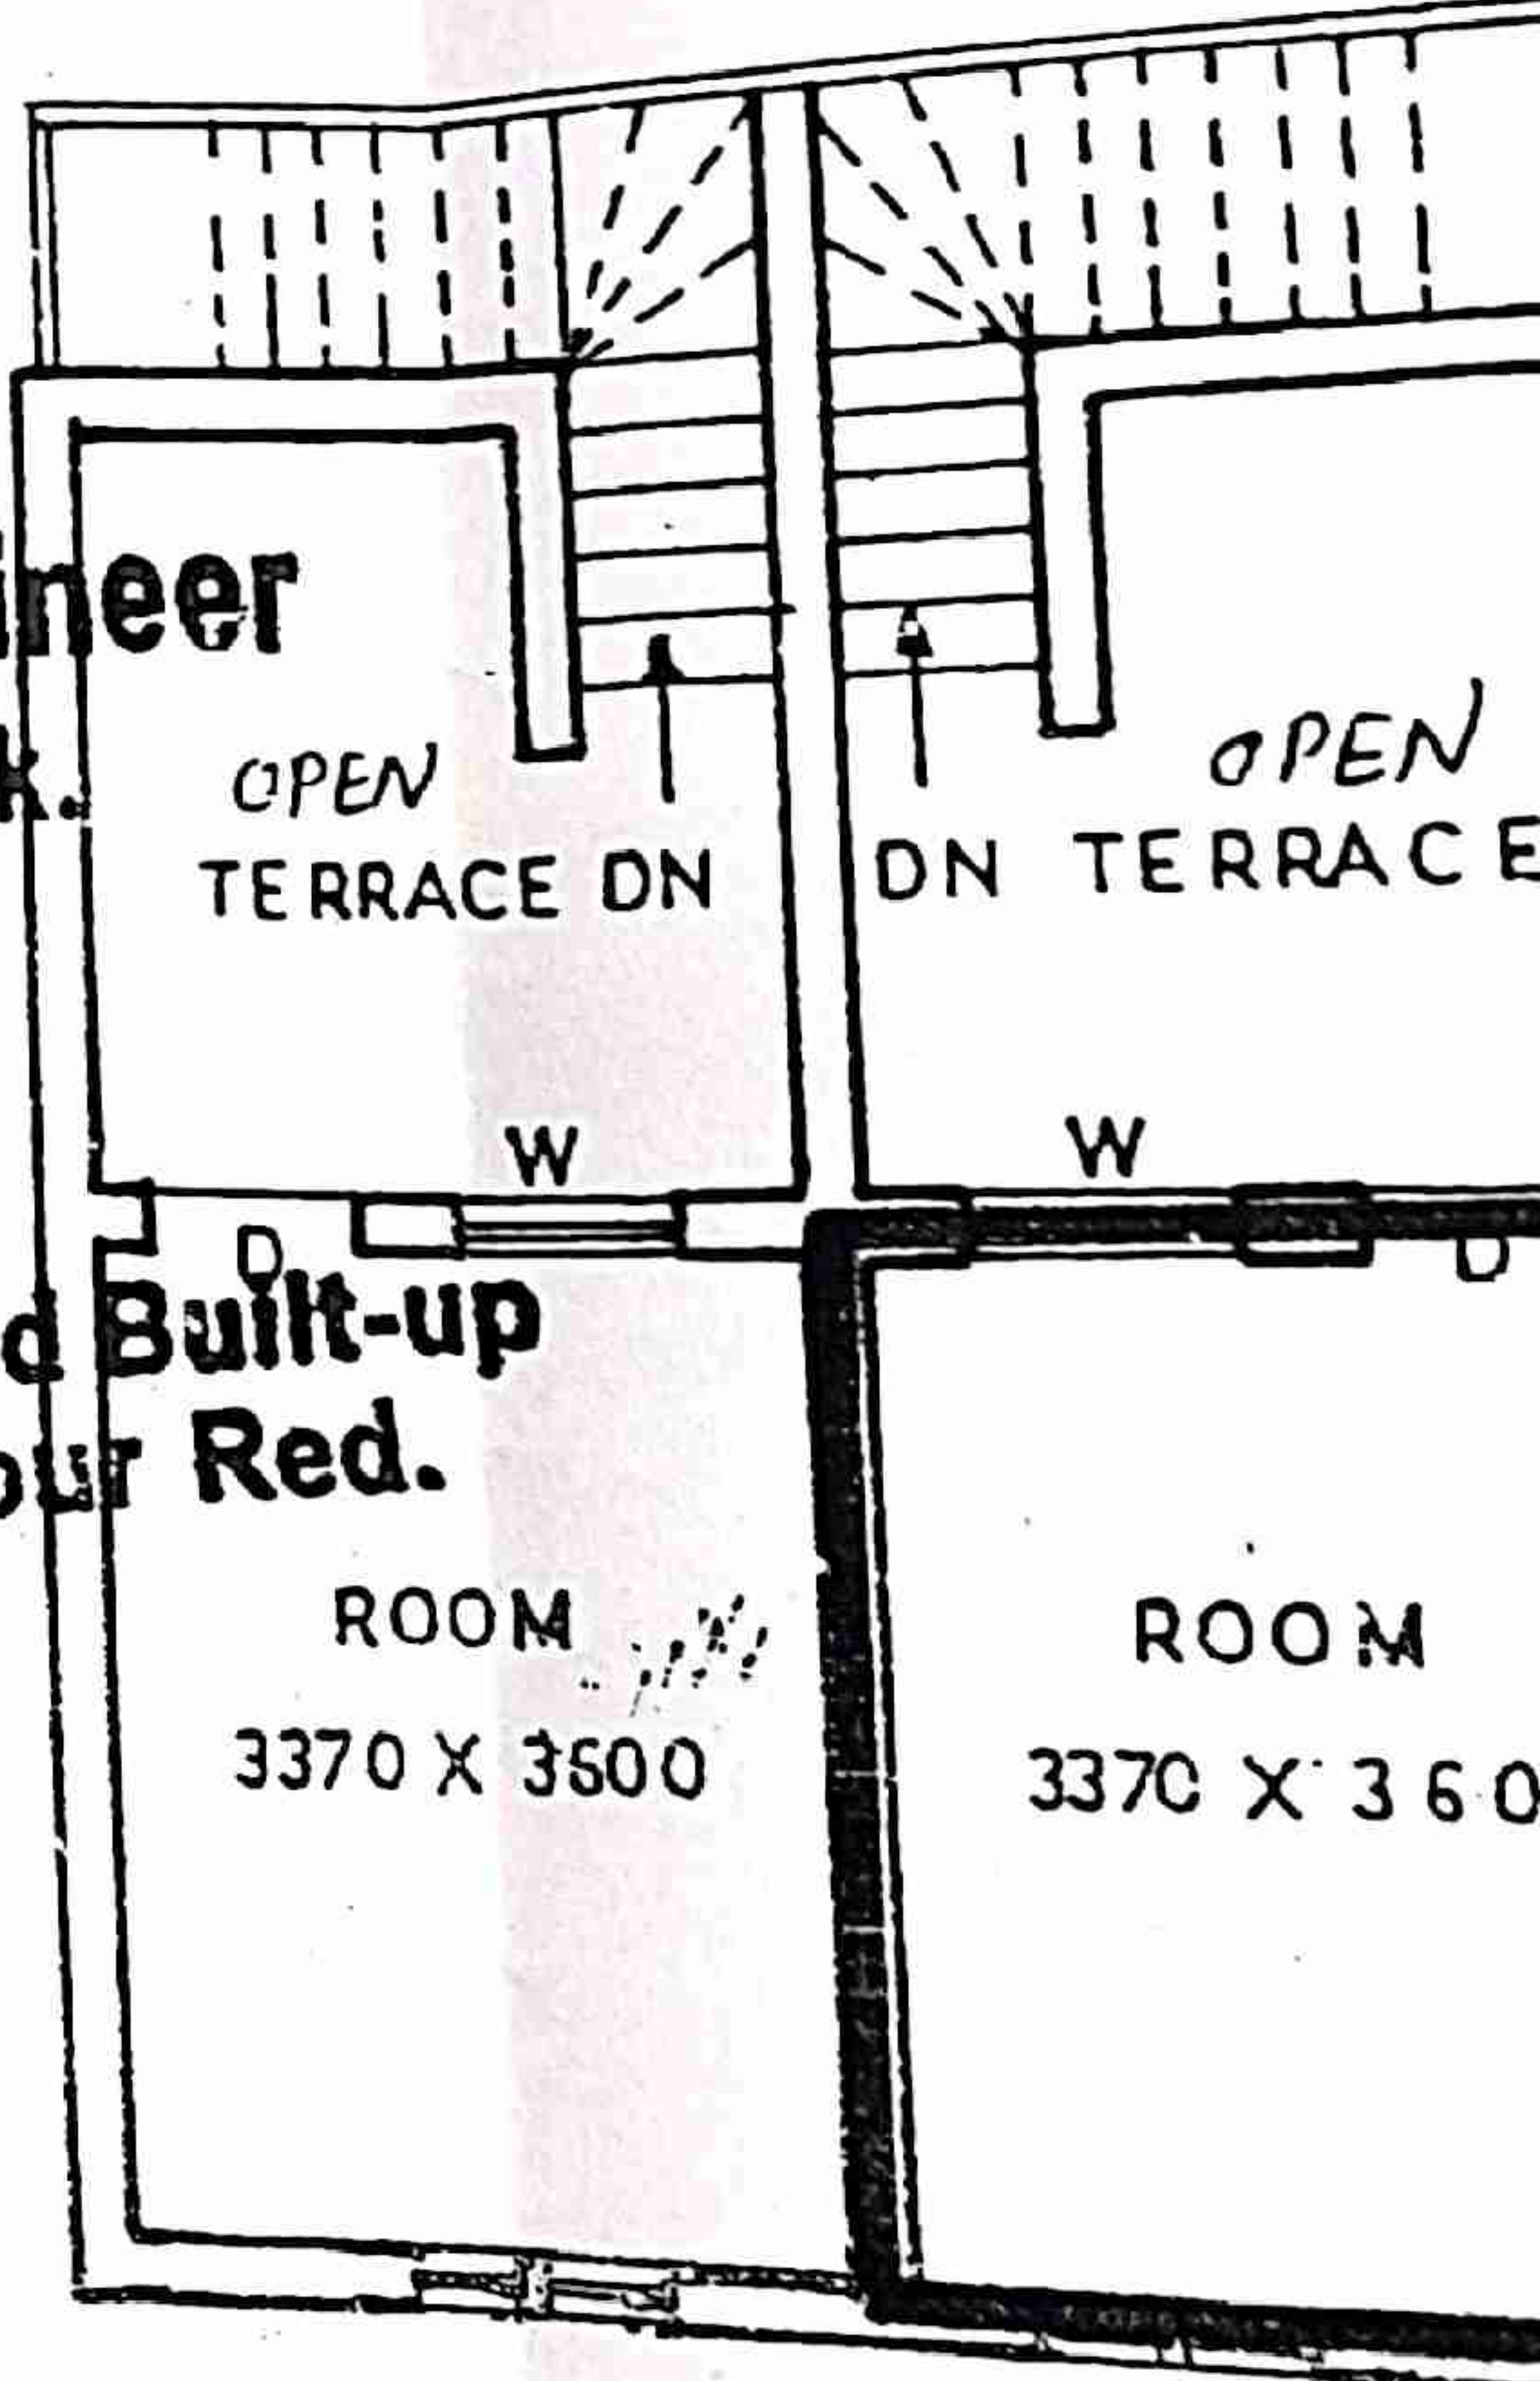

FIRST FLOOR

- NOTE
- ① Existing work which was already constructed by CIDCO is shown in Hatched lines.
 - ② Gr. Floor allowable / existing extension work shown in Pink.
 - ③ Proposed construction work shown in Red.


as amended in Red. TENEMENT

the ... ions mentioned in
letter no. BPINT/NSK/ADM/

01/172 1973/2010

ant Exe. Engineer
CO New Nashik.

able / Proposed Built-up
shown in Colour Red.

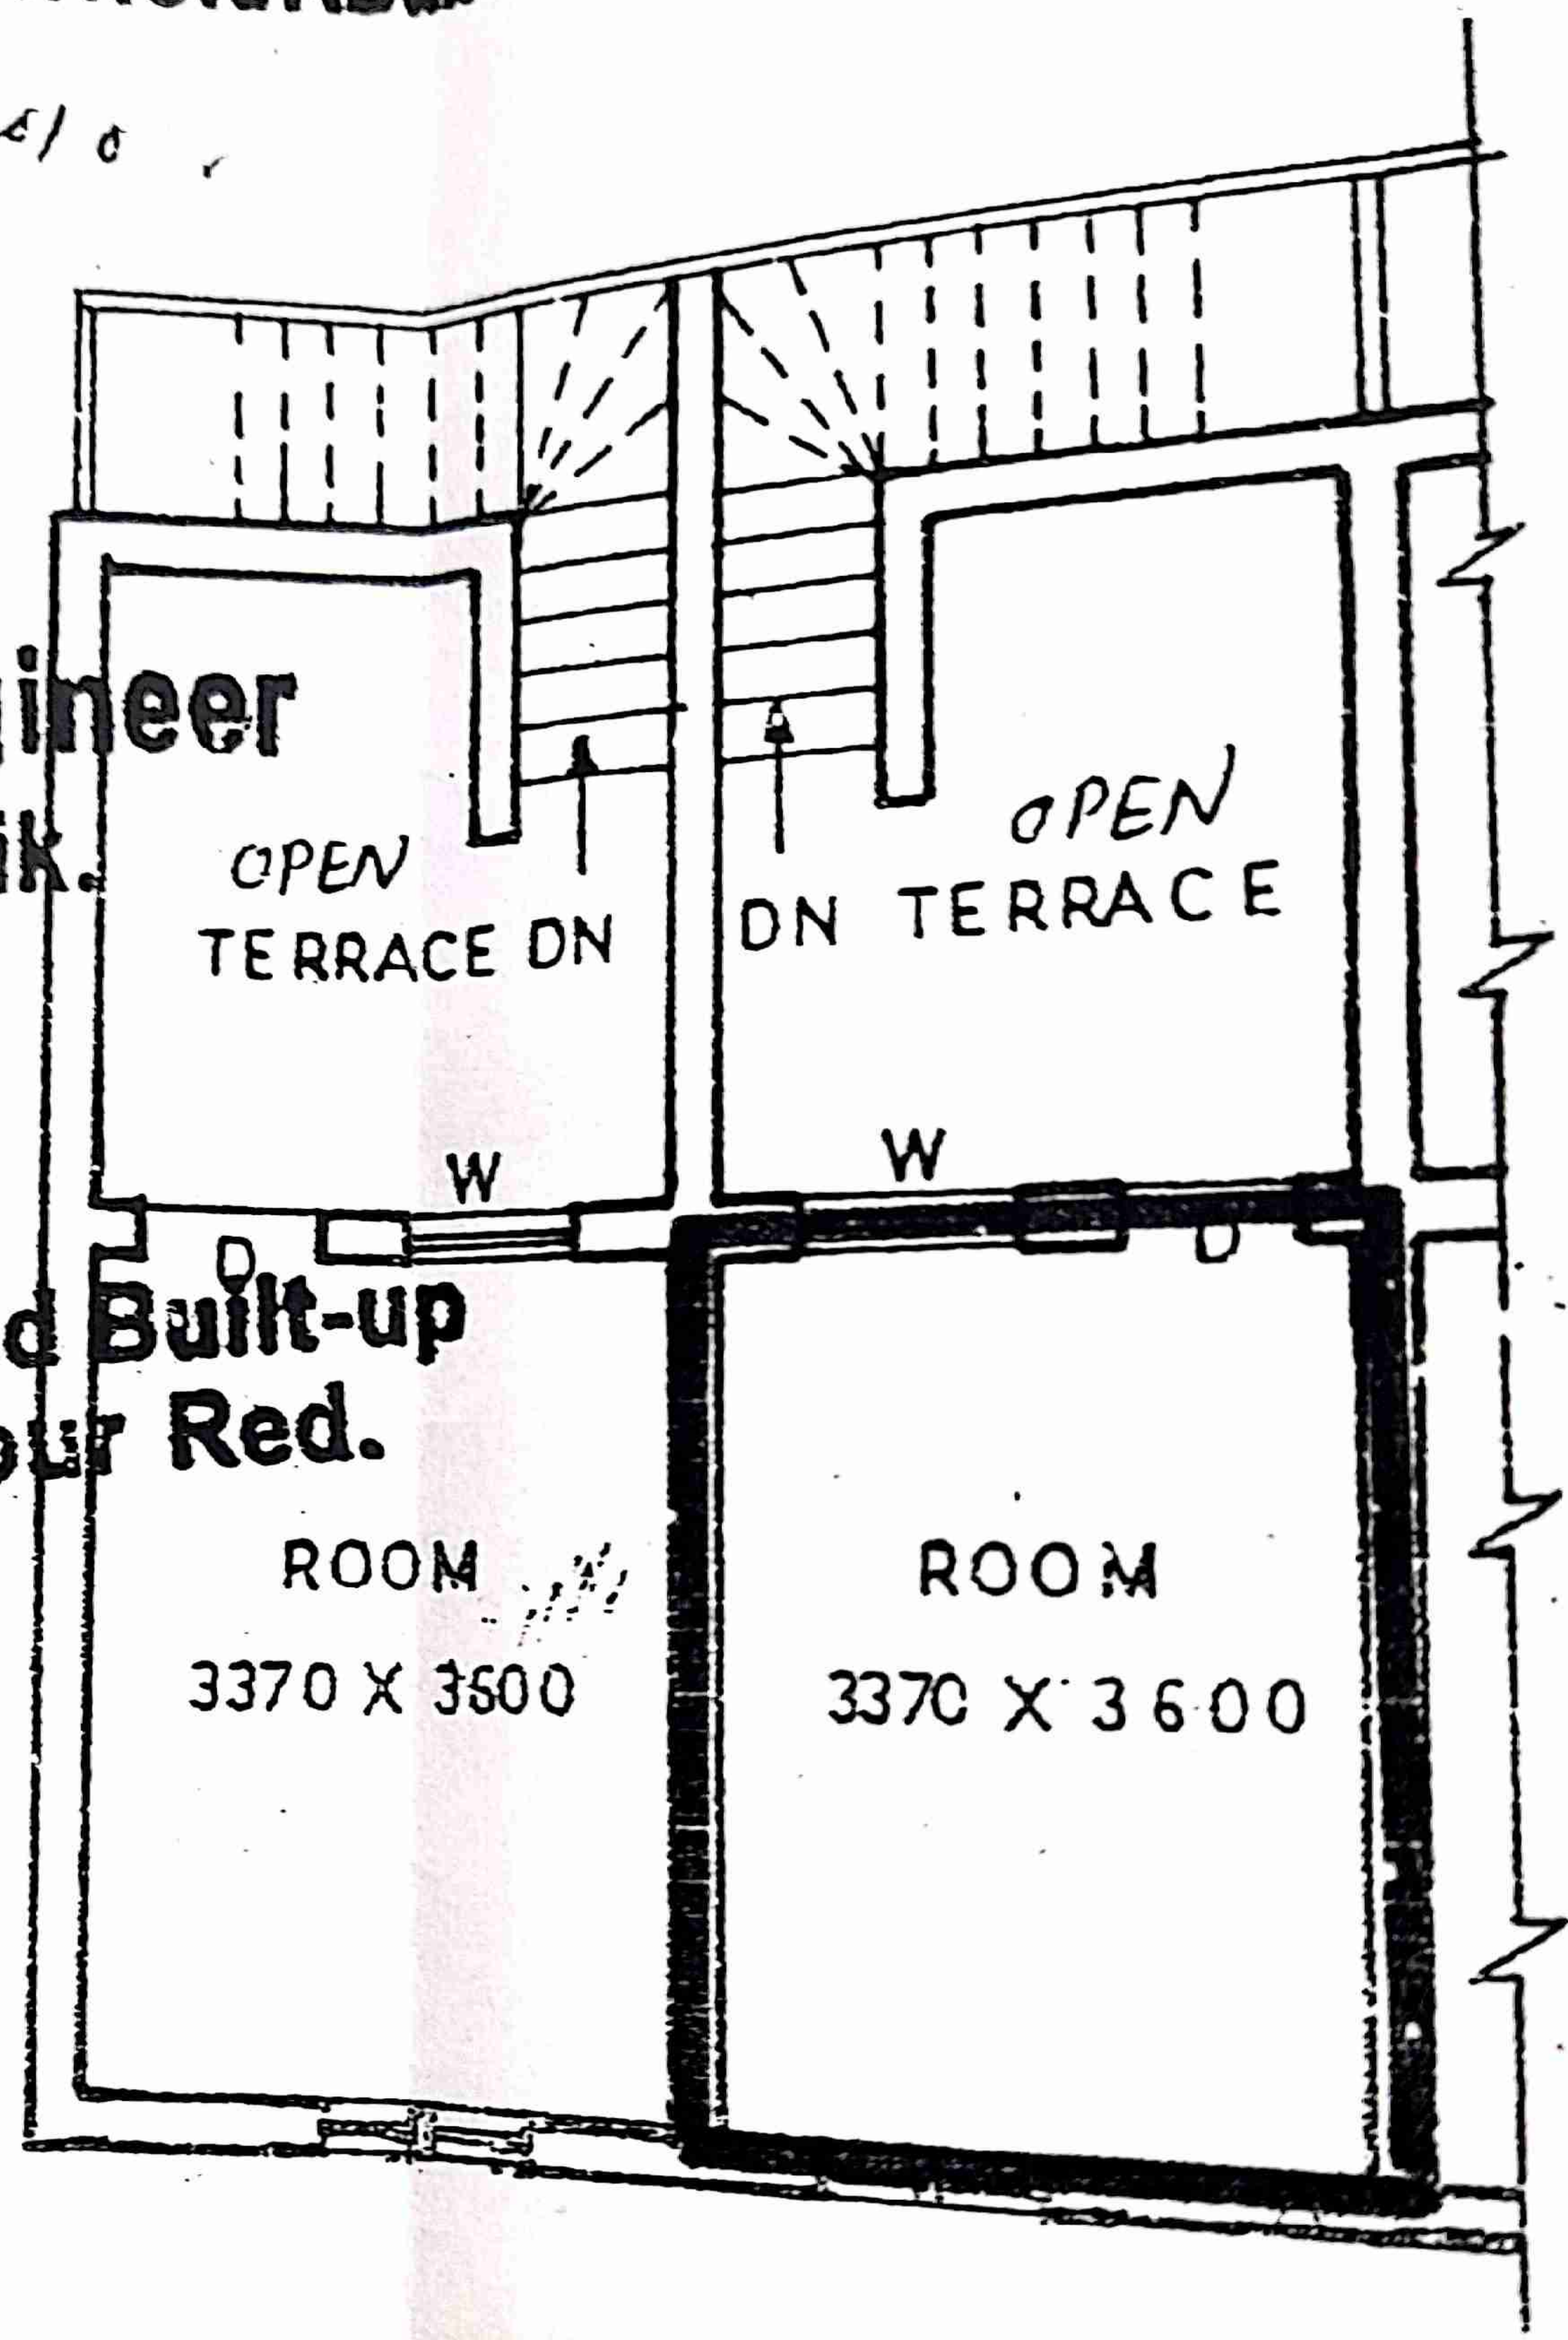

FIRST FLOOR PLAN

constructed by

&


- 1) PLOT AREA UND → 35.28 M² (Approx)
- 2) SCHEME BUILT UP → 18.06 SQM
- 3) FUTURE EXTENSION → 7.70 SQM (approx) (G.F.)
- 4) FIRST FLOOR B/UP → 14.616 SQM
- 5) STAIR CASE AREA → 4.38 SQM

TOTAL F F & STAIR CASE = 18.996 SQMT (APPROX)

TREAD = 25 CM
RISER = 19 CM

NAME OF TENEMENT HOLDER *Dr. B.A. Wans*

TENEMENT NO. *N-32/N2/4/5*

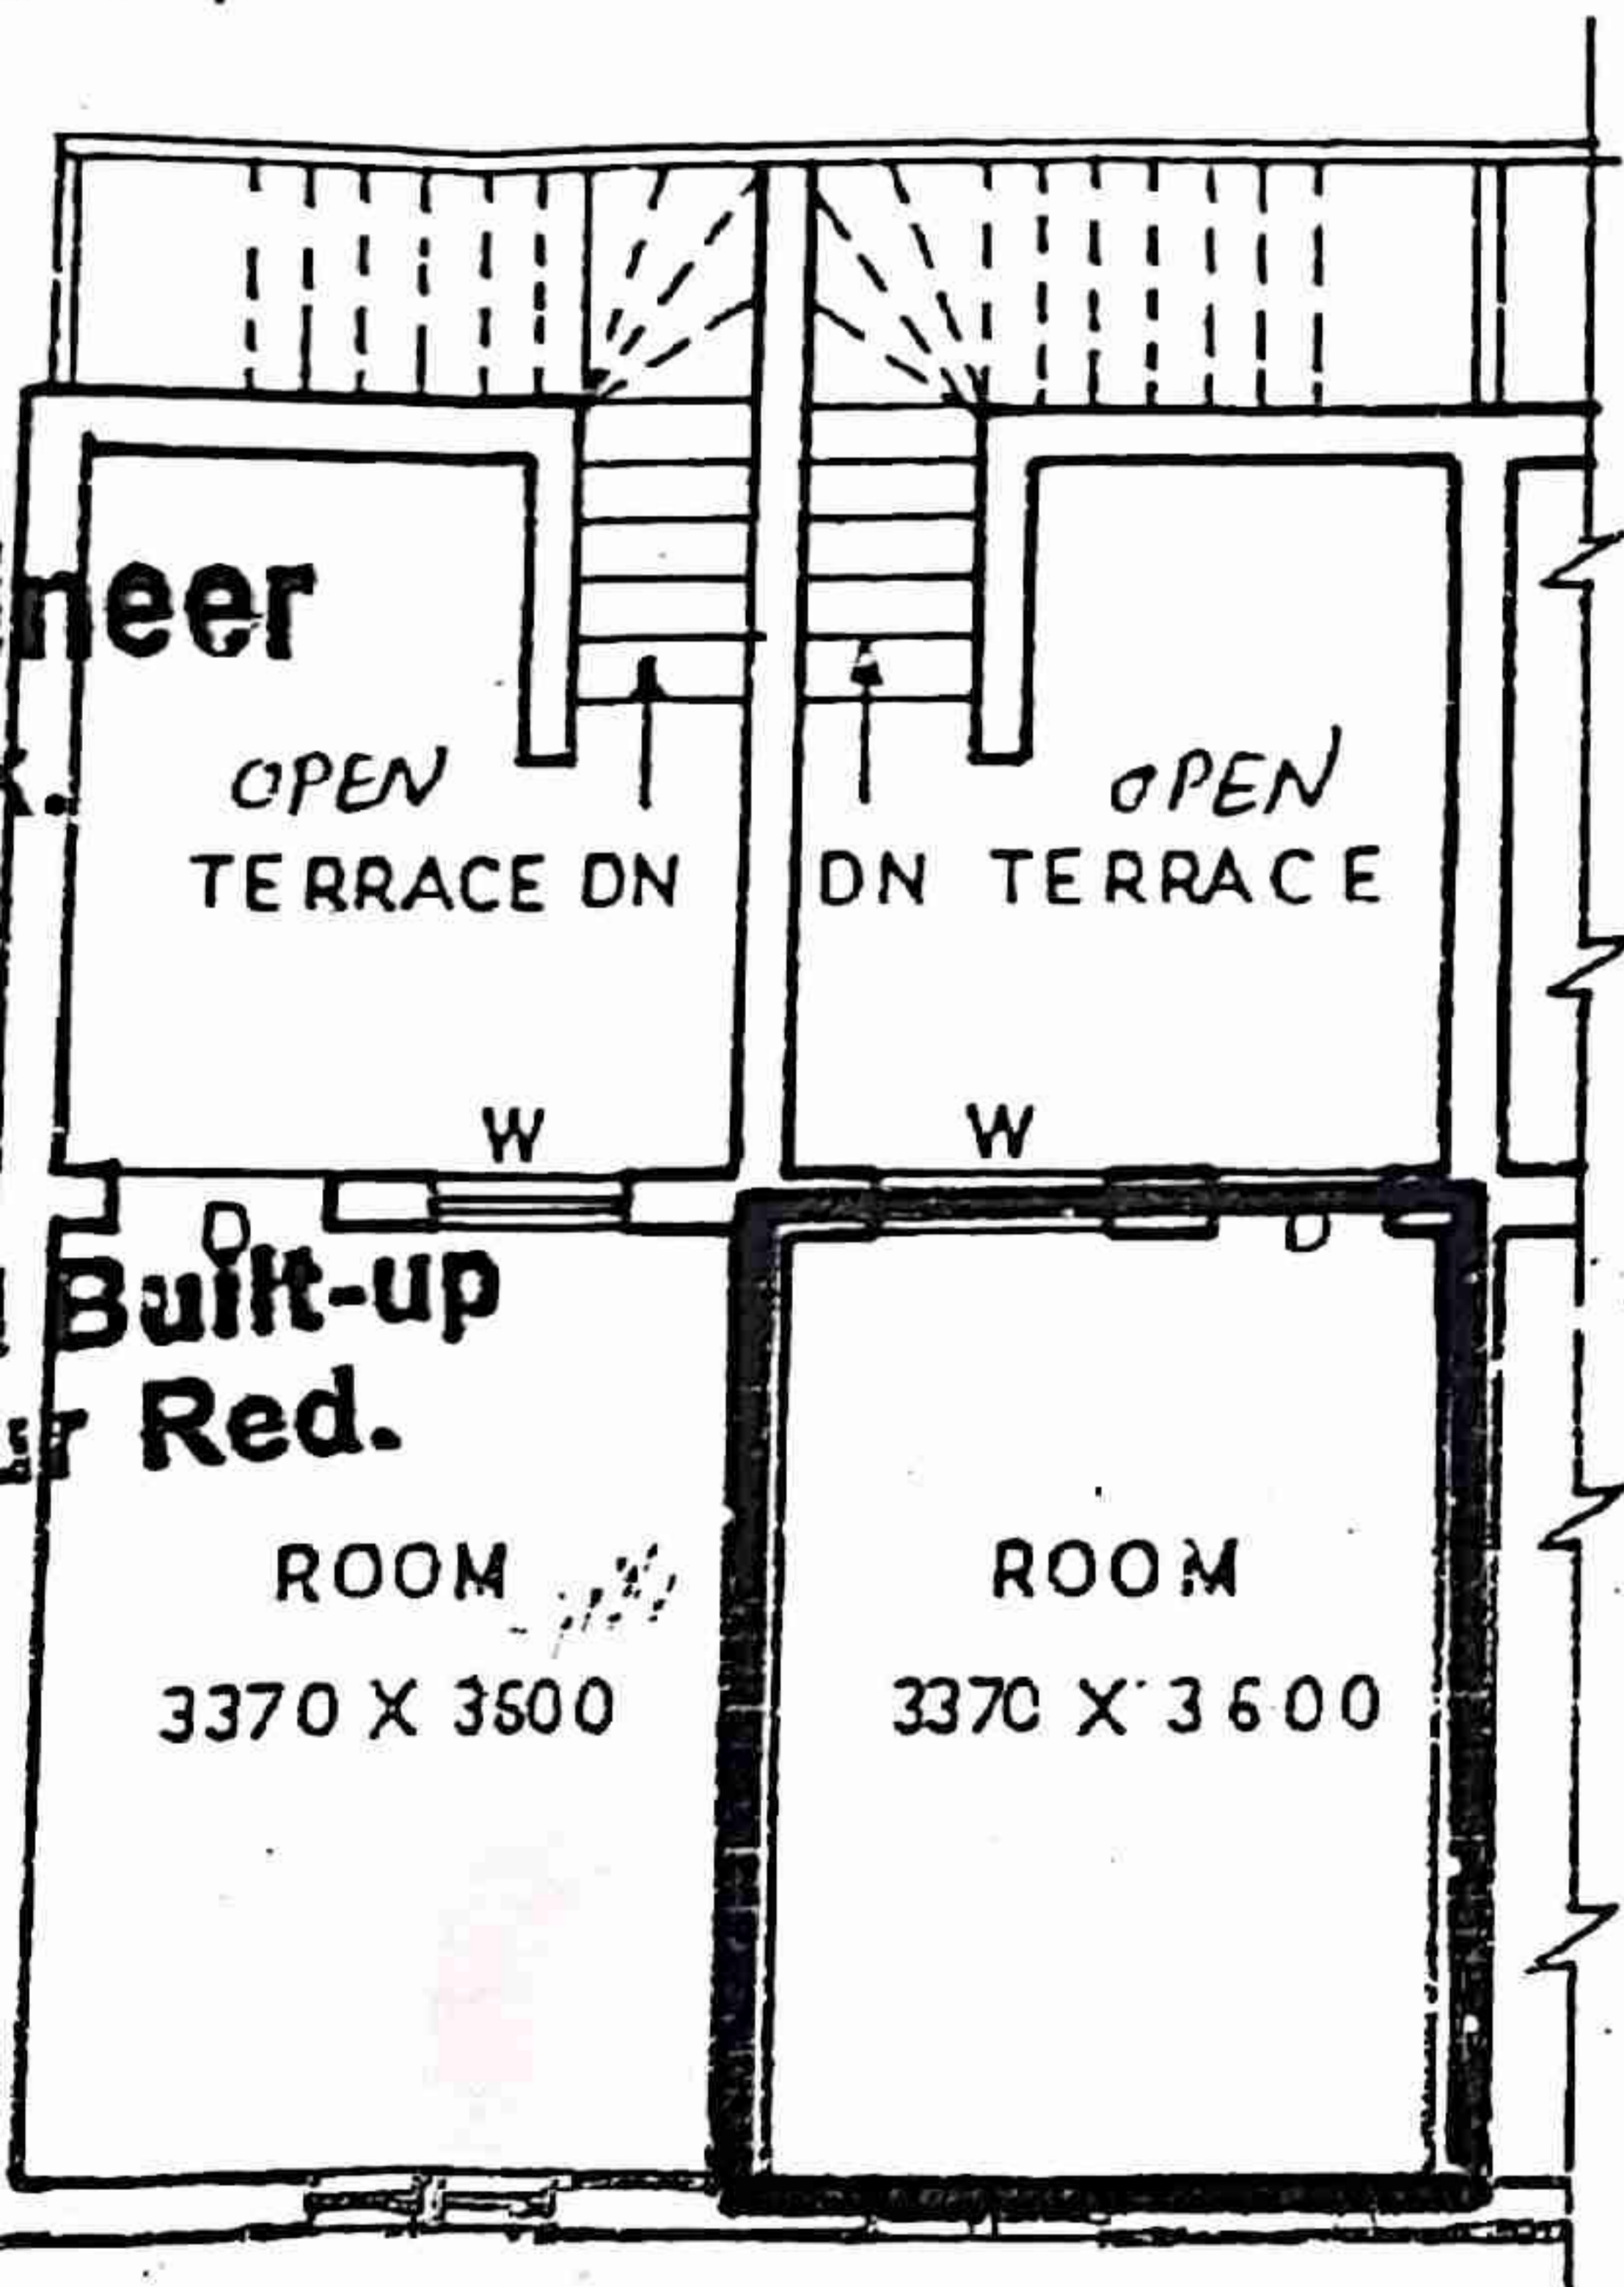

FIRST FLOOR PLAN

CIDCO LTD	
PLANNING (NT) NEW AURANGABAD	
TYPE DESIGN WITH ADDITIONAL CONST. NEW NASHIK.	
LIG/N-32	
HOUSING SCHEEM	
NO	LOCATION
<i>IIIrd</i>	
SCALE: 1:100	
DRAWN BY -	<i>R.L. NIRHALI</i>
ASST PLANNER -	<i>R.M. MANKAR</i>
ASSO / SR. PLANNER -	<i>R.Y. PHADKE</i>
APPROVING AUTHORITY	
<i>Gokul (Manik) Laxmanrao Jay...</i> Special Executive Officer, CIDCO Nashik	
<i>B. Wans</i> OWNERS SIGNATURE	

मजल्यावर देण्यात आलेली माली

mentioned in TINSK/ADM

TESTED