
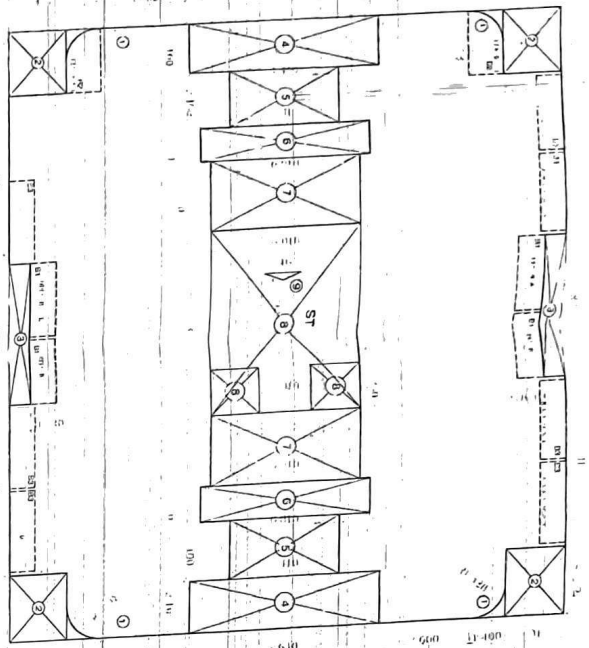


TYPICAL FLOOR PLAN
(1st fl. in 7th Floor)


TYPICAL FLOOR PLAN
(1st fl. in 7th Floor)

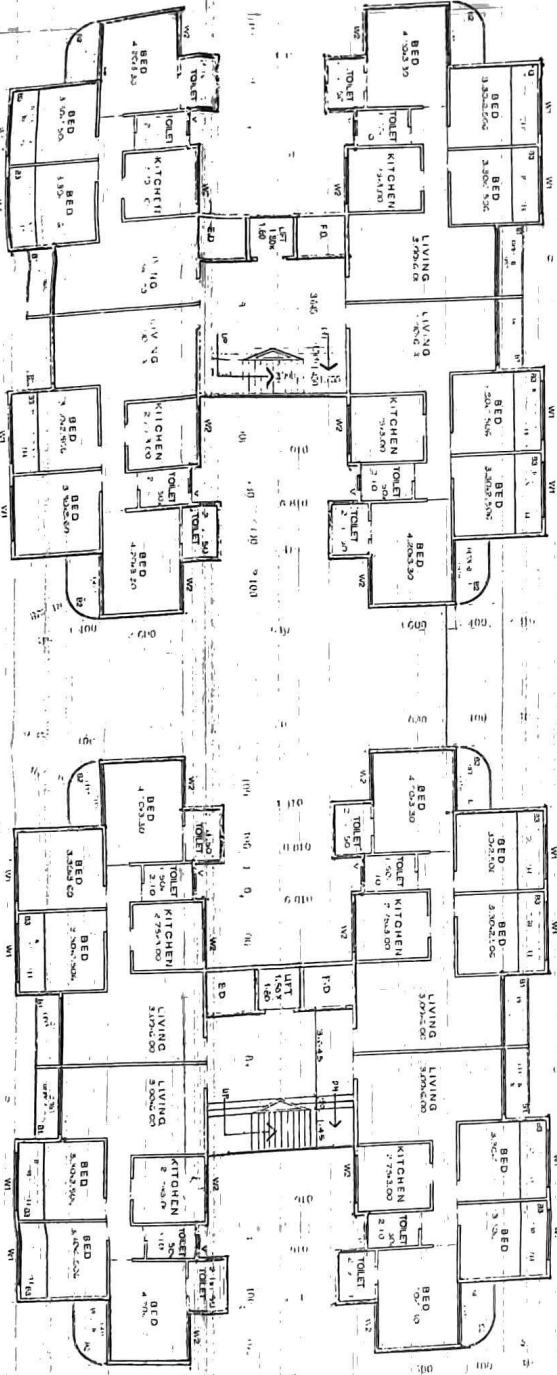

ST AREA CALCULATION
(1ST TO 7TH)

1. 7444.601 = 7148 SQM
2. 1.181 x 6.027 x 6.50 = 46.31 SQM
3. 1.850 x 1.955 x 2.7 = 9.58 SQM
TOTAL ST AREA = 7203.50 SQM
BALANCE AREA = 30.11 SQM
TOTAL ST AREA = 30.11 SQM + 7203.50 SQM

DIRECTOR AREA: 157.91 SQM
TOTAL ST AREA: 30.11 SQM

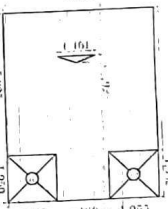

PROVIDER

1) COMMERCIAL LAND BUSINESS USE
2) RESIDENTIAL LAND BUSINESS USE
3) CAR PARK FOR EVERY 1000 SQM
4) CAR PARK MORE THAN 6000 SQM
5) CAR PARK FOR EVERY 2000 SQM
6) CAR PARK MORE THAN 4500 SQM UP TO 6000 SQM
7) CAR PARK FOR EVERY 4500 SQM
8) CAR PARK FOR EVERY 4500 SQM
9) CAR PARK FOR EVERY 4500 SQM
10) CAR PARK FOR EVERY 4500 SQM

ROOM	REQUIRED	PROVIDED	DEFICIENCY
ROOM	1.00	1.00	0.00
LIVING	1.00	1.00	0.00
KITCHEN	1.00	1.00	0.00
BED	2.00	2.00	0.00
TOILET	2.00	2.00	0.00

FLOOR	AREA	PERCENTAGE	TOTAL
FLOOR 1	644.66	16.47%	740.620
FLOOR 2	644.66	16.47%	740.620
FLOOR 3	644.66	16.47%	740.620
FLOOR 4	644.66	16.47%	740.620
FLOOR 5	644.66	16.47%	740.620
FLOOR 6	644.66	16.47%	740.620
FLOOR 7	644.66	16.47%	740.620
TOTAL	4512.62	100.00%	4512.620

OPEN BALCONY CALCULATION

1. 1.181 x 6.027 x 6.50 = 46.31 SQM
2. 1.850 x 1.955 x 2.7 = 9.58 SQM
TOTAL OPEN BALCONY AREA = 55.89 SQM

STAMP OF APPROVAL

AS BUILT DRAWINGS
DESCRIPTION OF PROJECT & PROPERTY
DATE OF ISSUE
DRAWN BY
CHECKED BY
APPROVED BY

DIMENSIONS

AS BUILT DRAWINGS
DESCRIPTION OF PROJECT & PROPERTY
DATE OF ISSUE
DRAWN BY
CHECKED BY
APPROVED BY

NAME, ADDRESS AND SIGN OF THE OWNER

Gradylee R. C.