

**APPROVAL**

**APPROVED**

Demarcated Plan No. 1000 as per  
 Certificate No. 1000/2000  
 No. LHO/MS/001/03/147 dated 20/11/2000  
 View of Section 52(1)(b) and 59  
 of the Maharashtra Regional and  
 Town Planning Act, 1946.

Sd/- 2000  
 Assistant Director of Town Planning  
 Nashik Municipal Corporation  
 Nashik

**DEMARCATION CERTIFICATE**

THIS TO CERTIFY THAT I HAVE VERIFIED  
 DEMARCATED LAYOUT WHICH IS TENTATIVELY  
 APPROVED BY NASHIK MUNICIPAL CORPORATION  
 NASHIK BY LETTER NO. 135 DATE 28/11/2000  
 AND FURTHER CERTIFY THAT THE MEASUREMENTS  
 OF PLOTS, ROADS AND OPEN SPACE ETC. SHOWN IN  
 DEMARCATION PLAN ARE ACTUALLY ON SITE.

**ARCHITECT SIGN**

**AREA STATEMENT**

1) AREA OF THE LAND (AS PER 712)	1000.00
2) AREA UNDER OPEN SPACE	1000.00
3) AREA UNDER M.S.E.B.	25.90
4) AREA UNDER ROADS	1288.71
5) AREA UNDER PLOTS	7803.89
<b>TOTAL (NOT FOR DEVELOPMENT)</b>	<b>3044.40</b>

**NOTES**

- ALL DIMENSIONS ARE IN METERS.
- LAND BOUNDARY SHOWN IN BLACK.
- OPEN SPACE SHOWN IN GREEN.
- PLOT NO. 11, 12, 23 & 24 ARE NOT FOR DEVELOPMENT AS THERE IS DISPUTE IN COURT.


DEMARCATED FINAL RESIDENTIAL LAYOUT  
 PLAN IN S. NO. 764/4 OF NASHIK SURVAY  
 IN NASHIK FOR  
 SRI. SUDHA DINKAR DAFARI & OTHERS  
 G.P.A. HOLDER FOR SELF & OTHERS  
 SRI. SACHIN D. DAFARI.

**R. K. KATALE AND ASSOCIATES**  
 CONSULTING ENGINEERS & ARCHITECTS  
 101, B. K. ROAD, NASHIK  
 TEL: 2534221

**PLOT AREA STATEMENT**

PLOT NO.	AREA IN SQM	PLOT NO.	AREA IN SQM	PLOT NO.	AREA IN SQM	PLOT NO.	AREA IN SQM	
1	311.11	14	163.45	20	214.50	28	240.00	
2	289.20	15	158.12	21	214.50	29	210.00	
3	198.00	16	187.00	22	158.12	30	192.37	
4	216.00	17	212.50	23	158.12	31	243.00	
5	186.00	18	168.43	24	168.43	32	232.00	
6	239.33	19	337.50	25	228.49	33	195.50	
7	234.25	20	247.50	26	228.49	34	195.50	
8	234.25	21	247.50	27	231.80			
9	234.25	22	247.50	28	231.80			
10	234.25	23	247.50	29	231.80			
TOTAL (EXCLUDING PLOT NO 11, 12, 23 & 24 WHICH IS NOT FOR DEVELOPMENT) =								7803.89

TRUE COPY  
 AK-LC  
 MARSHAL & KATALE

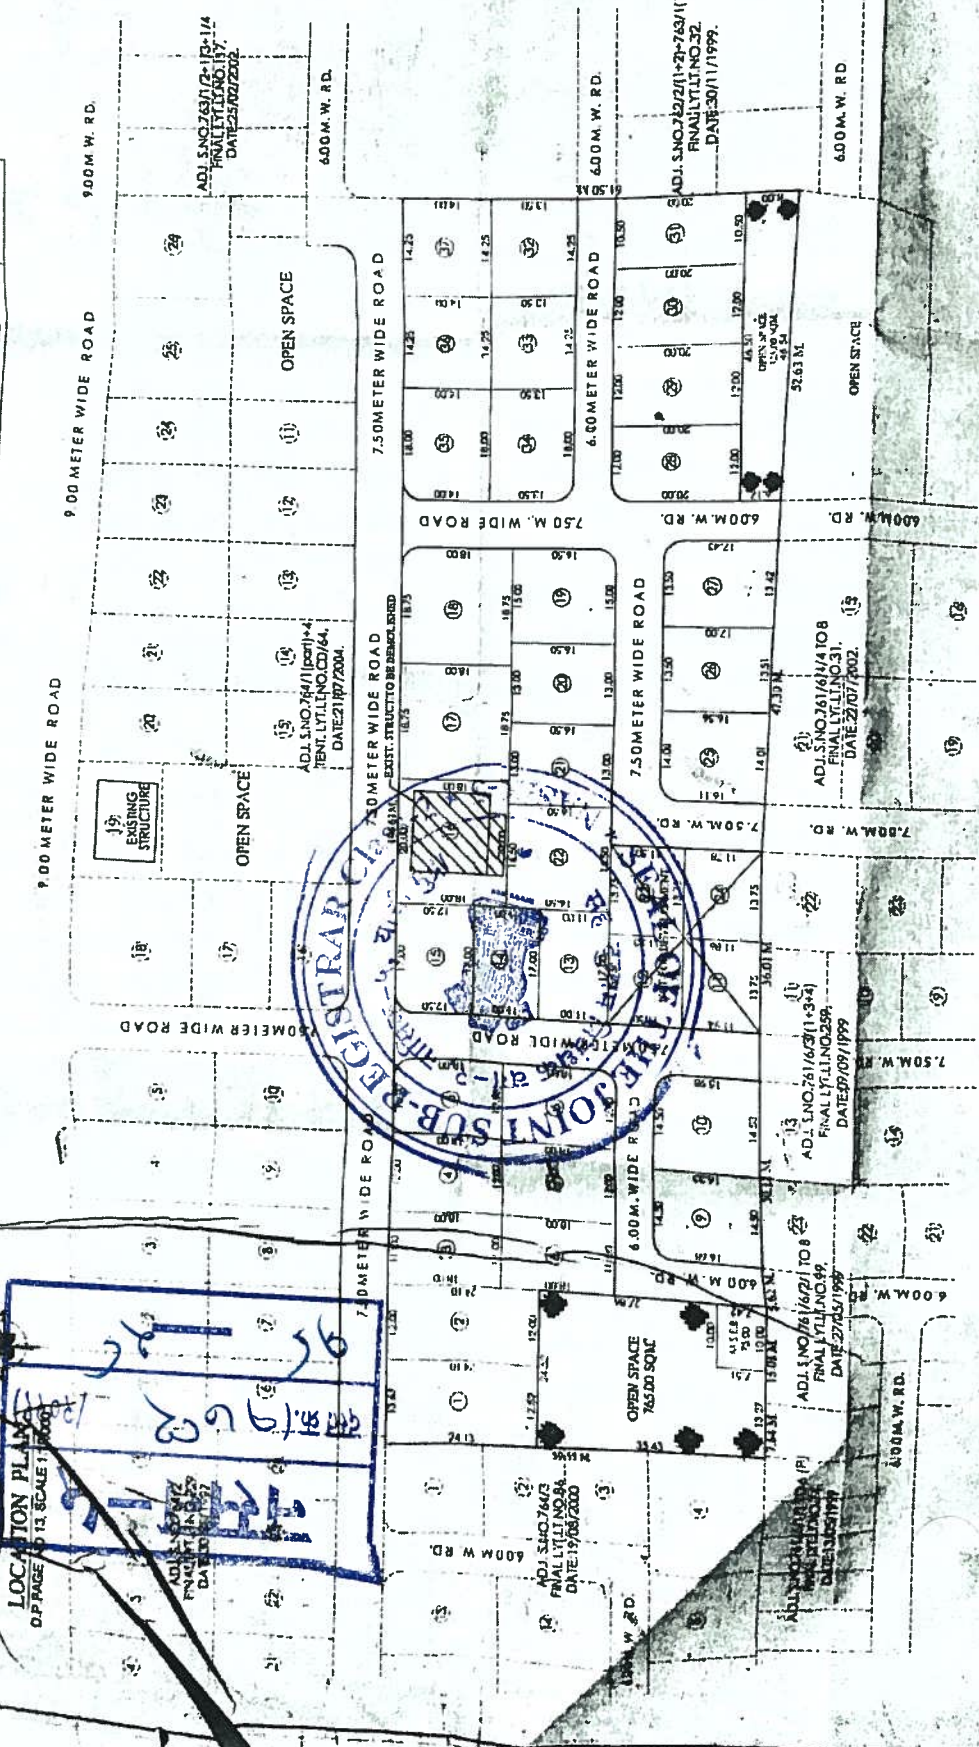

**LAYOUT PLAN**  
 (SCALE 1:500)