

LOCATION PLAN
(SCALE 1:10,000)



PLOT AREA STATEMENT

PLOT NOS	AREA IN SQM	PLOT NOS	AREA IN SQM
1	616.61	7	407.45
2	529.51	8	409.99
3	394.40	9	417.60
4	398.02	10	429.56
5	401.65	11	438.62
6	404.55	12	447.69
TOTAL PLOTTED AREA = 5295.65 SQM.			

APPROVAL APPROVED
(Demarcated Final) Layout as per conditions mentioned in the letter No. LND/WS/97 (Ranch) Dated-09/01/2006, View of Section 152(15) and 69 of The Maharashtra Regional and Town Planning Act, 1966.

TRUE COPY
Katale
(KATALE G. V.) ARCHITECT

Sd/-
Assistant Director of Town Planning,
Nashik Municipal Corporation,
Nashik

DEMARICATION CERTIFICATE

THIS IS TO CERTIFY THAT I HAVE PERSONALLY DEMARICATED THIS LAYOUT WHICH IS TENTATIVELY APPROVED BY NASHIK MUNICIPAL CORPORATION NASHIK VIDE LT. NO. 31, DT. 07/07/2007 AND FURTHER CERTIFY THAT THE MEASUREMENTS OF PLOTS, ROADS AND OPEN SPACE ETC. SHOWN IN DEMARICATION PLAN ARE ACTUALLY ON SITE.

ARCHITECT SIGN.

AREA STATEMENT AREA IN SQM.

1) AREA OF THE LAND (AS PER 7/12)	8,300.00
2) AREA UNDER OPEN SPACE	830.00
3) AREA UNDER M.S.E.B.	50.00
4) AREA UNDER COLONY ROAD	2124.35
5) AREA UNDER PLOTS	5295.65

- NOTES :-
- ALL DIMENSIONS ARE IN METER.
 - LAND BOUNDARY SHOWN IN BLACK.
 - OPEN SPACE SHOWN IN GREEN.


DEMARICATED FINAL LAYOUT PLAN IN S.NO.194/1/2 OF NASHIK SHIWAR AT DAMODAR NAGAR, PANCHAVATI, NASHIK FOR - SMT. RAJUBAI D. GITE & OTHERS-15, G.P.A. HOLDER-SHRI SUDHIR S. BODKE.

Katale
AR. SHRI G. V. KATALE
ARCHITECT SIGN

Smt. Rajubai D. Gite & Others
G.P.A. HOLDER SHRI SUDHIR S. BODKE
OWNER SIGN

G.V. KATALE AND ASSOCIATES
CONSULTING ENGINEERS & ARCHITECTS
OFFICE: 01, KAMAL RESIDENCY, PATEL LANE, A NEAR PODDAR HOUSE, COLLEGE ROAD, NASHIK-5.
PH: (025) 258026, 2579927
Email: g.v.katale@stv.com

ACCESS KEY: DAMODAR NAGAR 194/1/PART
JOB REF: AS PER P.T. SHEET
DATE: 25.06.2007
SCALE: 1:500
CHKD BY: KATALE G. V.
DRL BY: KATALE G. V.

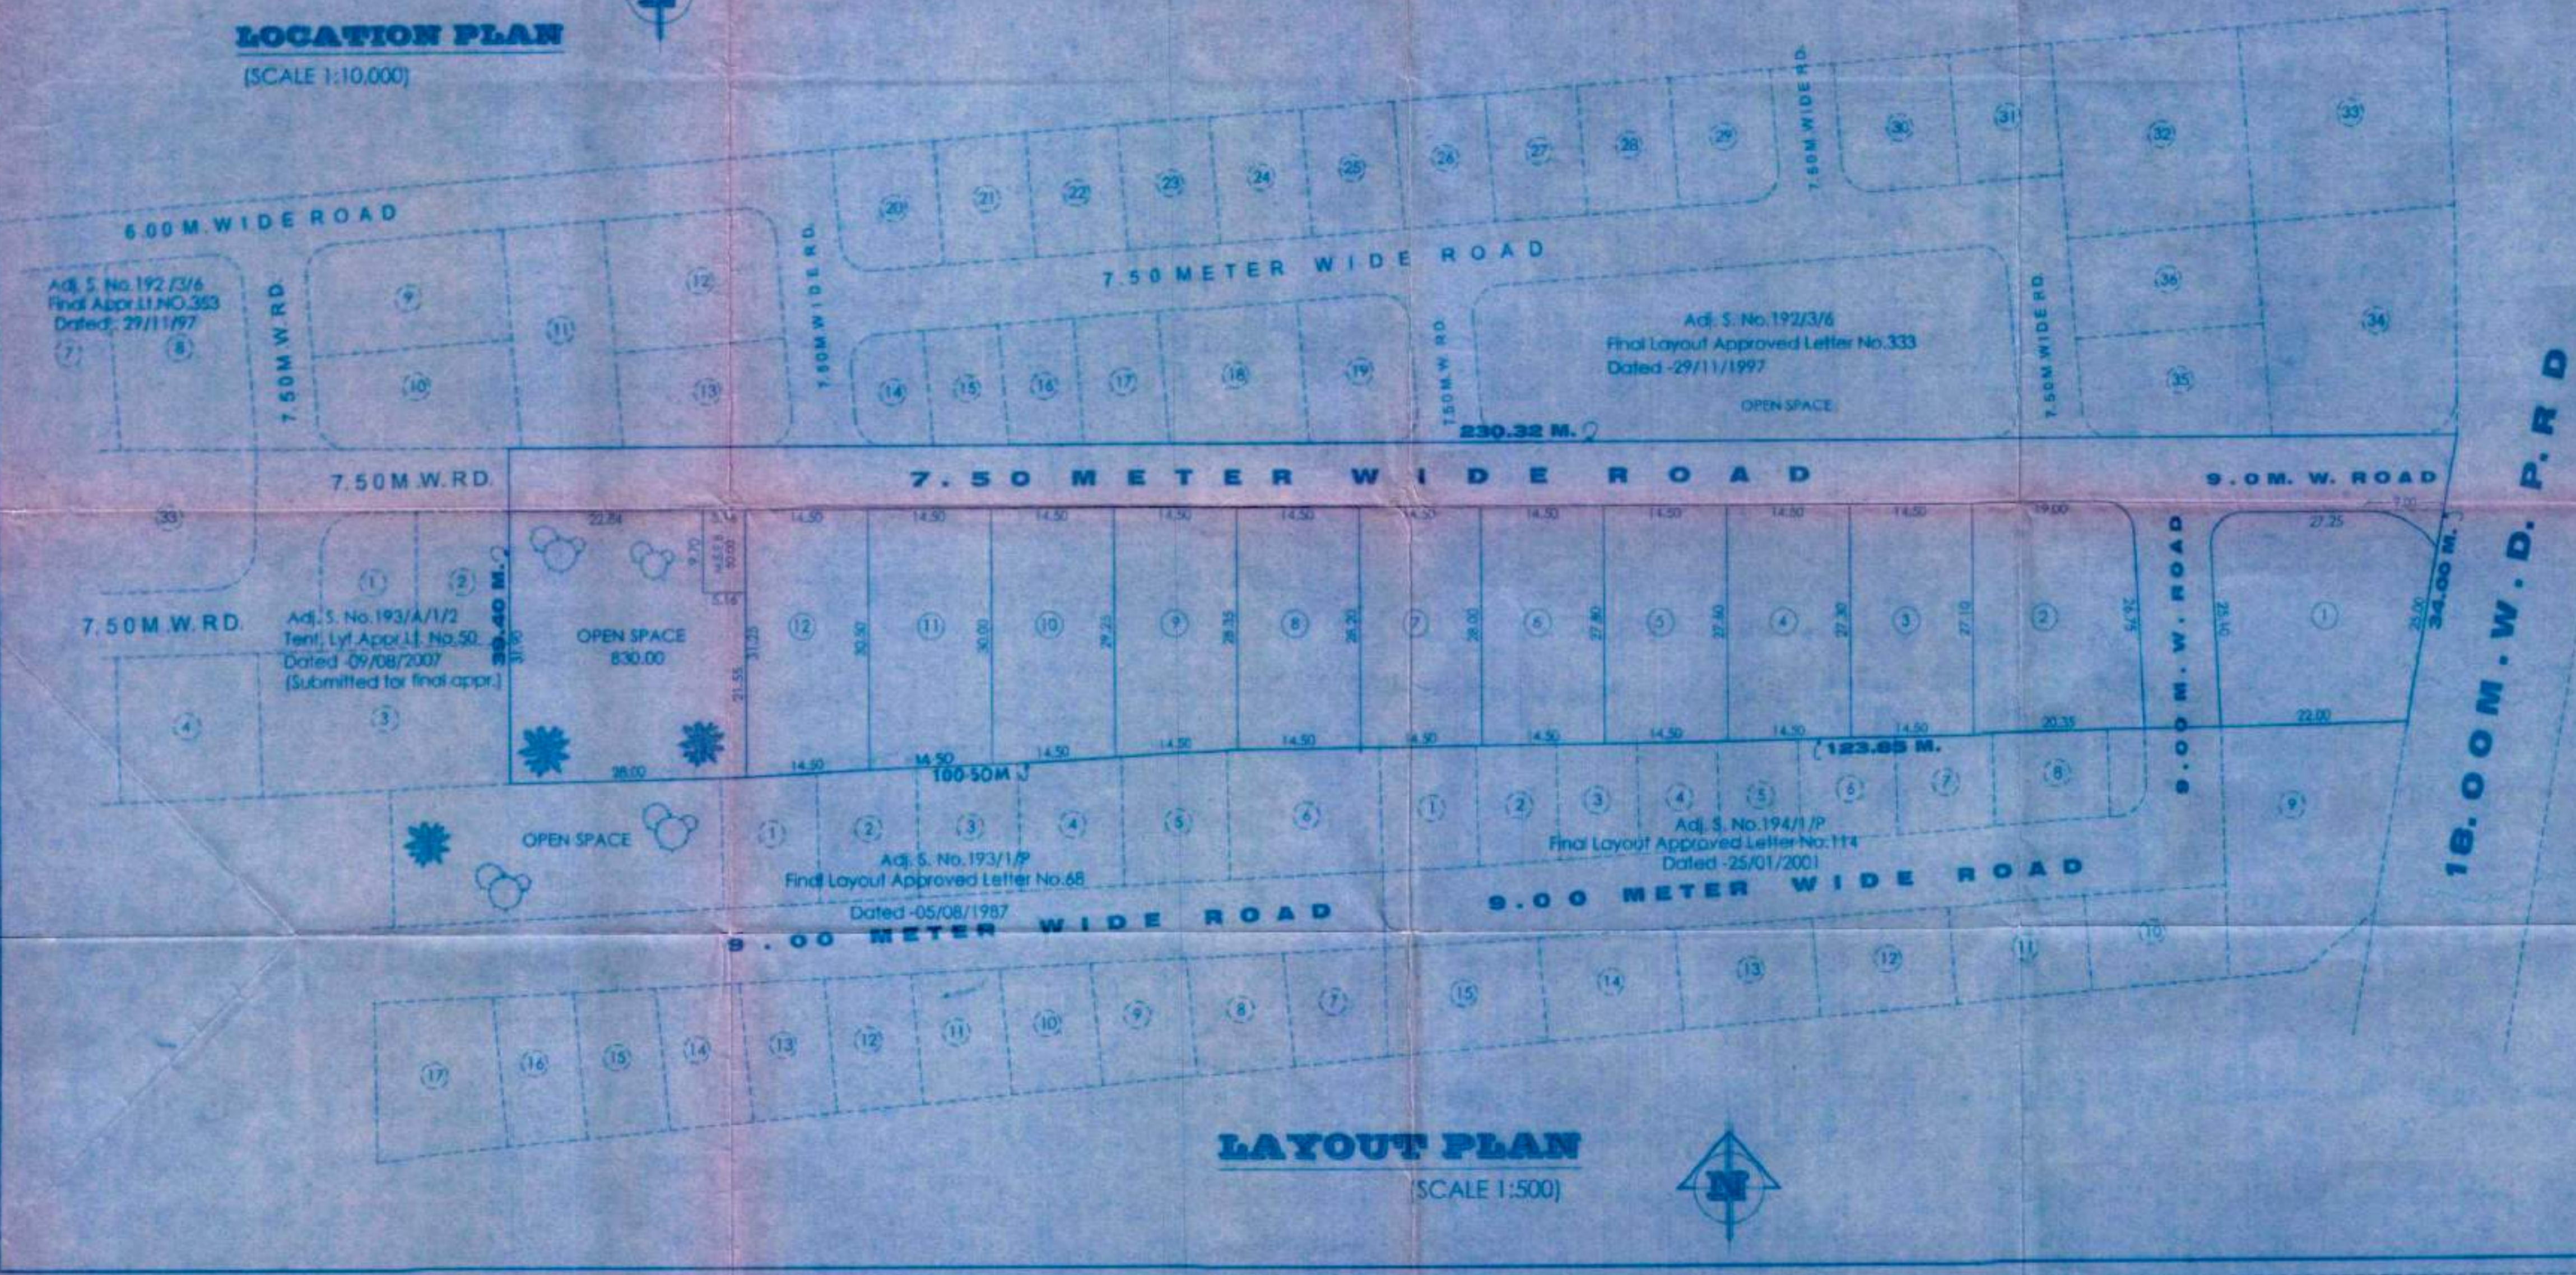

LAYOUT PLAN
(SCALE 1:500)

