



18.00 M. WIDE D. P. ROAD

ADJ. S. NO. 201(PART)  
ADJ. PRIMARY SCHOOL RESERVATION

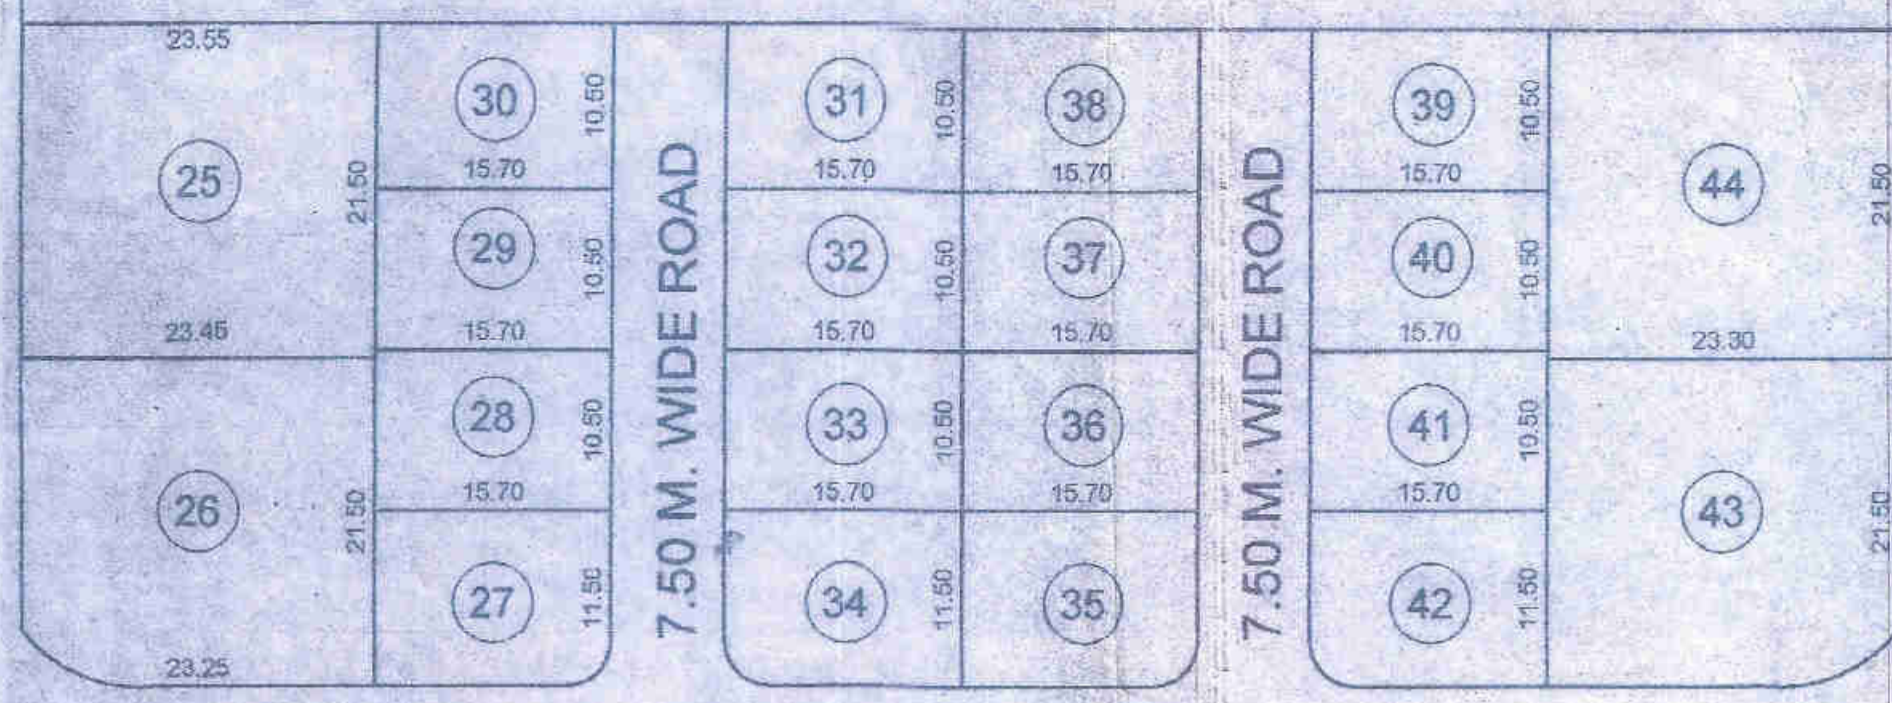


7.50 M. WIDE ROAD

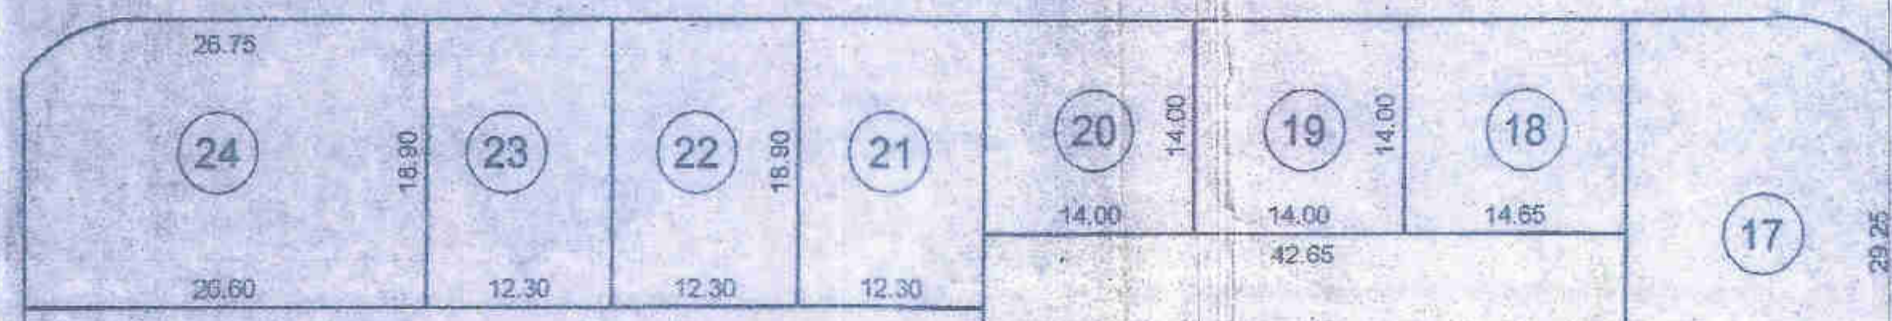

7.50 M. WIDE ROAD




7.50 M. W. ROAD

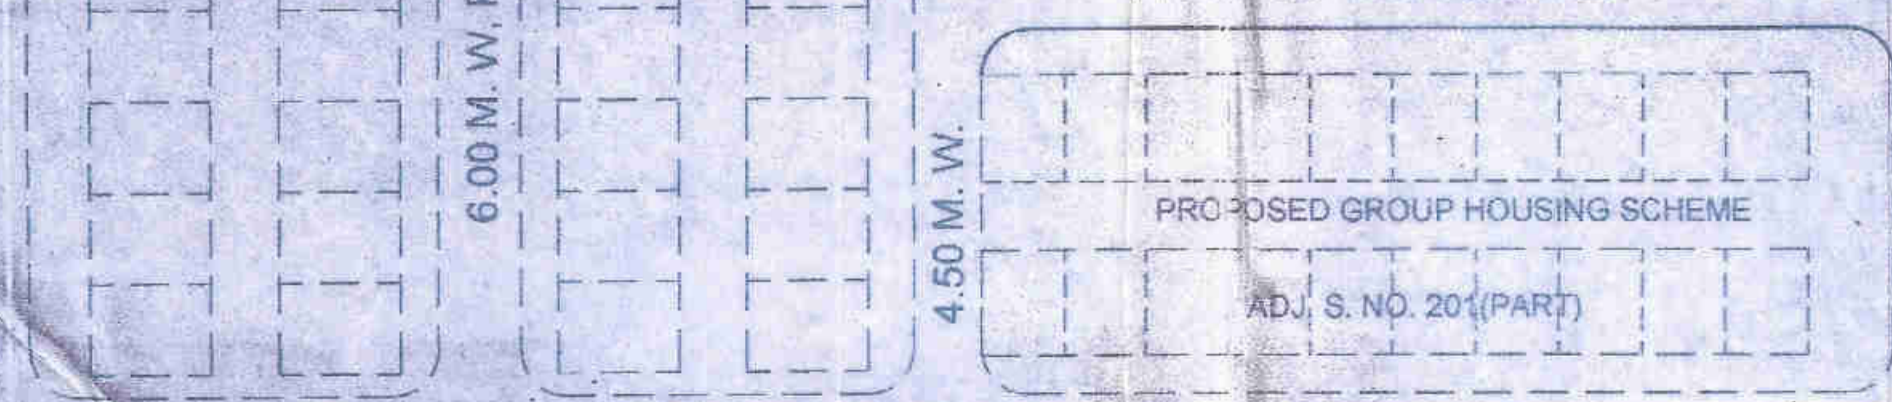


7.50 M. W. PATHWAY

7.50 M. W. ROAD

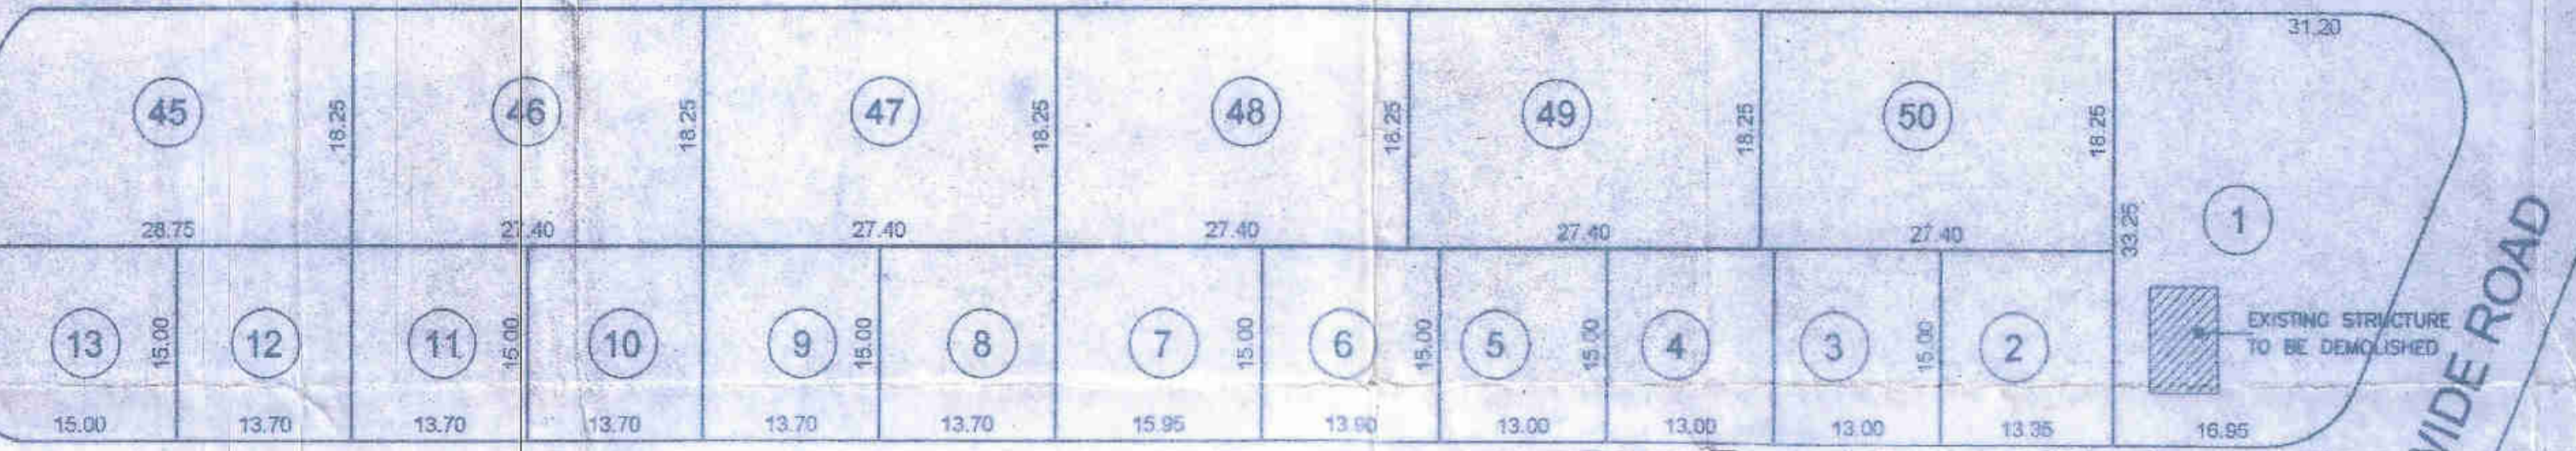

9.00 M. WIDE ROAD

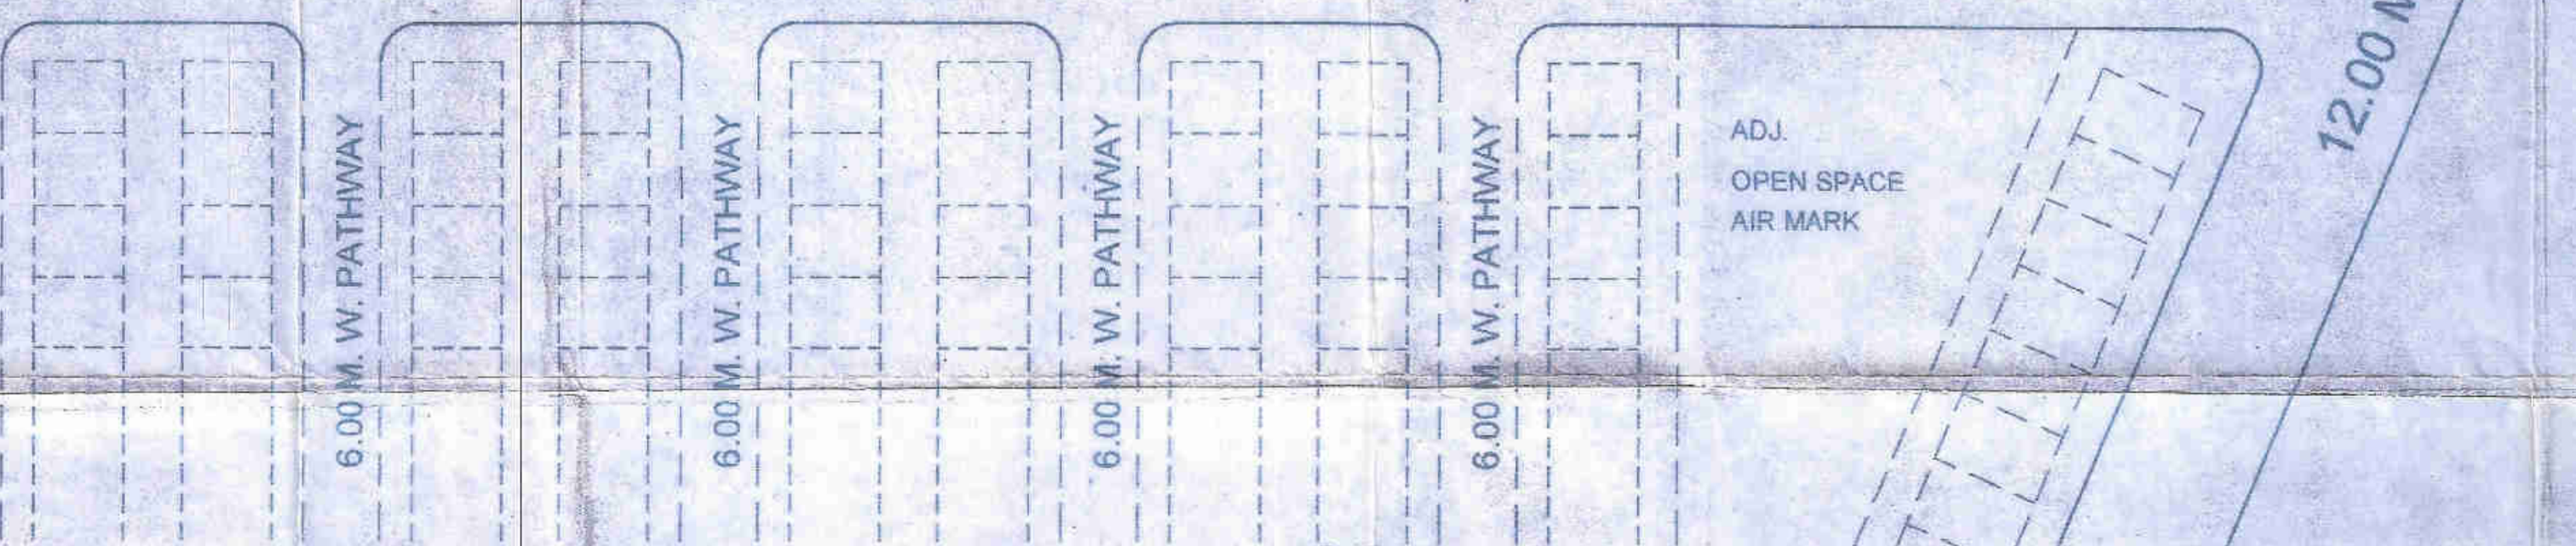


9.00 M. W. PATHWAY

LAYOUT PLAN  
SCALE 1:500



**:: DEMARCATION CERTIFICATE ::**  
THIS IS TO CERTIFY THAT THE LAYOUT OF S.NO 201/(1+2+3)(p) OF NAHSHIK SHIWAR, TALUKA & DIST. NASHIK WHICH WAS TENTATIVELY APPROVED BY NASHIK MUNICIPAL CORPORATION OF NASHIK VIDE LETTER NO. TPD/87/PANCH. DATED: 24/08/2004 HAS BEEN DEMARCATED AS PER THIS FINAL LAYOUT AND FURTHER CERTIFY THAT ALL MEASUREMENTS TALLY ONSE.

ARCHITECTS SIGNATURE

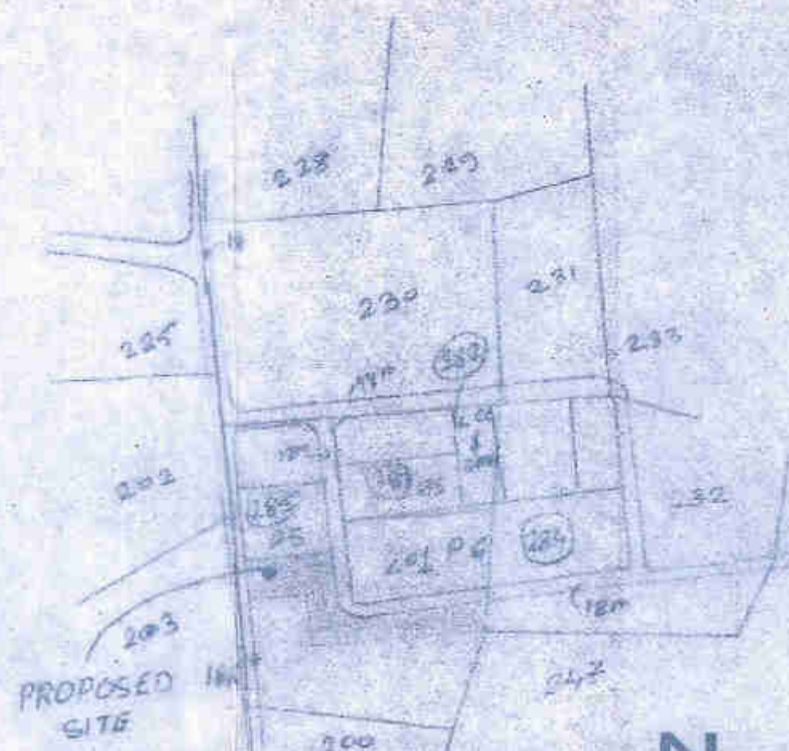

LOCATION PLAN  
(SCALE 1:10000)

ADJ. S. NO. 201(PART)  
ADJ. PLAY GROUND RESERVATION

18.00 M. WIDE D.P. ROAD

PLOT AREA STATEMENT IN SQM.					
P.NO.	AREA	P.NO.	AREA	P.NO.	AREA
1	800.50	15, 16	207.00	28	164.85
2	200.25	17	526.50	TO 33	164.85
3	195.00	18	205.10	34, 35	180.55
TO 5		19, 20	196.00	36	164.85
6	208.50	21	232.47	TO 41	164.85
7	239.25	TO 23		42	180.00
8	205.50	24	504.15	43, 44	500.95
TO 12		25	504.71	45	524.68
13	225.00	26	502.02	46	500.05
14	202.50	27	180.55	TO 50	500.05
TOTAL NO. OF PLOTS = 50			TOTAL = 13961.06 SQM.		

STAMP OF APPROVAL

**APPROVED**  
(Demarked Final) Layout as per Conditions. Mentioned in the letter No. LND/WS/28/dt.29/6/2005 View of Section 152 (13) and 69 of The Maharashtra Regional and Town Planning Act 1966

Executive Engineer  
TOWN PLANNING  
Nashik Municipal Corporation  
Nashik

DEMARKETED FINAL LAYOUT PLAN  
N S. NO. 201/(1+2+3) (p) OF VILLAGE NASHIK TAL. & DIST. NASHIK.  
FOR-SHRI.-S. D. SHARMA & OTHERS  
THROUGH G.P.A. SHRI. C. B. SHAH

**NOTES-**  
BOUNDARY OF PROPERTY SHOWN IN BLACK.  
OPEN SPACE SHOWN IN GREEN.  
EXISTING STRUCTURE SHOWN IN HATCH.

AREA STATEMENT:	
AREA OF LAND AS PER 7/12	= 41140.00 SQM.
AREA UNDER D.P. ROAD	= 14025.00 SQM.
AREA UNDER LAYOUT	= 20053.00 SQM.
AREA UNDER OPEN SPACE	= 2006.00 SQM.
AREA UNDER M.S.E.B.	= 125.00 SQM.
AREA UNDER COLONY ROADS	= 3960.64 SQM.
AREA UNDER PLOTS	= 13961.06 SQM.

ARCHITECT SIGN.	OWNERS SIGN.
C. G. MAYUR	SHRI. C. B. SHAH

**C. G. MAYUR**  
ARCHITECTS, ENGINEERS, VALUERS.  
1/2, MAYUIRMILAN DATEY NAGAR  
NEAR MATEY URSERY OFF. GANGAPUR ROAD,  
NASHIK-13, TELE. 2340605, M. NO. 9822377883