



OFFICE OF THE REGIONAL MANAGER

GIDC Administrative Office Building,
Plot No. C-5/101, Char Rasta,
G.I.D.C., Vapi - 396 195. Dist. - Valsad.
(Ph.) 0260- 2432667 / 2432670 (FAX) 0260 - 2420502
e-mail : rmvapi@gidcgujarat.org.

No. GIDC/RM/PI/PLT/AMAL/FTO/ 3612

BY.R.P.A.D.

Date :

1 8 OCT 2016

// ORDER //

Sub : Amalgamation of Indl. Plots No.4922, 4913, 4914, 4915, 4920 & 4921 at Sarigam Industrial Estate.


The Corporation has transferred on 10/11/2015 for Plot No.4922 having plot area admeasuring 1505.00 & Amalgamation on 14/06/2011 of Plot No.4913, 4914, 4915, 4920 & 4921 plot area admeasuring 9059.00 to you in Sarigam Industrial Area of the Corporation. The lease deed has executed on 08/01/2010 for Plot No.4913, 4914, 4915 & The lease deed has executed on 18/12/1996, Deed of Assignment Registered on 20/09/2005 & Deed of Declaration of Change in Company's executed on 02/08/2006 for the Plot No.4920 & 4921 and respectively. You have applied to the Corporation for amalgamation of above mentioned Plot at Sarigam Industrial Area and after amalgamation the total plot area 10564.00 Sq.mtrs.

The said allottee have applied to the Corporation for amalgamation of both the Indl. Plots No.4922 + 4913, 4914, 4915, 4920 & 4921 at Sarigam Industrial Area. Party's request has been considered & Certain terms & conditions have been stipulated by the Regional Manager, GIDC, Vapi as per letter No.3235, dtd.20/09/2016, hence forth said Plots shall stands as amalgamated as Indl. Plot No. 4922 + 4913, 4914, 4915, 4920 & 4921, area admeasuring 10564.00 Sq.Mtrs.

On account of amalgamation as above, the liabilities and obligation under the Lease Deed executed on dtd.08/01/2010 & 18/12/1996 for both properties remains unchanged.

Revised boundaries of amalgamated plots shall be as under :

On or towards the North by : 16'.00" wide road & Plot No.4923
On or towards the South by : Plot No.4916, 4918
On or towards the East by : 16'.00" wide road
On or towards the West by : 16'.00" wide road & Plot No.4916, 4917


Regional Manager,
GIDC, Vapi.

To,
M/s. Techno Tarp and Polymers Pvt. Ltd.
Indl. Plot No.4922, 4913, 4914, 4915, 4920 & 4921
GIDC, Sarigam - 396 155

C. C. To :

- 1) The Executive Engineer, GIDC, Vapi.
- 2) The Dy. Accounts Officer, GIDC, Vapi.
- 3) The Dy. Executive Engineer, GIDC, Sarigam.
- 4) The Chief Officer, Notified Area, GIDC, Sarigam.
- 5) The Computer Branch, DM/RM, office, Vapi Region, Vapi....for data entry purpose.



OPPO A74 5G



GUJARAT INDUSTRIAL
DEVELOPMENT CORPORATION

OFFICE OF THE REGIONAL MANAGER,
GIDC Administrative Office Building,
Plot No. C-5/101, Char Rasta,
G.I.D.C., Vapi - 396 195. Dist. - Valsad.
(Ph.) 0260-2432667 / 2432670 (FAX) 0260 - 2420502
e-mail : rmvapi@gidcgujarat.org.

No. GIDC/RM/PI/PLT/SRG/FTO/ LA W 71

Date :- 10 NOV 2015


// OFFICE ORDER //

Sub : Transfer of Plot No. 4922, at Sarigam Industrial Estate.

A Plot No. 4922, having Plot area admeasuring about 1505.00 Sq. Mtrs. was allotted to M/s Rishika Packaging. The License Agreement has been executed on 26/07/2005 & Supplementary Agreement has been executed on 19/02/2014. You have applied for transfer of the said Plot in favour of M/s Techno Trp & Polymers Pvt. Ltd., for manufacturing of HDPE Tarpaulin. Certain terms and conditions have been stipulated by the Regional Manager, GIDC, Vapi as per letter No. 3783, dtd. 09/10/2015.

The License has paid all dues of the Corporation upto 2015-2016. He has also paid the transfer fee at the rate of 21.50% of value of the land amounting to Rs. 3,26,811/-. The Supplementary Agreement has been executed on 05/11/2015, between the Licensee Transferee & Corporation. The Plot now therefore stands transferred in the name of M/s Techno Trp & Polymers Pvt. Ltd., with effect from 05/11/2015. This transfer permission shall not to be considered as valid under the building bye-laws of the Corporation. If any unauthorized construction is carried out by Transferee. If any un-authorized construction is carried out, the same shall not be considered that Corporation has regularized the same. Transferee shall have to remove/demolish, non-violative construction or shall have to be got approved from the Corporation. The water requirement as per transfer application for process : 2,000/- Lit/day. For sanitization : Domestic use only, and for cooling : Nil Litrs. / normal use only.

Transferee shall have to contact to Notified Area Authority(Water Supply) for water bill, G.I.D.C., Sarigam, regarding change in name with water bill.

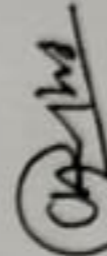
REGIONAL MANAGER,
GIDC, VAPI.

To,
1) M/s Techno Tarp & Polymers Pvt. Ltd,
Plot No.4913-14-15, GIDC, Sarigam,
Taluka - Umbergam, District - Valsad,

2) M/s Rishika Packaging,
Plot No.4922,
GIDC, Sarigam,
Tal.-Umbergam, Dist.-Valsad,


Copy to :

- 1] The Executive Engineer, GIDC, Vapi.
- 2] The Accounts Officer, GIDC, Vapi.
- 3] The Deputy Executive Engineer, GIDC, Sarigam,
- 4] The Chief Officer, N. A. & W/S, GIDC, Sarigam,
- 5] The President, Sarigam Industries Association, G.I.D.C., Sarigam,
- 6] Computer Branch, GIDC, Vapi..... Entry in TSP Entry,

SHEET 2/2

STAMP OF APPROVAL

APPROVED SUBJECT TO THE CONDITION
STIPULATED UNDER THIS OFFICE LETTER
NO. GIDC / XEN . / VPI / ADM / SS.
DT. 20.11.24. WHICH IS ATTACHED
HEREWITH

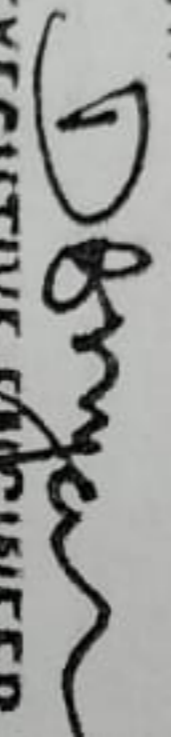
EXECUTIVE ENGINEER
G.I.D.C., VAPI.



GUJARAT INDUSTRIAL
DEVELOPMENT CORPORATION

OFFICE OF THE REGIONAL MANAGER

GIDC Administrative Office Building,
Plot No. C-5/101, Char Rasta,
G.I.D.C., Vapi - 396 195, Dist. - Valsad.
(Ph.) 0260-2432667 / 2432670 (FAX) 0260 - 2420502
e-mail : rmvapi@gidcgujarat.org.

No. GIDC/RM/VPI/PLT/SRG/TFR/
BY.RPAD.

3783

Date : 9 OCT 2015

To,
M/s Rishika Packaging,
Plot No. 4922, GIDC, Sarigam,
Taluka - Umbergam, District - Valsad,

Sub: - Sarigam Industrial Estate/Area,
Intimation for transfer of Plot No. 4922, Area 1505.00 Sq. Mtrs.
Greetings,

The Corporation has allotted Plot No. 4922, having plot area of 1505.00 Sq. Mtrs. in Sarigam Industrial Estate/Area of the Corporation. The Licenc Agreement has been executed on 26/07/2005 & Supplementary Agreement has been executed on 19/02/2014. You have applied to the Corporation for transfer in favour of M/s Techno Tarp & Polymers Pvt. Ltd. for manufacturing of HDPE Tarpaulin.

Your request for transfer can be considered provided the following conditions are fulfilled and the permission of transfer can be granted as provided in the clause of License/Lease Agreement/ Agreement for sale executed with you as mentioned above.

- 1) All outstanding dues, instalments, revenue charges, water charges, Drainage charges & Notified Area Tax, shall be paid by you before the transfer is affected i.e. within a period of 30 days.
- 2) Since the Service of Sarigam Industrial Estates maintained by the Association/Notified Area Office and G. I. D. C., you shall have to obtain "No Dues Certificate" from Sarigam Industries Association/Notified Area Officer, Sarigam from Notified Tax, and Deputy Executive Engineer's Certificate for water charges.
- 3) You shall have to pay being transfer fees amounting to Rs. 3,26,811/- (Rupees Three Lacs Twenty Six Thousand Eight Hundred Eleven Only) in favour of "G. I. D. C", payable at Vapi and already paid Rs. 1,140/-, Administrative charges Rs.1000/-, and Service Tax Rs.140/- vide D. D. No. 286403, Dtd. 31/07/2015.
- 4) The Transferor and Transferee shall have to execute Annexure "A" & "B" respectively duly got affixed Special Adhesive Stamp of Rs.100/- for removal/regularization of the unauthorized construction in the form prescribed by the Corporation (Specimen copy enclosed),
- 5) In the event of increase in the Bank rate or in the minimum rate of lending by the financial institution or on account of increase in the overall borrowing rate of interest in the money markets, the rate of interest will be suitably revised by the Corporation from time to time and the Hirer/Licensee/Lessee shall be called upon to pay the interest on outstanding amount at such higher rate from the date of such revision and in such event, the amount of instalment will be so refixed so as to absorb the higher rate of interest. The Hirer/Licensee/Lessee shall be bound to pay such instalments as may be re-fixed.
- 6) The Transferee shall have to comply with the provision of Water Prevention & Control pollution Act-1974 and accordingly to obtain consent from the State Water Pollution & Control Board, Gujarat State before discharging such sewerage or Trade effluent, his plant and her shall not discharge such sewerage or trade effluent without getting such consent and failure to observe this condition would entitle the Corporation to disconnect water supply to the allottee and to resume back possession of land.

SCALE : 1:250

TITLE : SECTION, ELEVATION, AREA CALCULATION & SITE PLAN


TYPES OF PLOT :- INDUSTRIAL

LICENSE NO.

ENGINEER : REG. NO. GIDC/ATP/EOR/035

STRUCTURAL ENGINEER : REG. NO. GIDC/ATP/SEOR/037

ARCHITECT / ENGINEER SIGN. I -

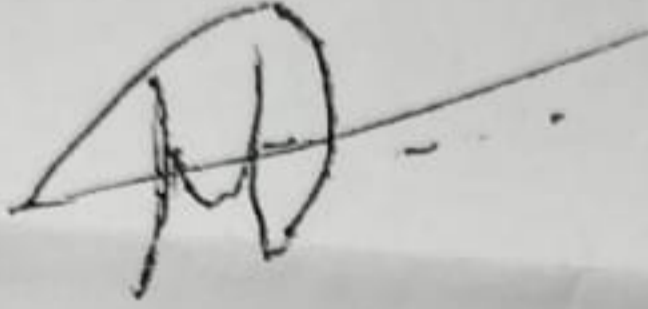


MISTRY ASSOCIATES
CONSULTING ENGINEER
ARCHITECTURAL &
STRUCTURAL
DESIGNER

NIKUNJ I. MISTRY
(B.E. Civil, MIE)
REG. NO. M-1562163

203, RIDDHISIDHHI CHAMBER
NEAR INDIAN BANK
G.I.D.C. CHAR RASTA
VAPI - 396 195, GUJARAT.
Mob:- 09825512075 / 09825512975
E Mail : mistry_associates@yahoo.co.in

OWNER SIGN. I -

Techno Tarp & Polymers Pvt. Ltd.

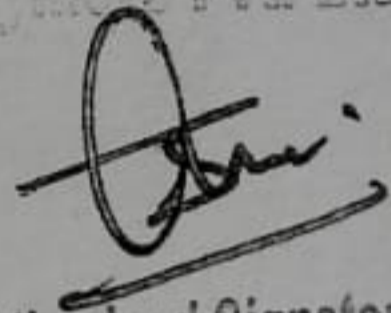


Authorised Signatory

VIOLATIVE AND NON VIOLATIVE PLAN FOR THE
FACTORY BUILDING ON PLOT NO. 4912/1,
4913, 4914, 4915, 4920, 4921, 4922
AT G.I.D.C SARIGAM

FOR, M/S TECHNO TARP & POLYMERS PVT LTD.

OPPO A74 5G

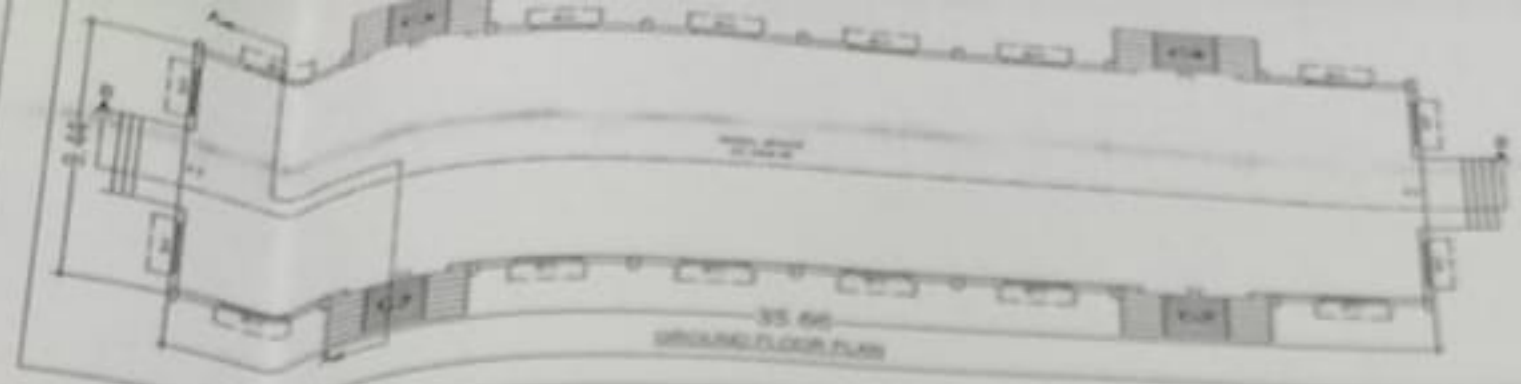

BLDG-D







GROUND, FIRST & SECOND FLOOR - APPROVED AREA

AREA CALCULATION:
 (A) $20.00 \times 37.70 = 754.00 \text{ Sq. mt.}$
 PROP. B. UP AREA = 754.00 Sq. mt. ①

LESS AREA:
 (B) $2 \times 06.37 \times 04.10 = 52.23 \text{ Sq. mt.}$
 TOTAL AREA = 52.24 Sq. mt. ②



F.S.I AREA = (1-2) = $754.00 - 52.24 \text{ Sq. mt.}$
 = 701.76 Sq. mt.

F.S.I AREA = 701.76 Sq. mt.

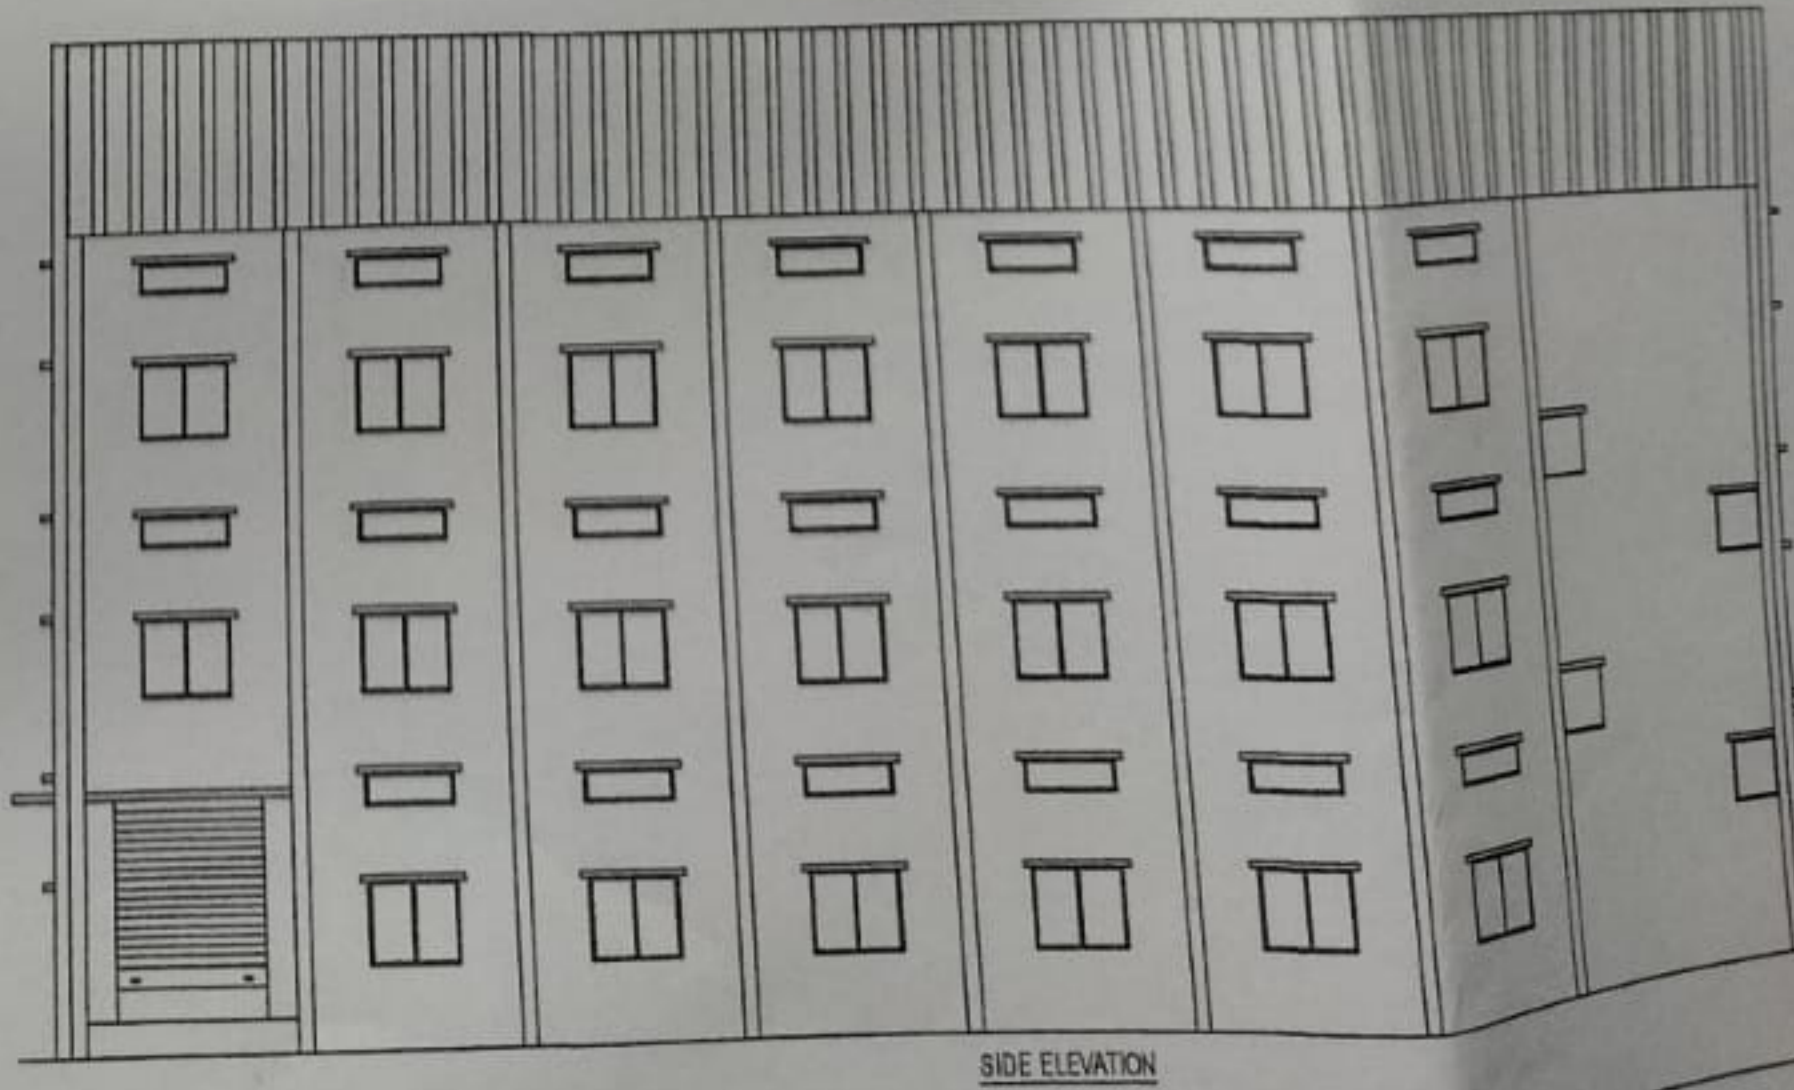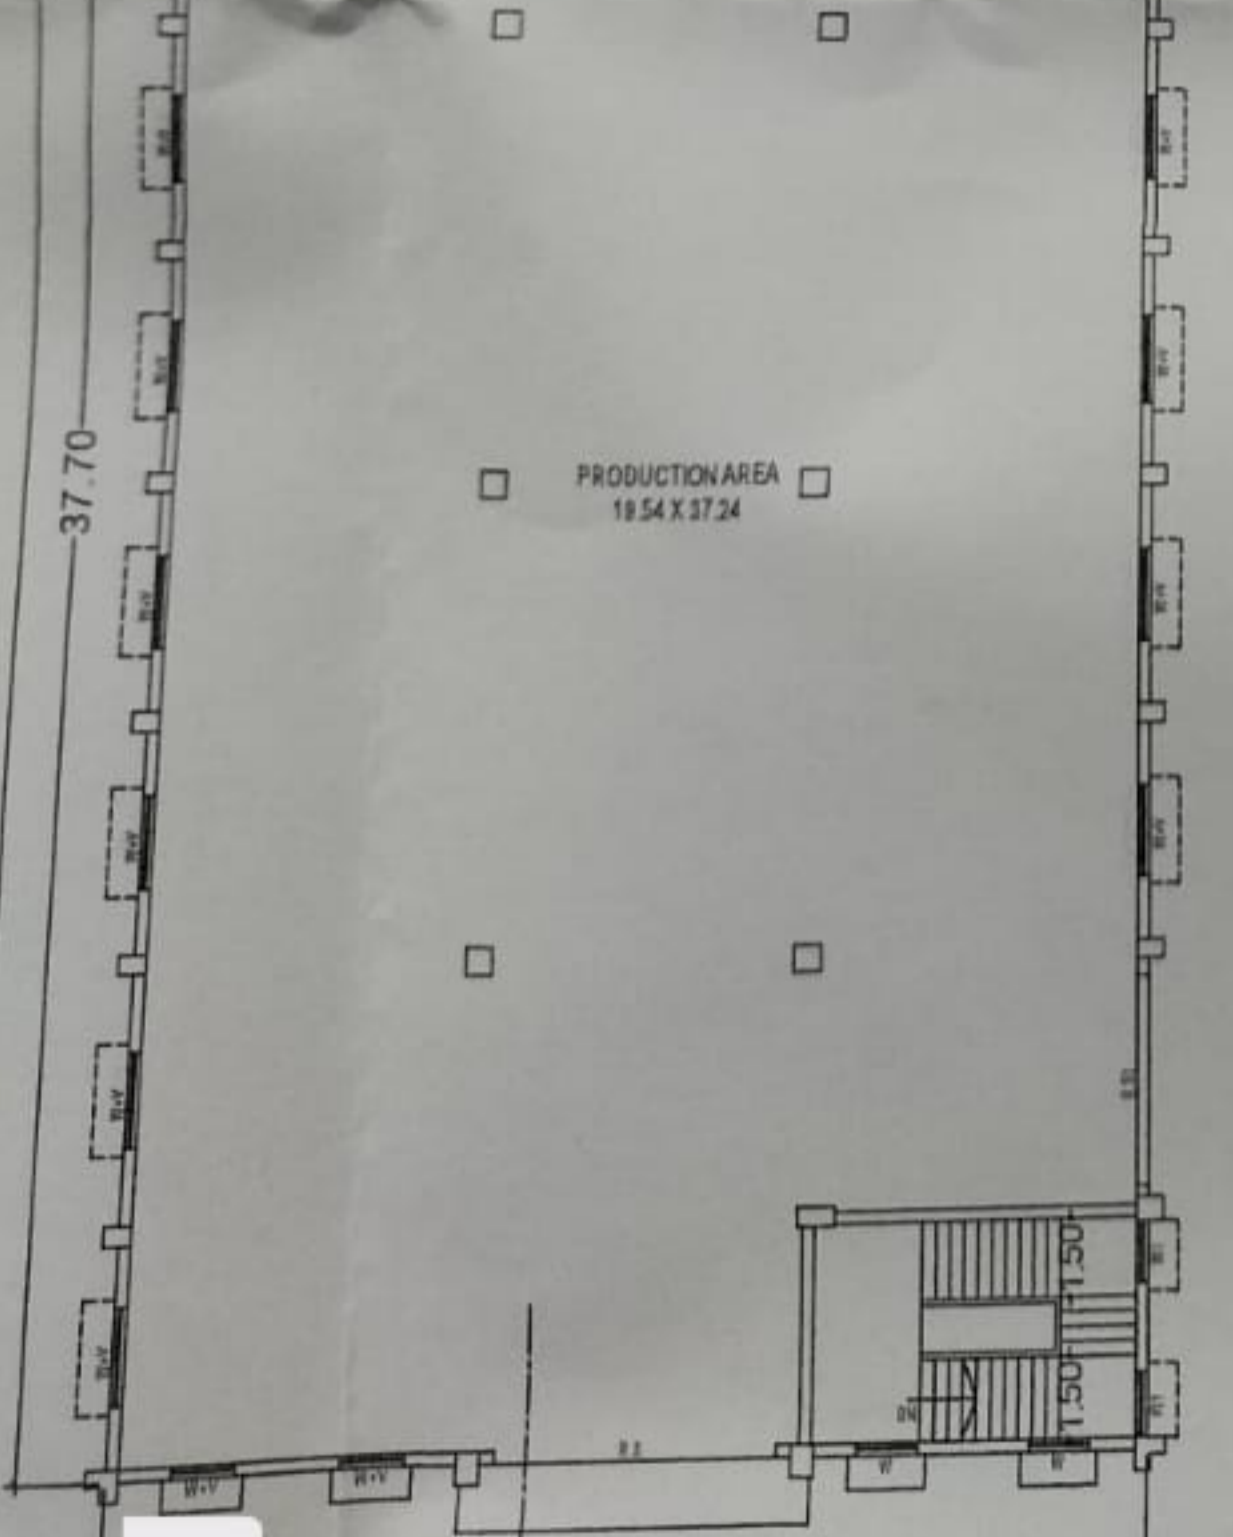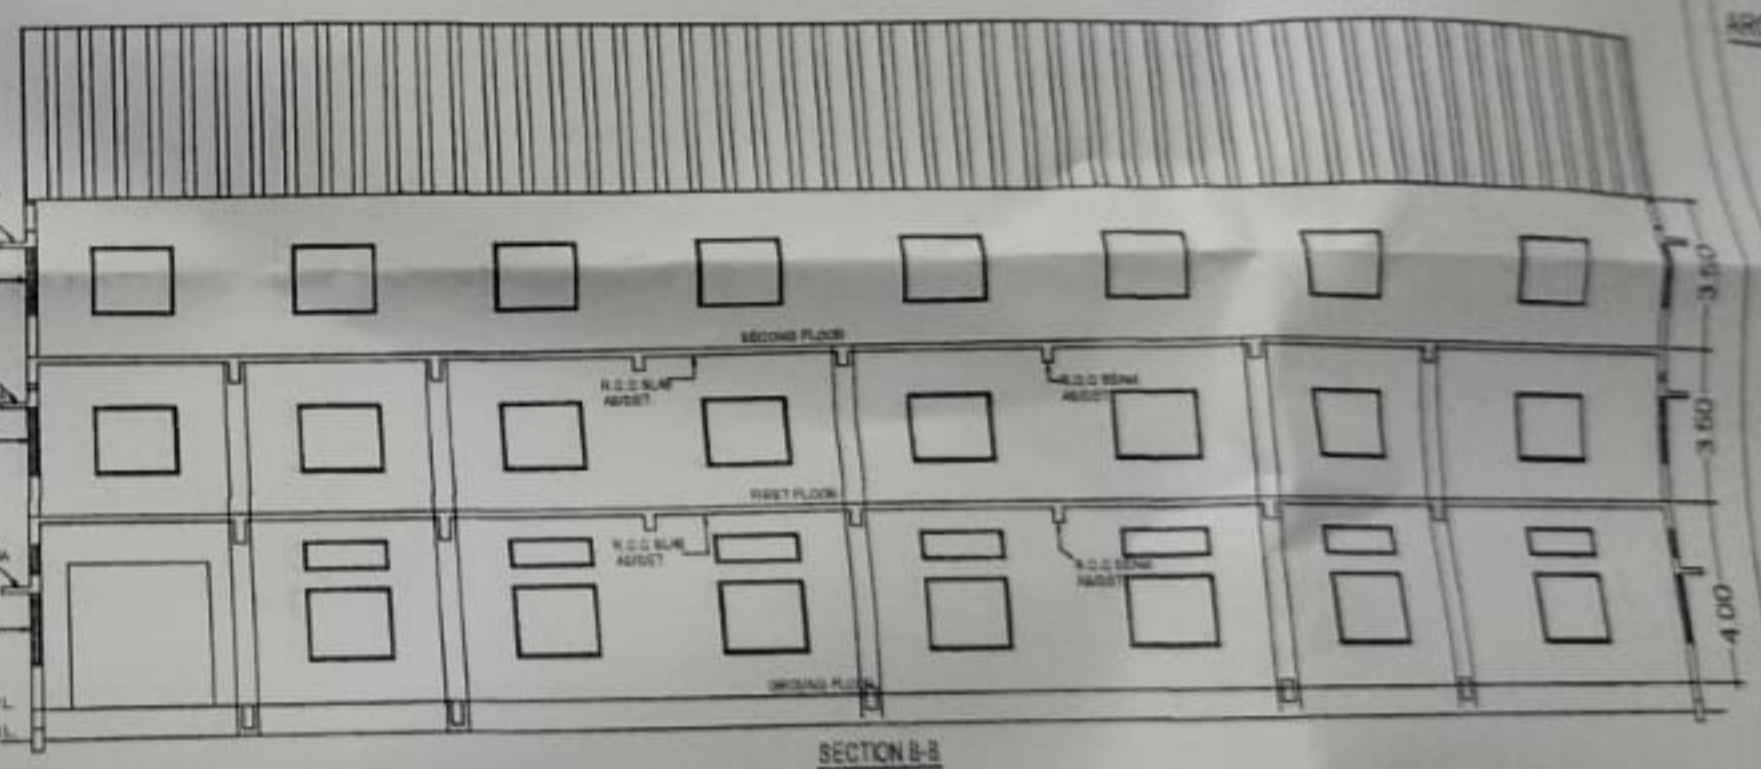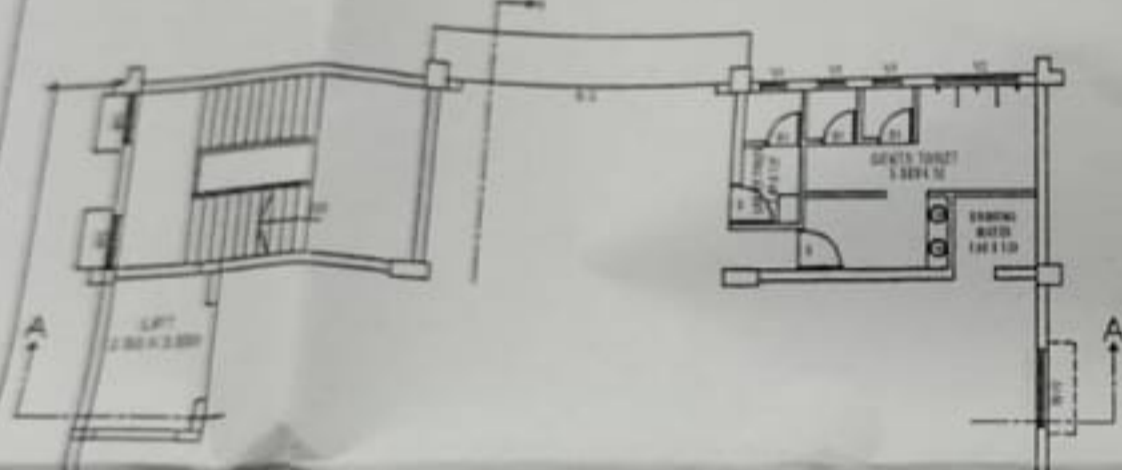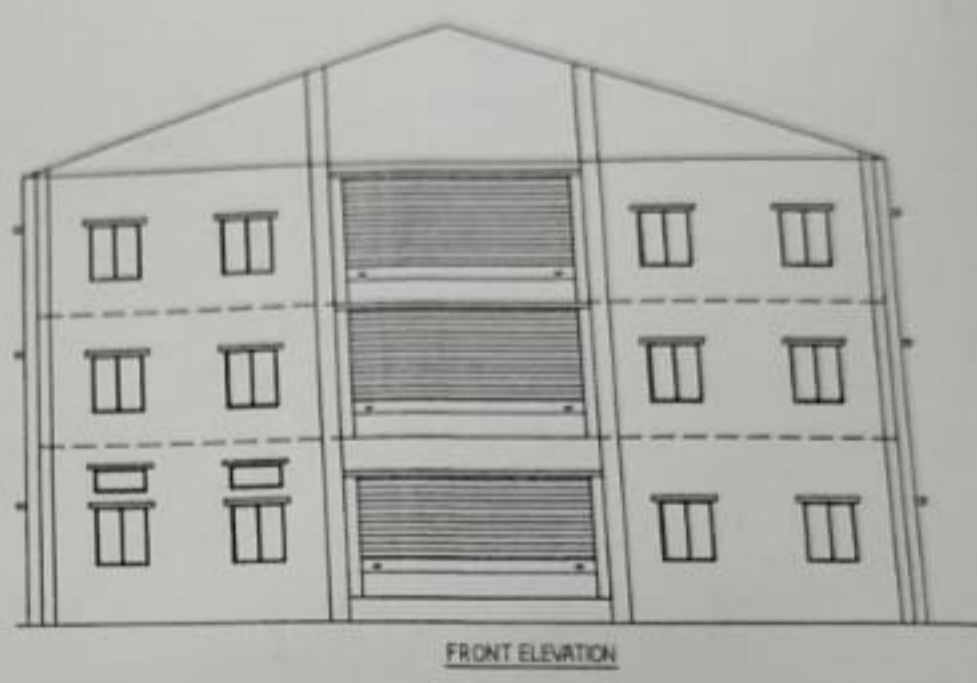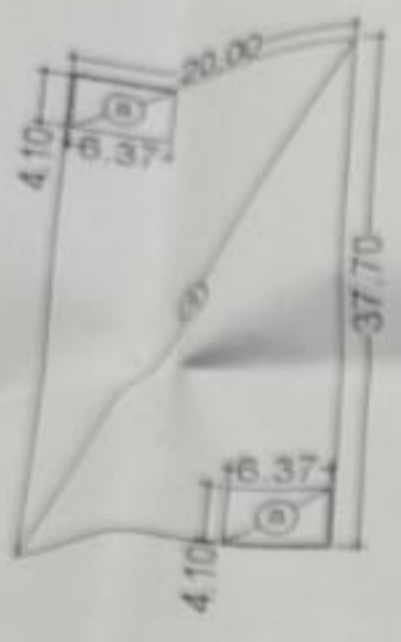

OPPO A74 5G
 TYPICAL FLOOR PLAN
 GROUND, FIRST, SECOND

SCALE 1:100
 TITLE SHEET
 TYPES OF
 LICENSING
 ENGINEERING
 STRUCTURAL
 ARCHITECTURE

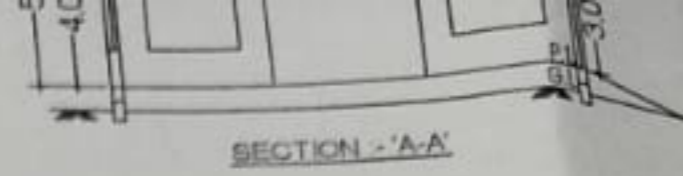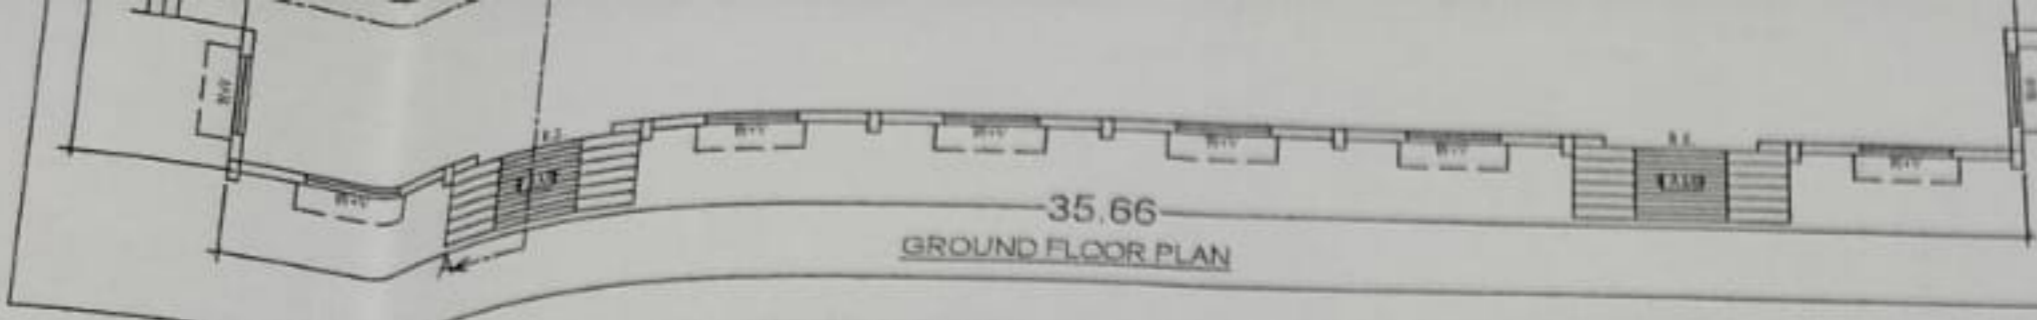

BLDG-D

GROUND, FIRST & SECOND FLOOR - APPROVED AREA

AREA CALCULATION :

(A) $20.00 \times 37.70 = 754.00 \text{ Sq.mt.}$

PROP. B. UP AREA : 754.00 Sq.mt. ①




LESS AREA :

(a) $2 \times 06.37 \times 04.10 = 52.23 \text{ Sq.mt.}$

TOTAL AREA = 52.24 Sq.mt. ②


F.S.I AREA = (1-2) = $754.00 - 52.24 \text{ Sq.mt.}$
= 701.76 Sq.mt.

F.S.I AREA = 701.76 Sq.mt.

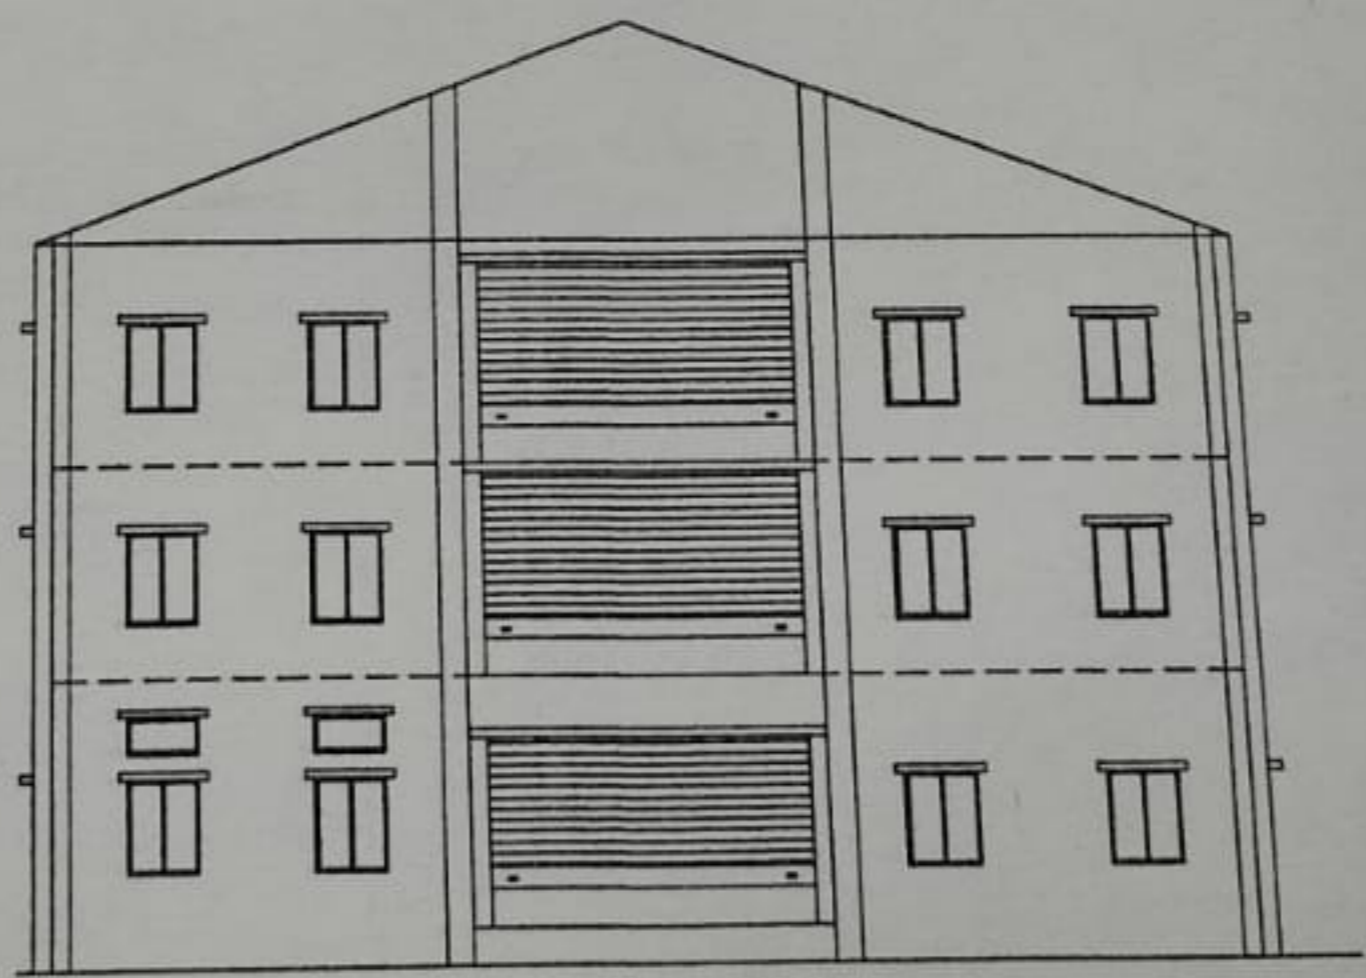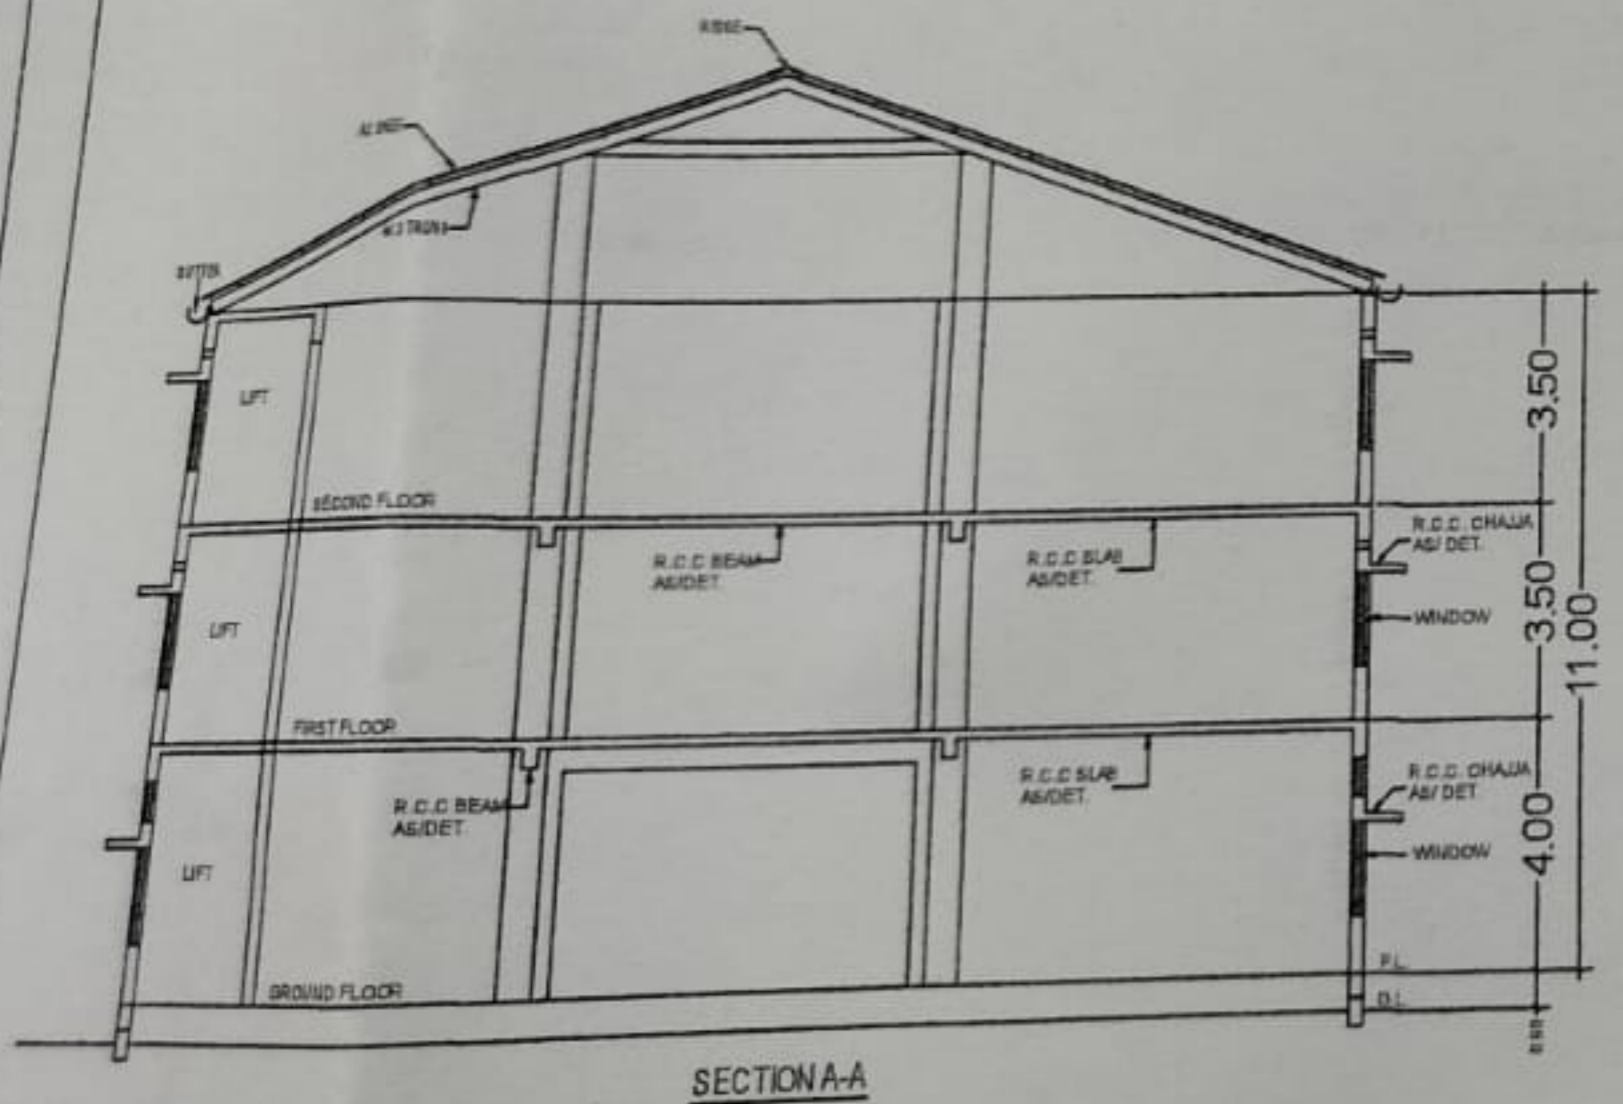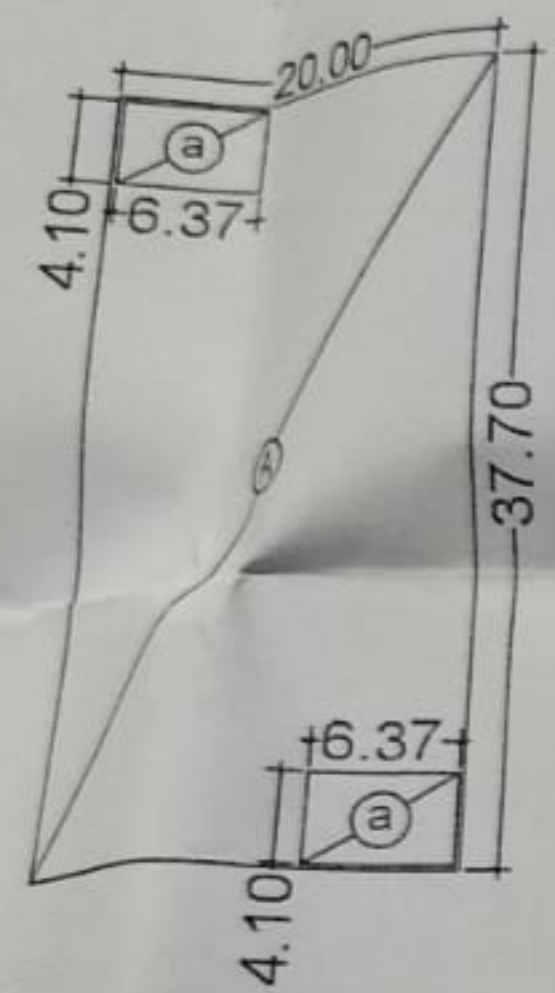

SYMBOL	DESCRIPTION	SIZE
W	WINDOW	1.80 x 1.50
WI	WINDOW	1.20 x 1.20
V	VENTILATION	1.80 x 0.60
V1	VENTILATION	0.60 x 0.60
D	DOOR	0.90 x 2.40
D1	DOOR	0.75 x 2.10
R.S	ROLLING SHUTTER	3.00 x 4.00

- COLOUR NOTE**
1. PLOT BOUNDARY
 2. APPROVED BUILDING
 3. NON-APPROVED BUILDING
 4. VIOLATED BUILDING
 5. COP SPECIFIED
 6. PARKING AREA
 7. TREE SPECIFIED

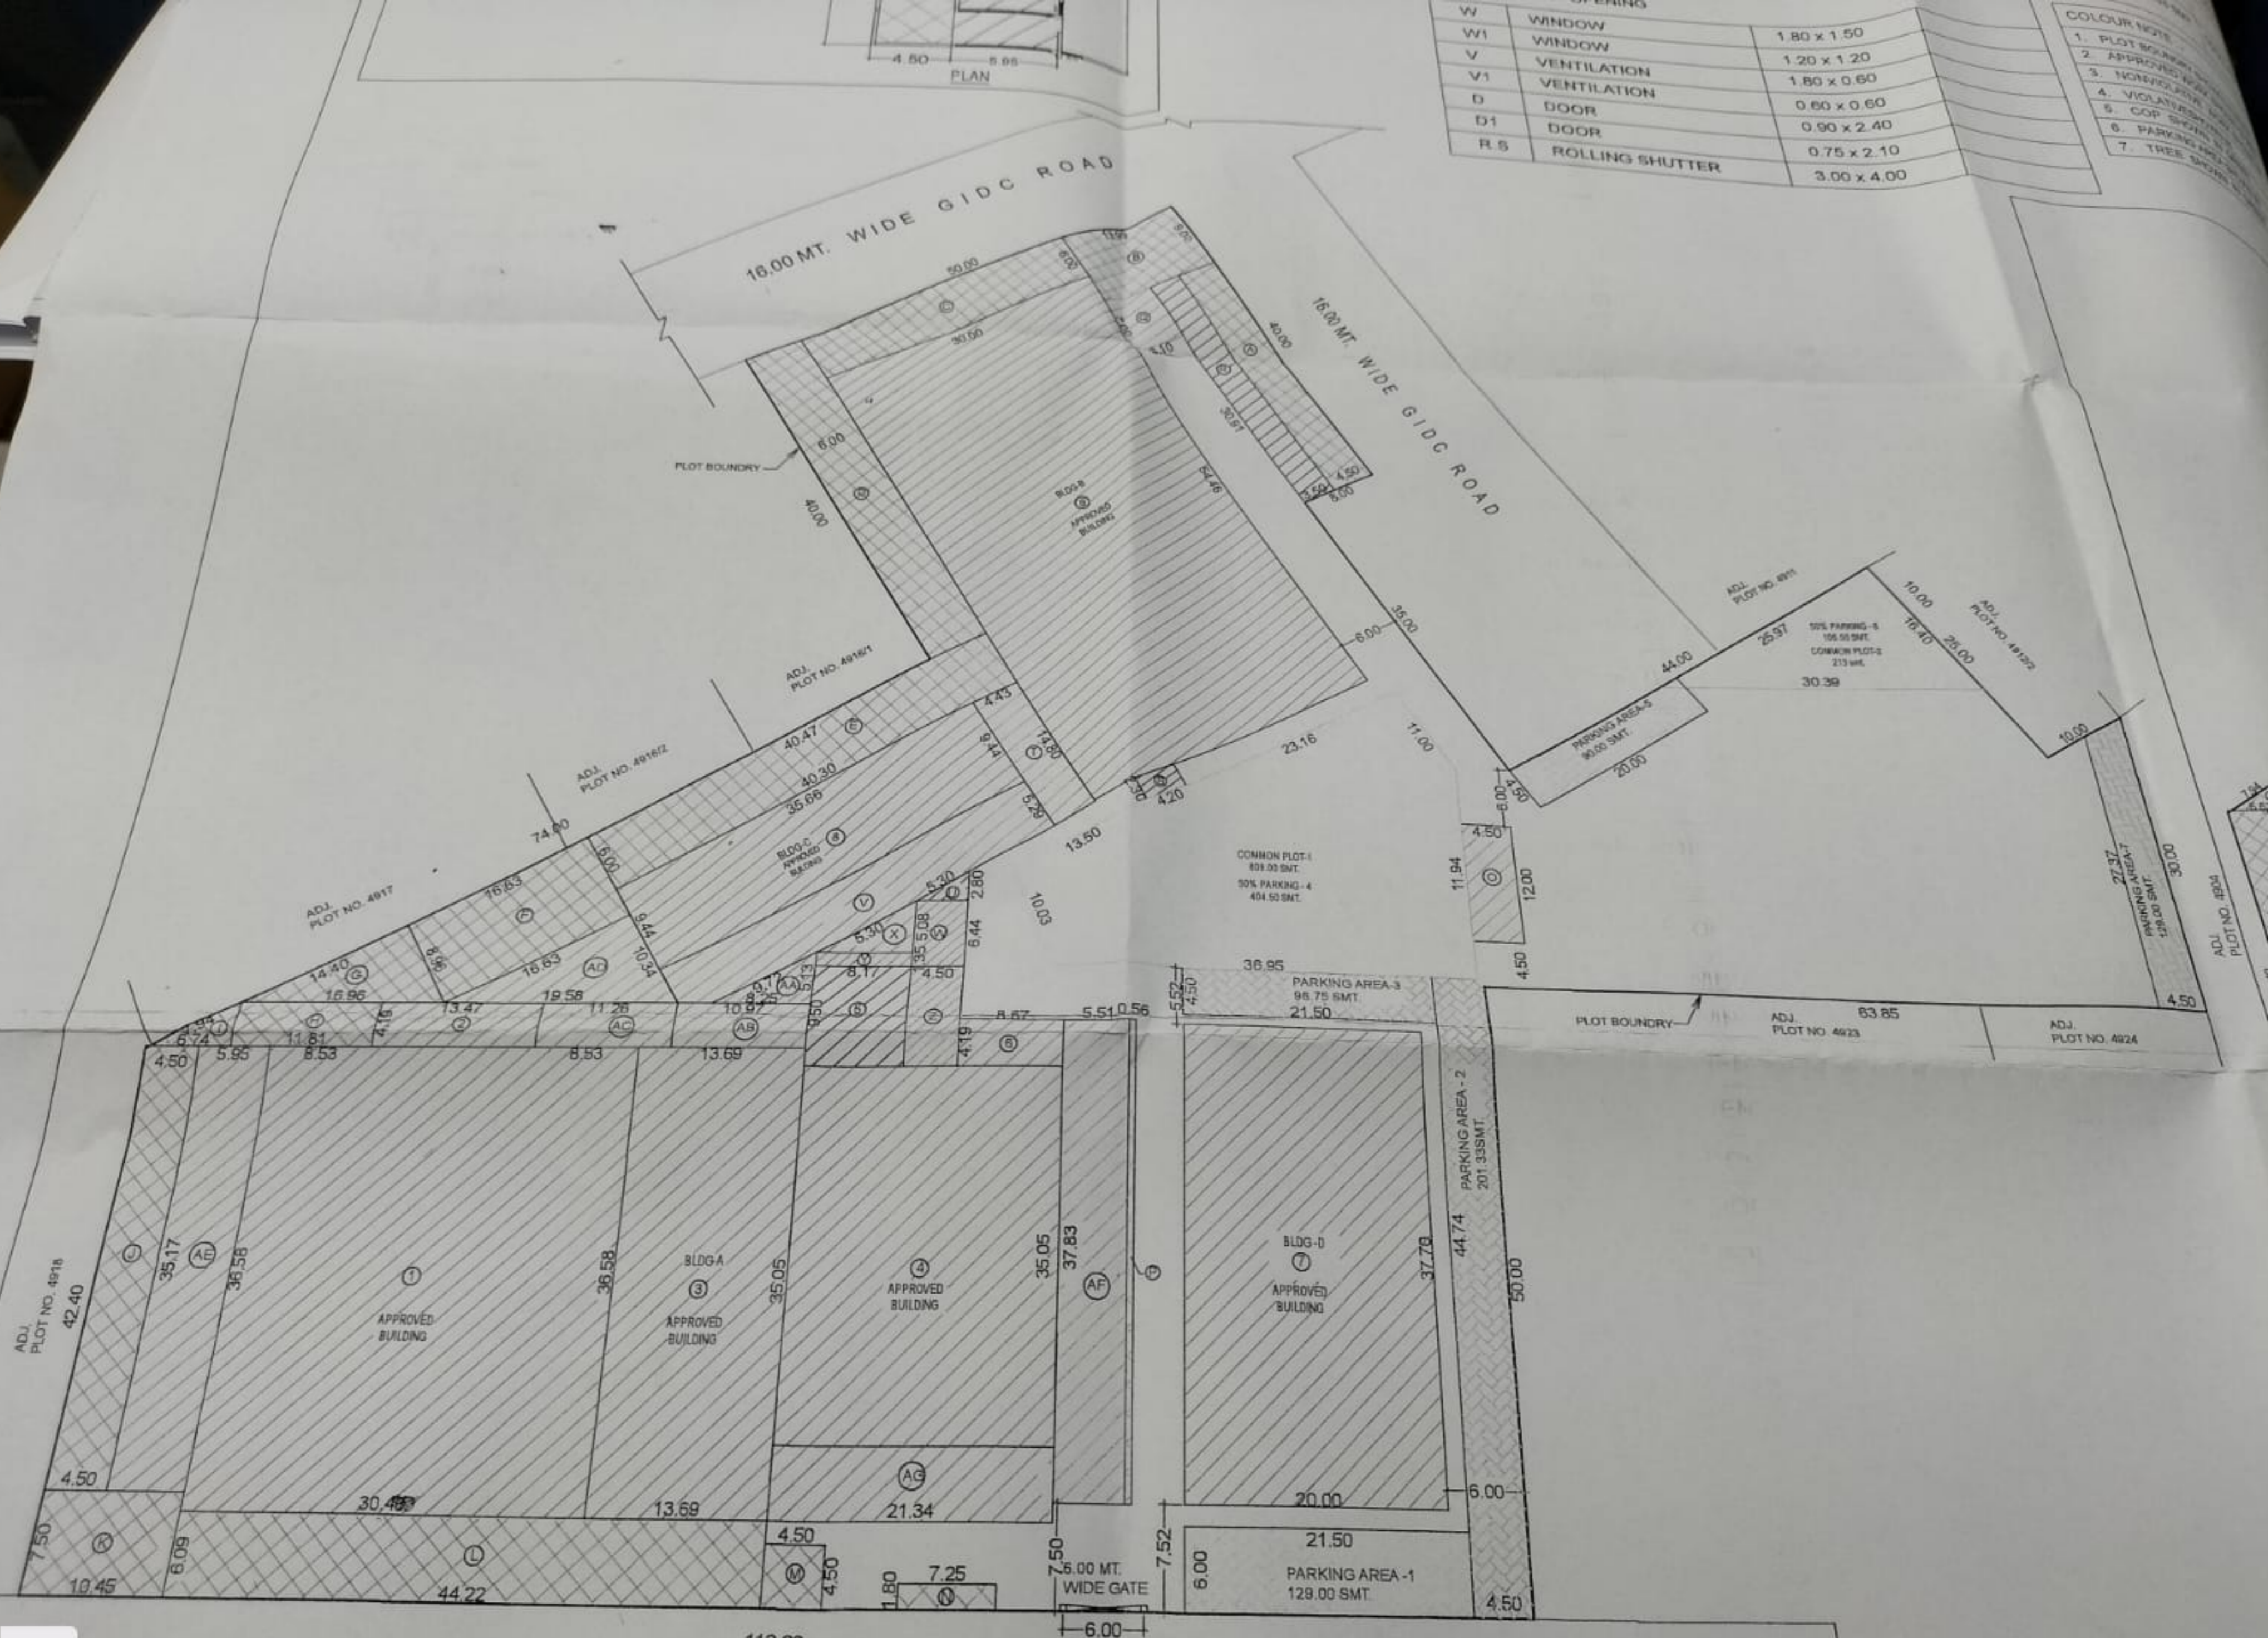


 **OPPO A74 5G**

16.00 MT. WIDE GIDC ROAD

COMMON PLOT-1
809.00 SMT.
50% PARKING - 4
404.50 SMT.

PLOT BO

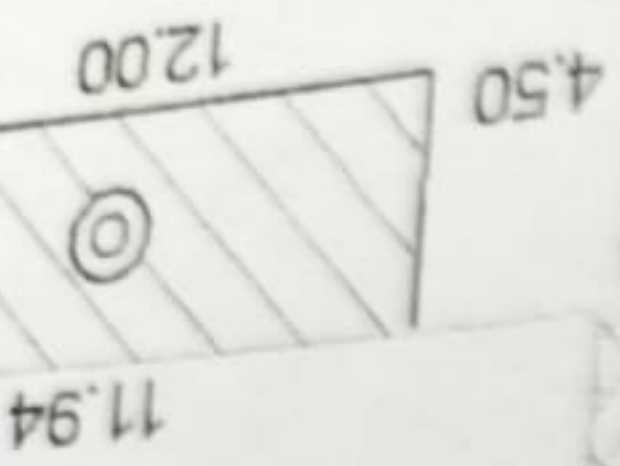

4.50

50.00

PARKING AREA - 2
201.33 SMT.

44.74


6.00

4.50

PARKING AREA-3
96.75 SMT.

21.50

36.95

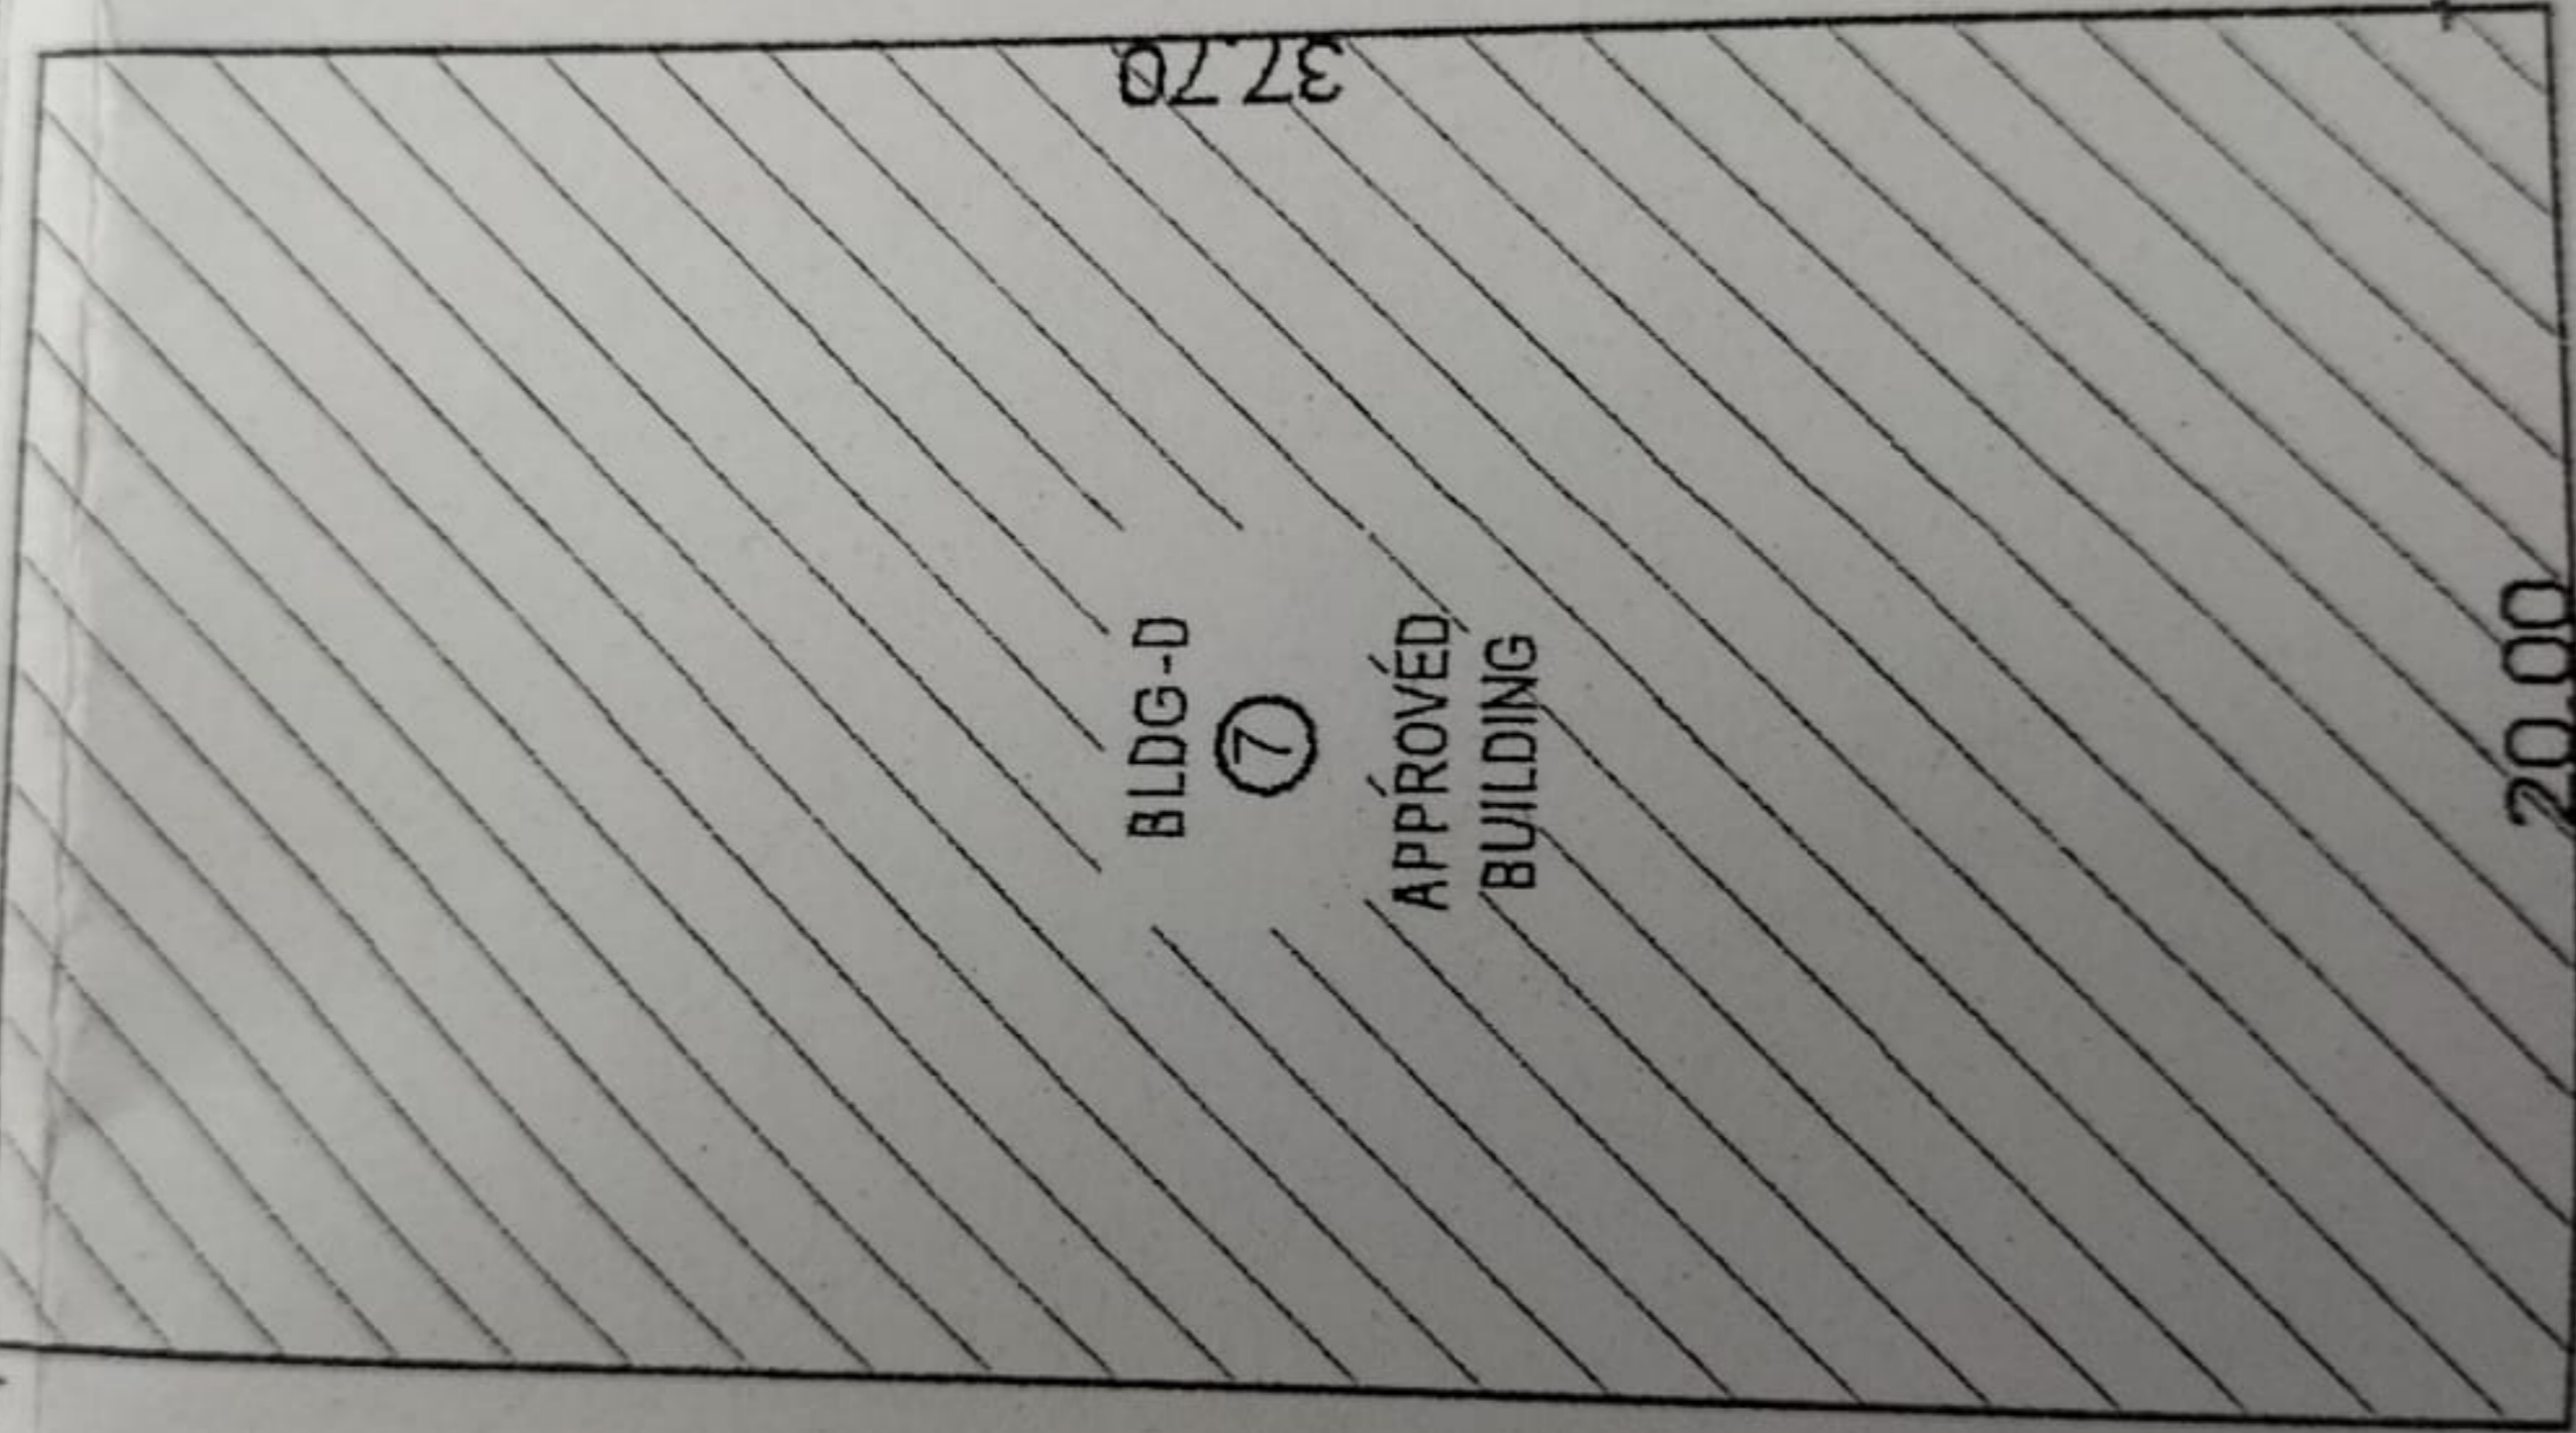

BLDG-D

7

APPROVED
BUILDING

37.70

20.00

5.52

PARKING AREA - 1
129.00 SMT.

21.50


6.00

7.52

10.03

OPPO A74 5G

5.51

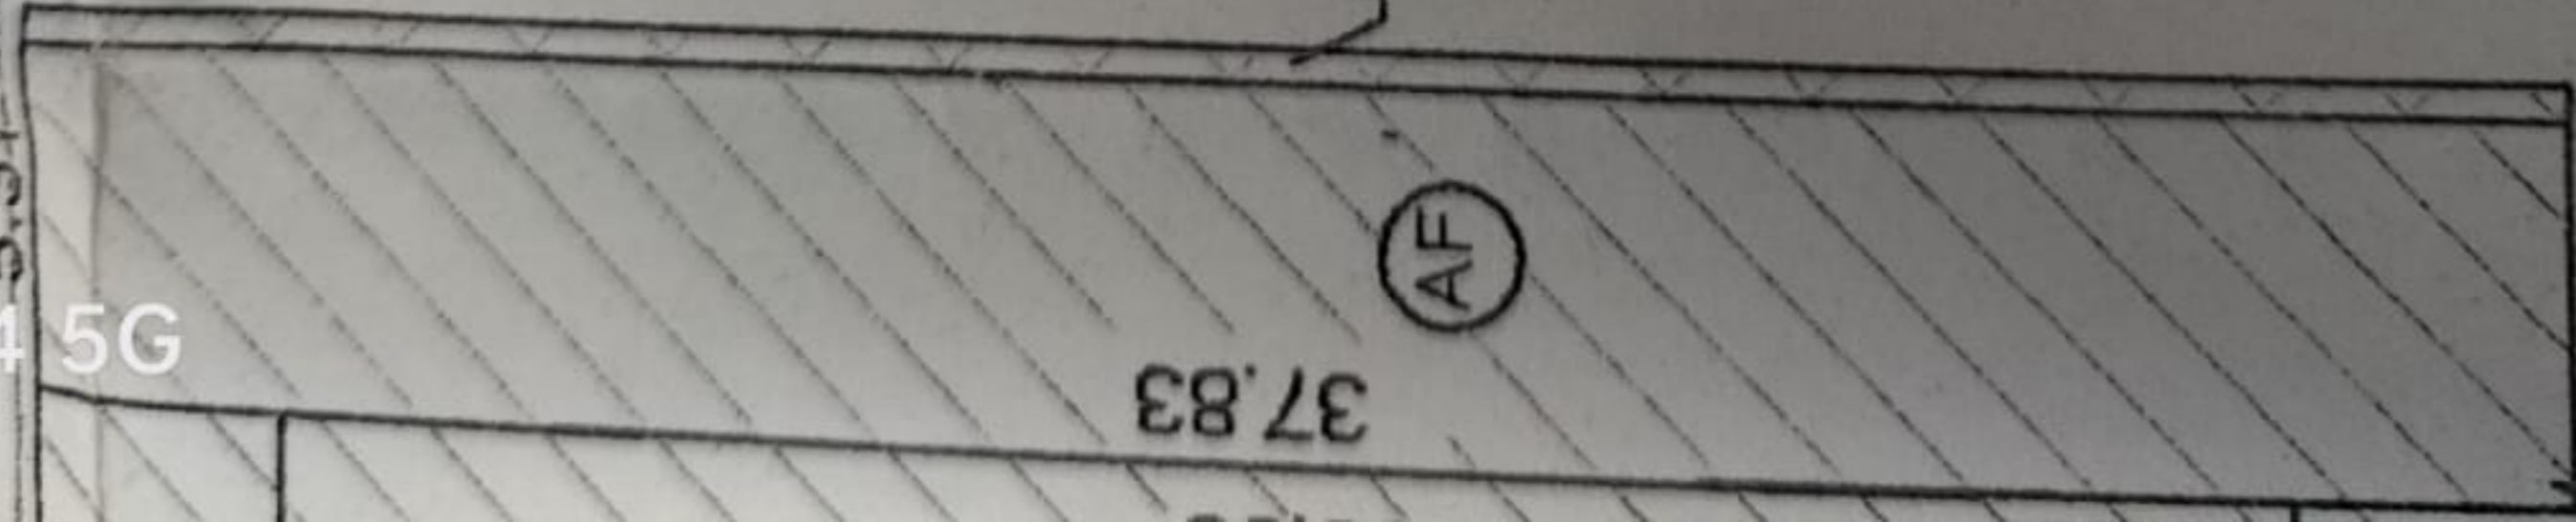

37.83

AF

P

6.00 MT.
WIDE GATE

6.00

STAMP OF APPROVAL

SHEET - 1/2

APPROVED SUBJECT TO THE CONDITION
STIPULATED UNDER THIS OFFICE LETTER
NO. GIDC / XEN / VPI / ADM / 55.
DT 20.11.24, WHICH IS ATTACHED
HEREWITH

D. D. D.
EXECUTIVE ENGINEER
G.I.D.C., VAPI.

NORTH :-




SQ. MT.

AREA STATEMENT :-

TOTAL AREA OF THE PLOT	12561.55
REQUIRED COMMON PLOT (8% OF PLOT AREA)	1004.93
PROVIDED COMMON PLOT (809.00 + 213.00 = 1022.00)	1022.00
PERMISSIBLE F.S.I. 1.00	12561.55
PERMISSIBLE IMPACT SCHEME F.S.I. 1.33	16706.86

NORTH:-

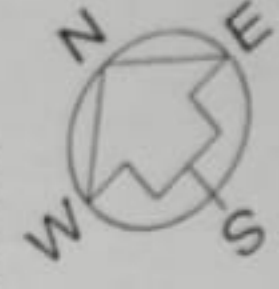

AREA STATEMENT :-

	SQ. MT.
- TOTAL AREA OF THE PLOT	12561.55
- REQUIRED COMMON PLOT (8% OF PLOT AREA)	1004.93
- PROVIDED COMMON PLOT (809.00 + 213.00 = 1022.00)	1022.00
- PERMISSIBLE F.S.I. 1.00	12561.55
- PERMISSIBLE IMPACT SCHEME F.S.I. 1.33	16706.86
- TOTAL GROUND COV.	6455.11
- GROUND COV. (APPROVED+NONVIOLATIVE)	1764.18
- GROUND COV. (VIOLATIVE)	8219.29

- BUILTUP AREA STATEMENT	8219.29
- APPROVED AREA	8400.32
- NON VIOLATIVE AREA	1311.83
- VIOLATIVE AREA	1764.18
	11476.33

- NON FSI AREA	252.00
- FSI AREA = (11476.33-252.00)	11224.33
- TOTAL F.S.I. AREA (G.F. + F.F. + S.F.)	11224.33
- F.S.I. CONSUMED = 11224.33/ 12561.55	0.89

PARKING AREA STATEMENT :-

-REQUIRED PARKING AREA (10% BUILTUP AREA)	1147.63
-PROVIDED PARKING AREA	
- PARKING AREA-1	129.00
- PARKING AREA-2	201.33
- PARKING AREA-3	96.75
- PARKING AREA-4	404.50
- PARKING AREA-5	90.00
- PARKING AREA-6	106.50
- PARKING AREA-7	129.00

PROVIDED PARKING AREA TOTAL = 1157.08

TREE PLANTATION :-

-REQUIRED TREE AS PER NORMS	314.00 NOS.
-PROVIDED TREE	17.00 NOS.


TITLE : SECTION,ELEVATION,AREA CALCULATION & SITE PLAN

TYPES OF PLOT :- INDUSTRIAL


LICENSE NO.

ENGINEER : REG. NO. GIDC/ATP/EOR/035

STRUCTURAL ENGINEER : REG. NO. GIDC/ATP/SEOR/037

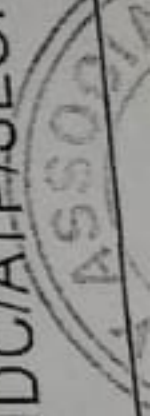


OPPO A74 5G

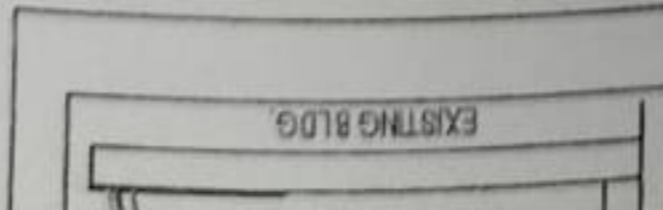

AD

30.00

SCHEDULE OF OPENING	
W	WINDOW
W1	WINDOW
V	VENTILATION
V1	VENTILATION
D	DOOR
D1	DOOR
R.S	ROLLING SHUTTER

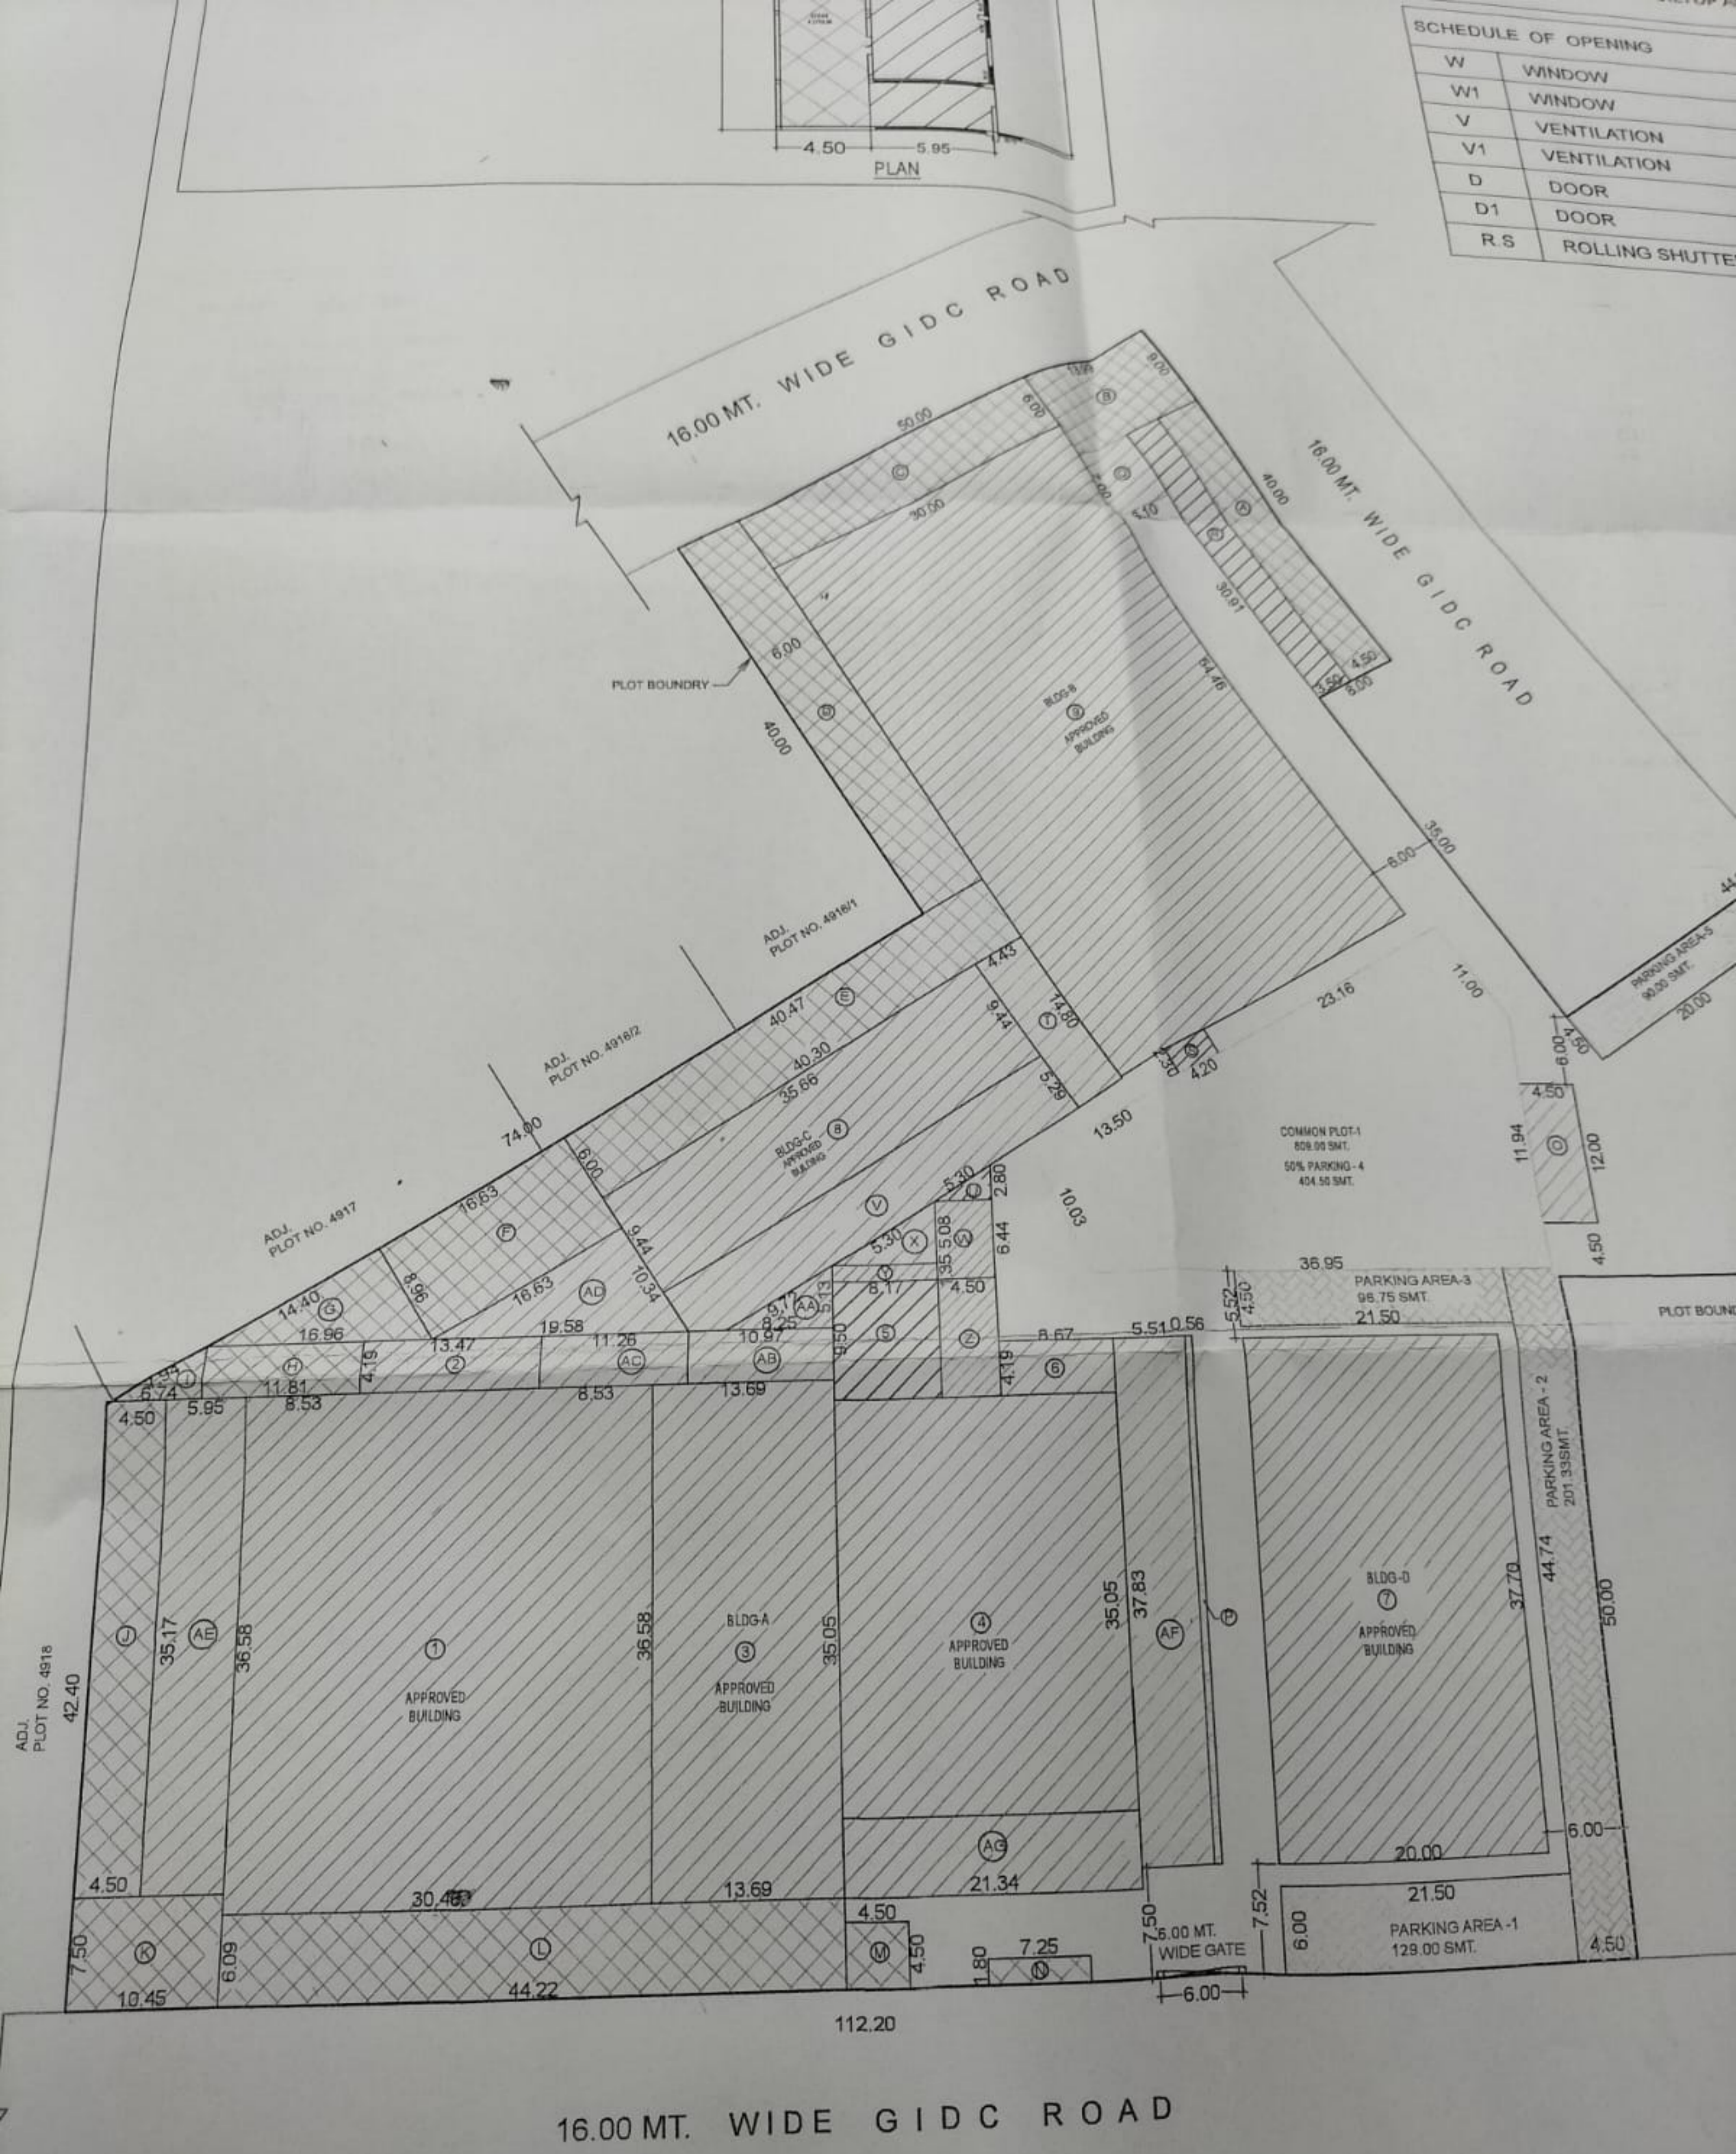


OPPO A74 5G

LAYOUT PLAN

SCALE 1:200



OPPO A74 5G

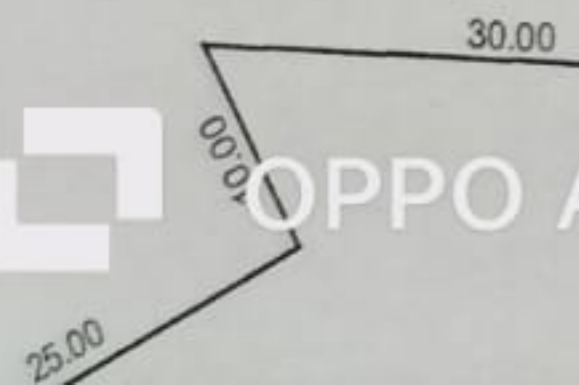

- PARKING AREA-1 129.00
- PARKING AREA-2 201.33
- PARKING AREA-3 96.75
- PARKING AREA-4 404.50
- PARKING AREA-5 90.00
- PARKING AREA-6 106.50
- PARKING AREA-7 129.00

PROVIDED PARKING AREA TOTAL = 1157.08

TREE PLANTATION :-

- REQUIRED TREE AS PER NORMS
- PROVIDED TREE

314.00 NOS.
17.00 NOS.

TITLE : SECTION,ELEVATION,AREA CALCULATION & SITE PLAN

TYPES OF PLOT :- INDUSTRIAL

LICENSE NO.

ENGINEER : REG. NO. GIDC/ATP/EOR/035

STRUCTURAL ENGINEER : REG. NO. GIDC/ATP/SEOR/037

ARCHITECT / ENGINEER SIGN. :-



MISTRY ASSOCIATES
CONSULTING ENGINEER
ARCHITECTURAL &
STRUCTURAL
DESIGNER

NIKUNJ I. MISTRY
(B.E. Civil, MIE)
REG. NO. M-1562163

203, RIDDHISIDHI CHAMBER
NEAR INDIAN BANK
G.I.D.C. CHAR RASTA
VAPI - 396 195 , GUJARAT.
Mob:- 09825512075 / 09825512975
E Mail : mistry_associates@yahoo.co.in

OWNER SIGN. :-

For Techno Tarp & Polymers Pvt. Ltd.

Authorised Signatory

VIOLITIVE AND NON VIOLATIVE PLAN FOR THE
FACTORY BUILDING ON PLOT NO. 4912/1,
4913,4914,4915,4920,4921,4922
AT G.I.D.C SARIGAM

FOR, M/S TECHNO TARP & POLYMERS PVT LTD.








ST FLOOR

24 Sq.Mt

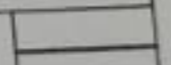STAMP OF A

AREA CALCULATION												
BUILT UP AREA DESCRIPTION	BUILT UP AREA CALCULATION											
	APPROVED AREA			NON VIOLATIVE AREA			VIOLATIVE AREA			NON FSI AREA		
	GROUND FLOOR	FIRST FLOOR	SECOND FLOOR	GROUND FLOOR	FIRST FLOOR	SECOND FLOOR	GROUND FLOOR	FIRST FLOOR	SECOND FLOOR	GROUND FLOOR	FIRST FLOOR	SECOND FLOOR
BUILDING-A	2534.09			1196.59	115.24		1764.18			13.28	13.28	
BUILDING-B	1633.80	1633.80								34.36	34.36	
BUILDING-C	336.63									52.24	52.24	52.24
BUILDING-D	754.00	754.00	754.00							99.88	99.88	52.24
TOTAL AREA	5258.52	2387.80	754.00	1196.59	115.24		1764.18					
TOTAL	8400.32			1311.83			1764.18			252.00		
TOTAL GROUND FLOOR BUILTUP AREA = 8219.29 SMT.				TOTAL BUILTUP AREA = 11476.33 SMT.				TOTAL FSI AREA = 11224.33 SMT.				

SCHEDULE OF OPENING			
W	WINDOW	1.80 x 1.50	
W1	WINDOW	1.20 x 1.20	
V	VENTILATION	1.80 x 0.60	
V1	VENTILATION	0.60 x 0.60	
D	DOOR	0.90 x 2.40	
D1	DOOR	0.75 x 2.10	
R.S	ROLLING SHUTTER	3.00 x 4.00	

COLOUR NOTE :-	
1. PLOT BOUNDRY SHOWN IN WHITE.	
2. APPROVED WORK SHOWN IN RED.	
3. NONVIOLATIVE WORK SHOWN IN	
4. VIOLATIVE SHOWN IN .	
5. COP SHOWN IN GREEN.	
6. PARKING AREA SHOWN IN	
7. TREE SHOWN IN GREEN	

LAST APPROVED PLAN AS ON LETTER NO. GIDC/XEN/VP/DB/PB/SRG/3127 DATED 23/01/2017





- PERMISSIBLE
- PERMISSIBLE I
- TOTAL GROUND
- GROUND COV.
- GROUND COV
- BUILTUP AREA

- TOTAL F.S.I. ARE
- F.S.I. CONSUM
- PARKING AREA(S)
- REQUIRED PRK
- PROVIDED PRK

TREE PLANTING
 -REQUIRED
 -PROVIDED
 TITLE : SEC
 TYPES OF
 LICENSE N
 ENGINEE
 STRUCTU
 ARCHIT

MIST
 CON
 ARC
 STR
 DE

- 5. COP SHOWN IN GREEN.
- 6. PARKING AREA SHOWN IN
- 7. TREE SHOWN IN GREEN

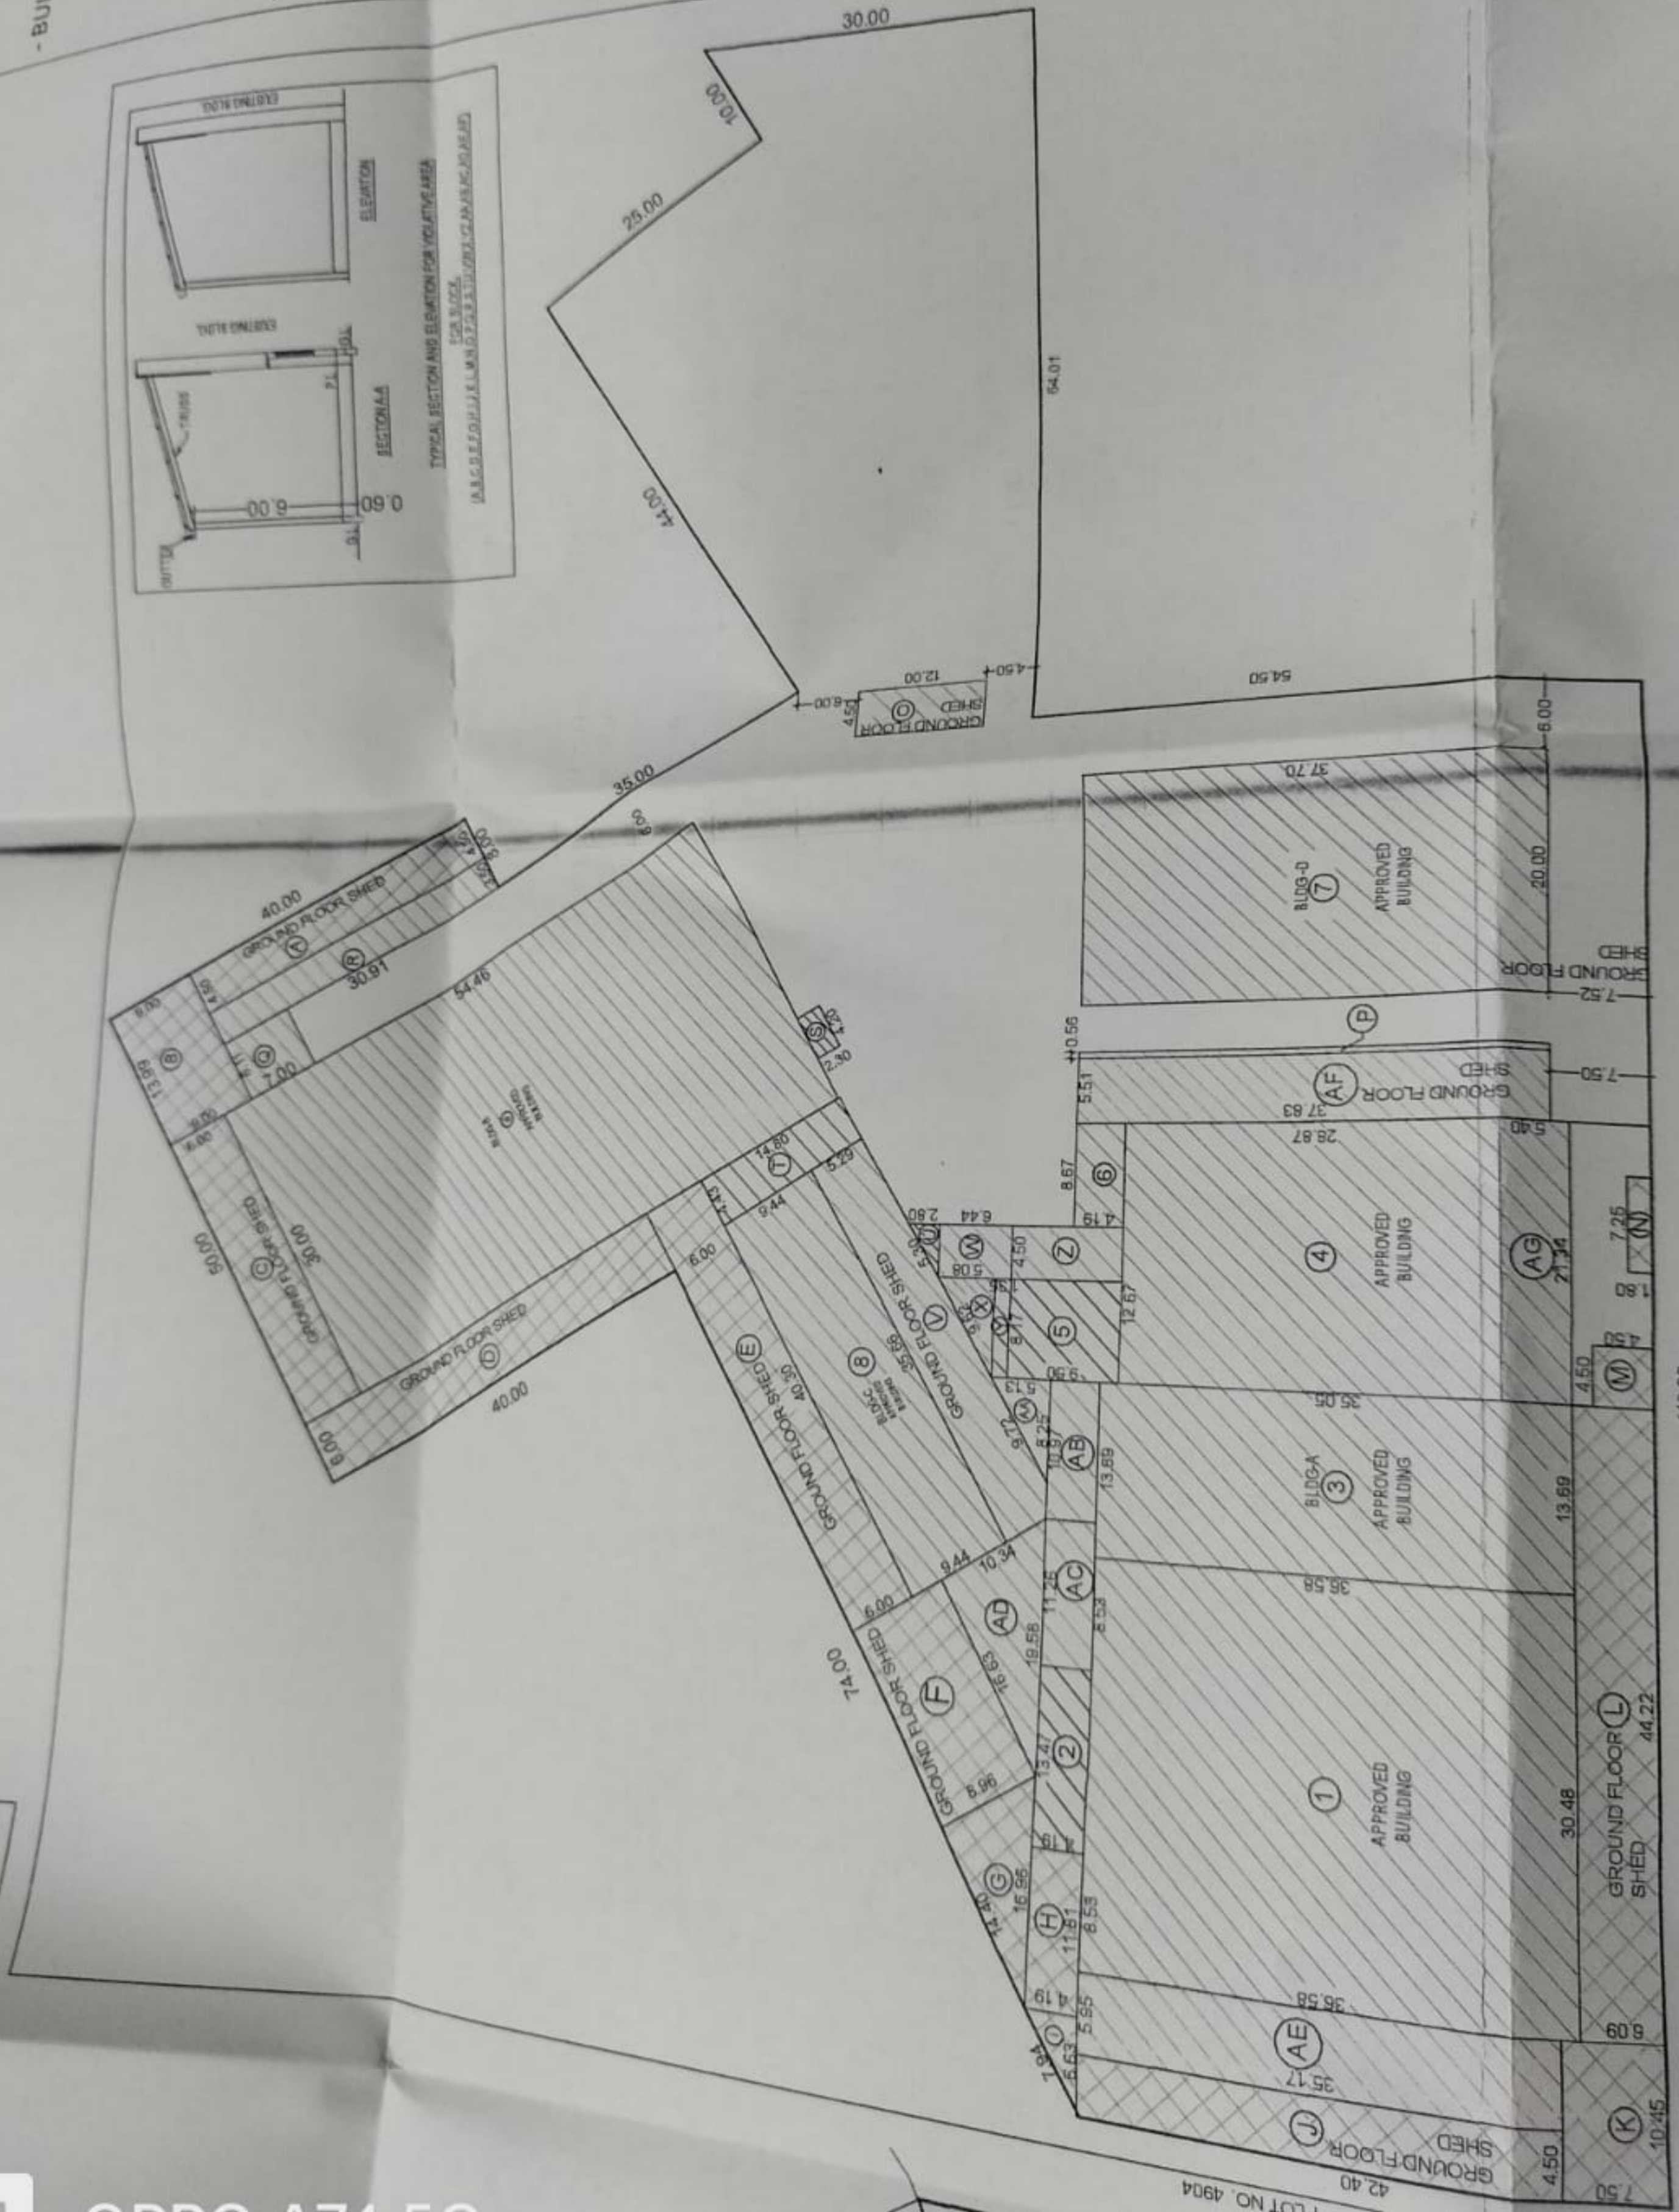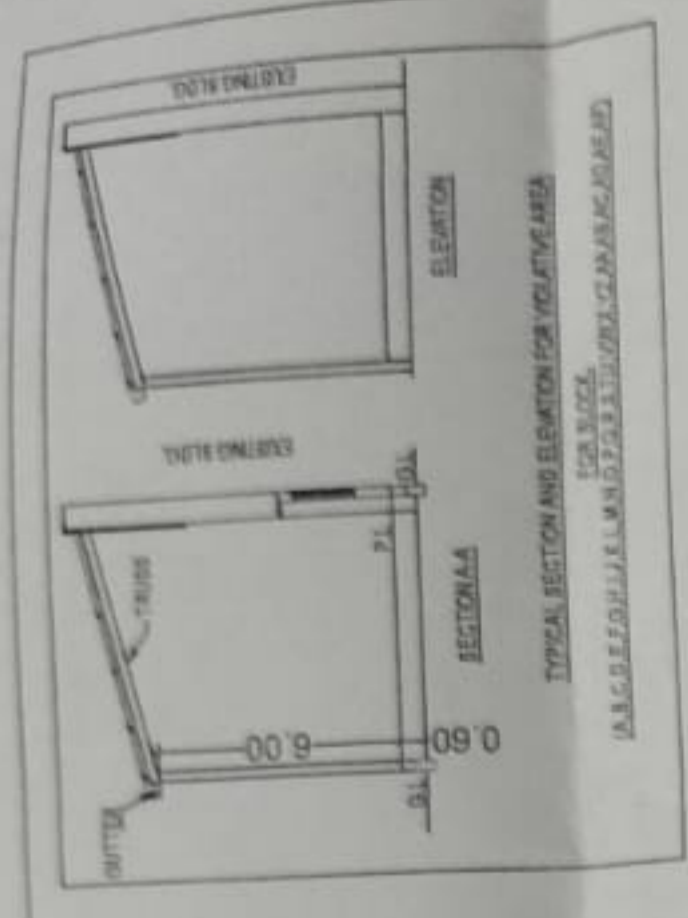

112.20

GROUND FLOOR PLAN FOR VIOLATIVE AND NON VIOLATIVE AREA

NON VIOLATIVE AREA - FIRST FLOOR

NON VIOLATIVE AREA - GROUND FLOOR

NON VIOLATIVE AREA - GROUND FLOOR

3.00 X 2.10
 3.00 X 4.00

OPPO A74 5G

72161

10.00

PARKING AREA-7
 129.00 SMT.
 ADJ. PLOT NO. 4904
 30.00

50

VIOLATIVE AREA - GROUND FLOOR

(A) $1.0 \times 04.50 \times 30.91 = 139.10 \text{ Sq.Mt}$
 (B) $1.0 \times 13.99 \times 09.00 = 125.91 \text{ Sq.Mt}$

GROUND FLOOR PLAN FOR VIOLATIVE AND NON VIOLATIVE AREA

NON VIOLATIVE AREA - GROUND FLOOR

(C) $1.0 \times 04.50 \times 12.00 = 54.00 \text{ Sq.Mt}$
 (Q) $1.0 \times 06.11 \times 07.00 = 42.77 \text{ Sq.Mt}$




7. TREE SHOWN IN GREEN

6. PARKING AREA SHOWN IN


5. COP SHOWN IN GREEN.



SCHEDULE OF OPENING	
W	WINDOW
W1	WINDOW
V	VENTILATION
V1	VENTILATION
D	DOOR
D1	DOOR
R.S	ROLLING SHUTTER

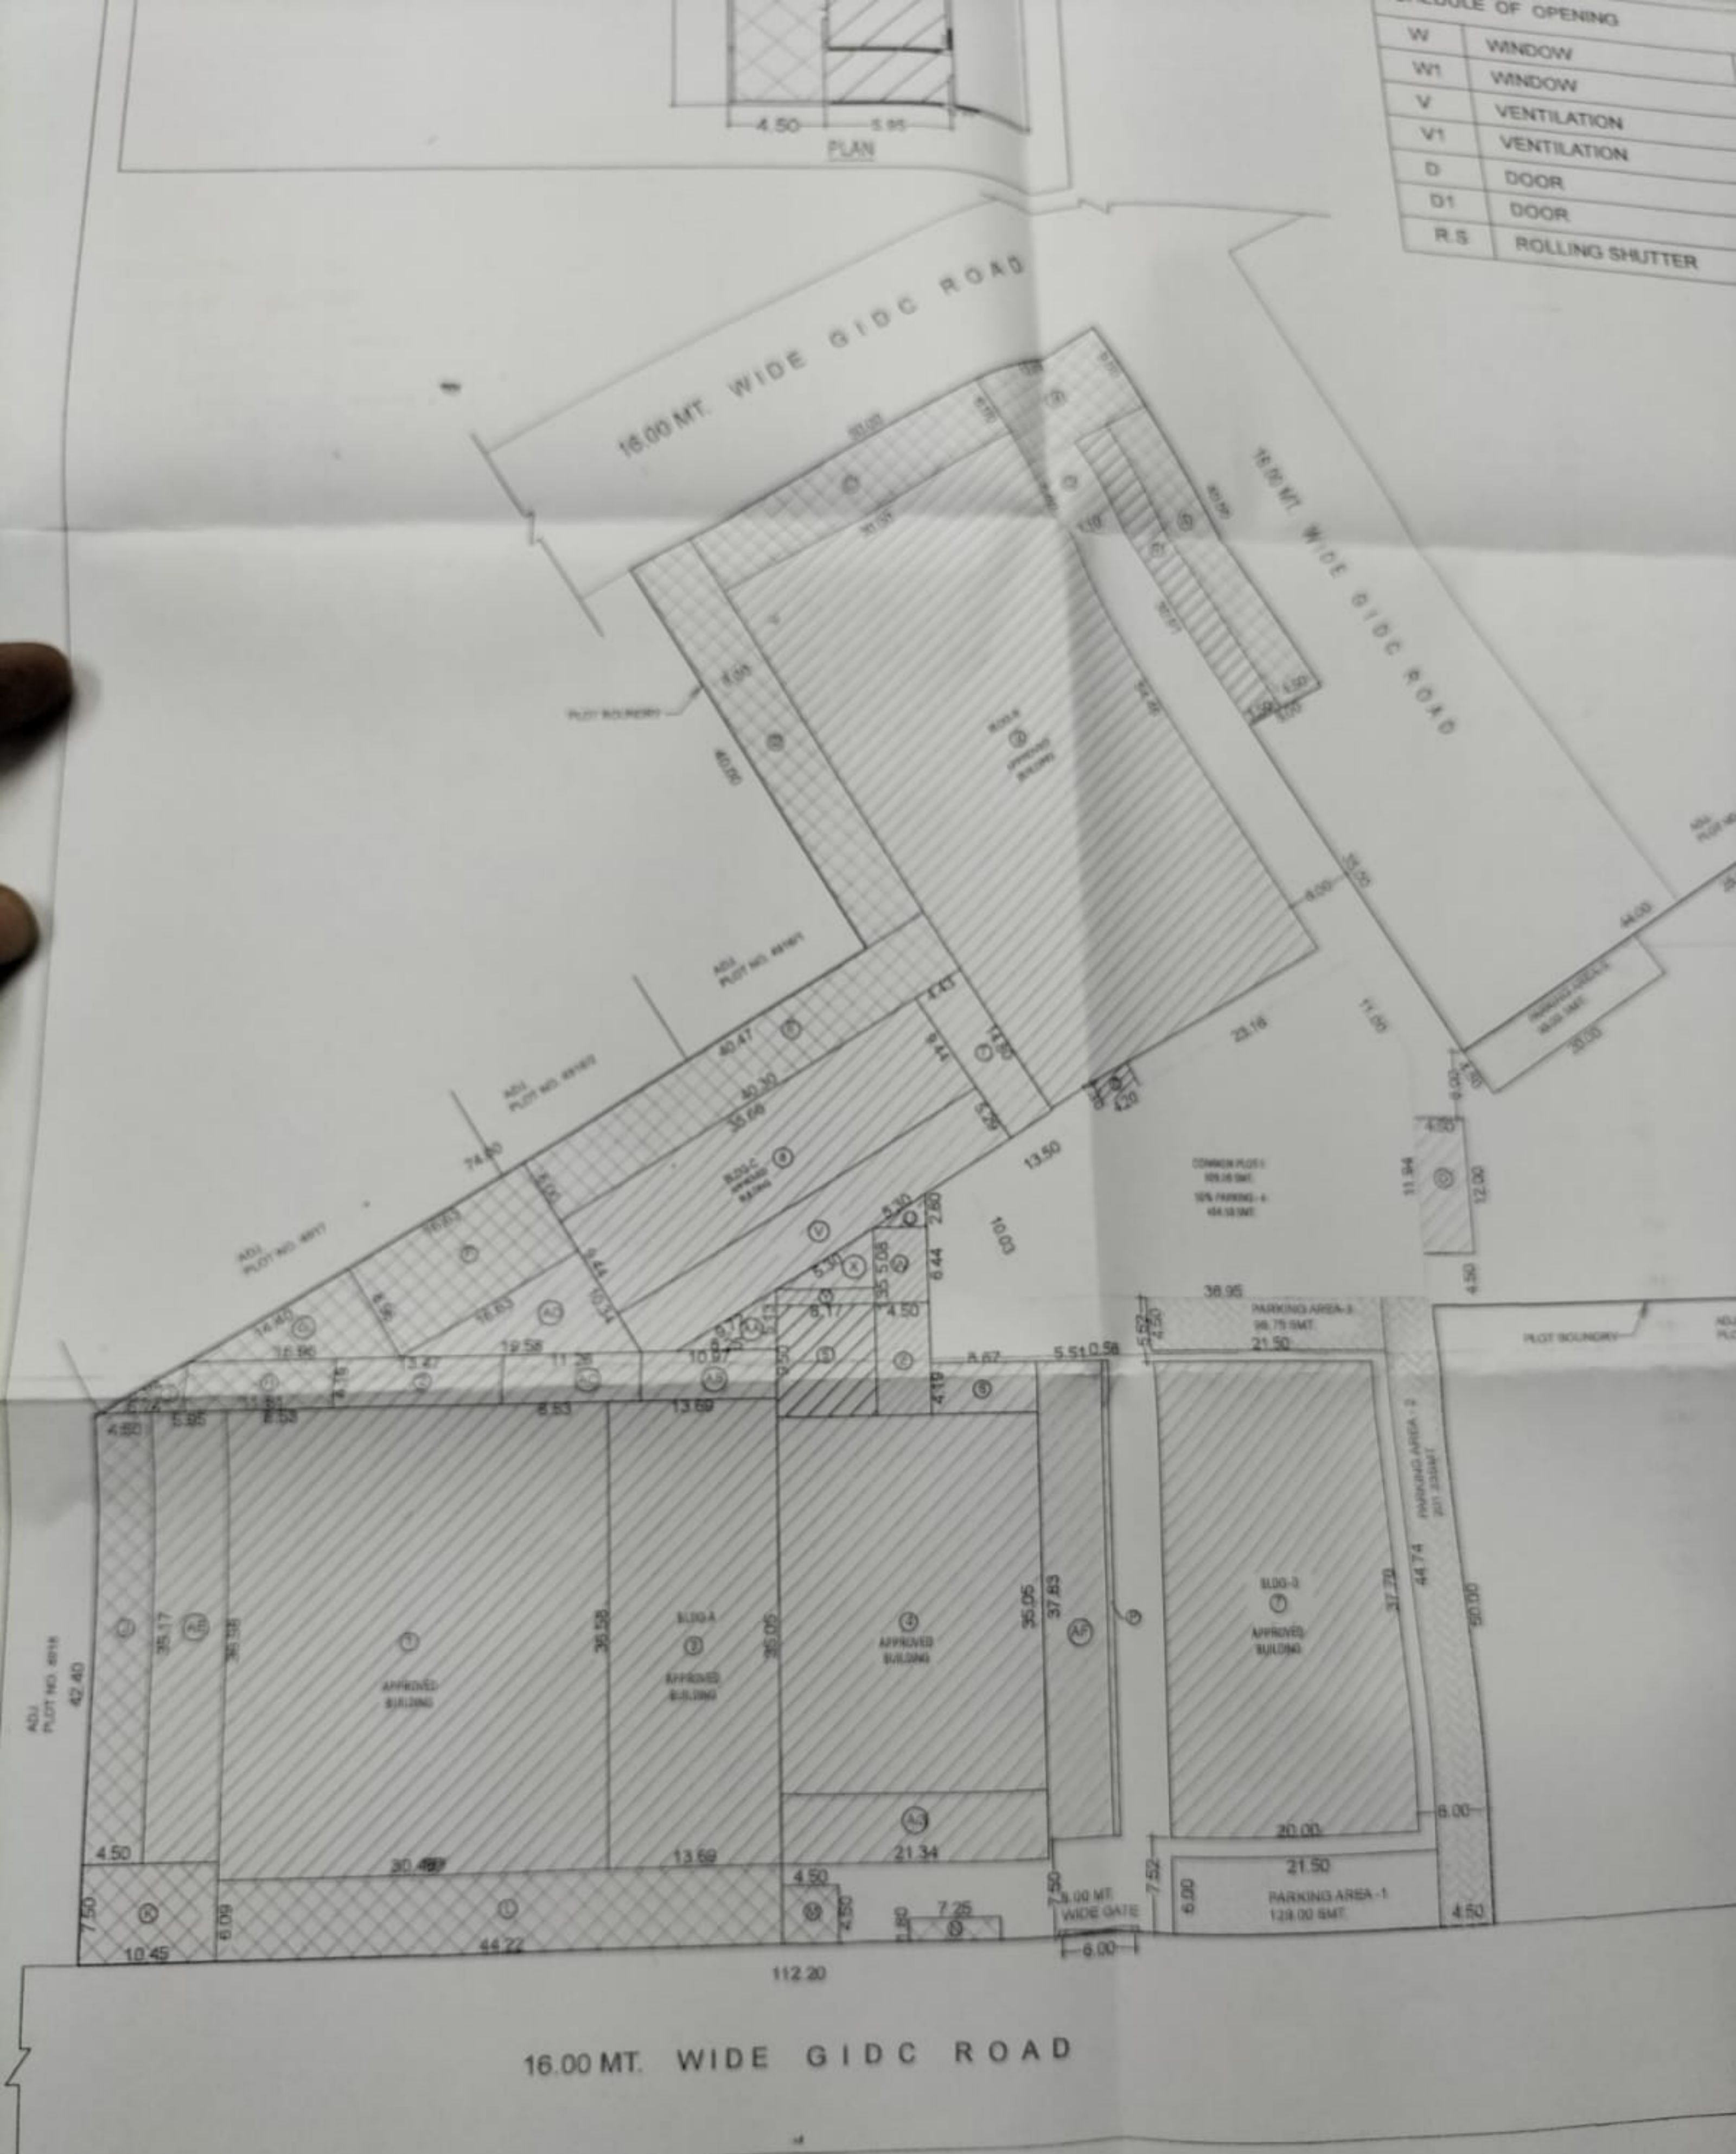

LAYOUT PLAN
SCALE 1: 200

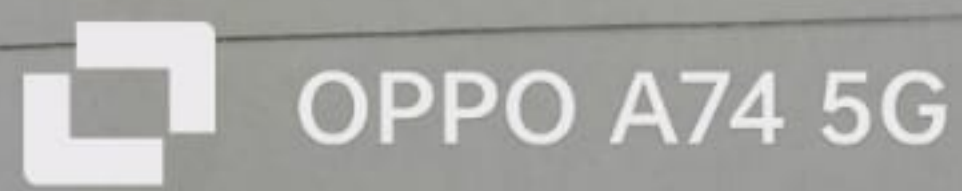



GROUND FLOOR PLAN FOR VIOLATIVE AND NON VIOLATIVE AREA

VIOLATIVE AREA - GROUND FLOOR

- (A) 1.0 x 04.50 x 30.91 = 139.10 Sq.Mt
- (B) 1.0 x 13.99 x 09.00 = 125.91 Sq.Mt
- (C) 1.0 x 30.00 x 06.00 = 180.00 Sq.Mt
- (D) 1.0 x 06.00 x 40.00 = 240.00 Sq.Mt
- (E) 1.0 x 40.30 x 06.00 = 241.80 Sq.Mt
- (F) 1.0 x 16.63 x 08.96 = 149.00 Sq.Mt
- (G) 0.5 x 08.96 x 14.40 = 64.51 Sq.Mt.
- (H) 1.0 x 11.81 x 04.19 = 49.48 Sq.Mt
- (I) 0.5 x 04.19 x 06.65 = 13.93 Sq.Mt
- (J) 1.0 x 04.50 x 35.17 = 158.27 Sq.Mt
- (K) 1.0 x 10.45 x 07.50 = 78.38 Sq.Mt
- (L) 1.0 x 44.22 x 06.09 = 269.30 Sq. Mt
- (M) 1.0 x 04.50 x 04.50 = 20.25 Sq.Mt
- (N) 1.0 x 07.25 x 01.80 = 13.05 Sq.Mt
- (P) 1.0 x 00.56 x 37.83 = 21.19 Sq.Mt

TOTAL VIOLATIVE AREA = 1764.18 Sq.Mt

NON VIOLATIVE AREA - GROUND FLOOR

- (O) 1.0 x 04.50 x 12.00 = 54.00 Sq.Mt
- (Q) 1.0 x 06.11 x 07.00 = 42.77 Sq.Mt
- (R) 1.0 x 03.50 x 30.91 = 108.19 Sq.Mt
- (S) 1.0 x 02.30 x 04.20 = 9.66 Sq.Mt
- (T) 1.0 x 14.80 x 04.43 = 65.56 Sq.Mt
- (V) 1.0 x 35.66 x 05.29 = 188.64 Sq.Mt
- (U) 0.5 x 02.80 x 04.50 = 6.30 Sq.Mt
- (W) 1.0 x 06.44 x 04.50 = 28.98 Sq.Mt.
- (X) 0.5 x 08.17 x 05.08 = 20.75 Sq.Mt
- (Y) 1.0 x 08.17 x 01.35 = 11.03 Sq.Mt
- (Z) 1.0 x 04.50 x 09.50 = 42.75 Sq.Mt
- (AA) 0.5 x 08.24 x 05.13 = 21.14 Sq.Mt
- (AB) 1.0 x 10.97 x 04.19 = 45.96 Sq. Mt
- (AC) 1.0 x 11.26 x 04.19 = 47.18 Sq. Mt
- (AD) 0.5 x 16.63 x 10.34 = 85.98 Sq.Mt
- (AE) 1.0 x 05.95 x 35.17 = 209.26 Sq.Mt
- (AF) 1.0 x 05.51 x 37.83 = 208.44 Sq.Mt

TOTAL NON VIOLATIVE AREA = 1196.59 Sq.Mt

NON VIOLATIVE
(AG) 21.34

