


LOCATION PLAN
(SCALE 1:10,000) D.P. PAGE No. 5

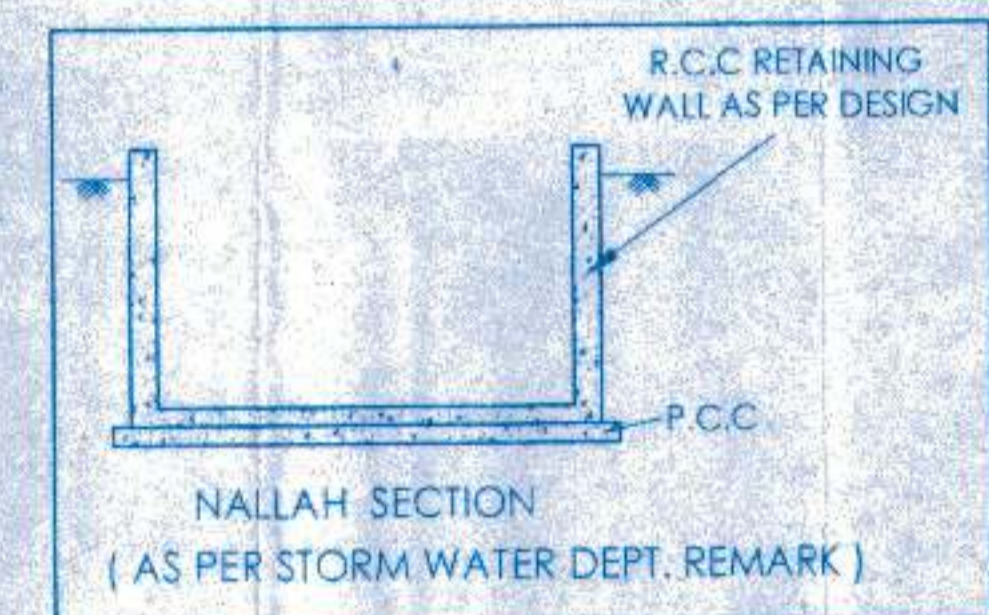

ADJ.S.NO.560/1(P)
APPROVED GROUP HOUSING
BUILDING PLAN

PLOT AREA STATEMENT

PLOT NO	AREA IN SQM.	PLOT NO	AREA IN SQM.
1	254.56	45	328.16
2 TO 3	247.46	46	389.66
4	226.36	47	402.74
5	187.74	48	262.50
6	163.41	49 TO 53	257.25
7	239.61	54	278.02
8 TO 9	243.00	55	262.50
10	271.96	56 TO 60	257.25
11	322.53	61	328.79
12 TO 17	240.49	62	388.84
18	264.92	63	259.61
19	348.14	64 TO 69	246.16
20	297.37	70	268.48
21 TO 25	246.75	71	274.61
27	321.95	72 TO 79	255.00
28	380.74	80	242.03
29 TO 35	252.00	81	220.03
36	277.38	82	577.11
37	311.77	83 (A.P.)	1800.00
38 TO 44	252.00		
		TOTAL =	23673.34 SQM.

APPROVAL

APPROVED
(Demarcated Final) Layout as per conditions
Mentioned in the letter No.LND/WS/C-2/67,
Date: 16/11/2013, View of Section 152(13)
& 69 of The Maharashtra Regional & Town

SD/ X-X-X
Assistant Director Of Town Planning
Town Planning
Nashik Municipal Corporation
Nashik.

TRUE COPY

DEMARCATION CERTIFICATE

THIS IS TO CERTIFY THAT I HAVE INSPECTED THIS LAYOUT WHICH IS TENTATIVELY APPROVED BY NASHIK MUNICIPAL CORPORATION, NASHIK VIDE LETTER No. LND/TL/C2/53, Dtd: 29/09/2011 AND FURTHER CERTIFY THAT THE MEASUREMENTS OF PLOTS, ROADS AND OPEN SPACE ETC. SHOWN IN DEMARCATION PLAN ARE ACTUALLY ON SITE.

ARCHITECT SIGN

NOTES :-

- ALL DIMENSION ARE IN METER
- LAND BOUNDARY SHOWN IN BLACK
- OPEN SPACE SHOWN IN GREEN
- AMENITY SPACE SHOWN IN PINK
- AMENITY SPACE OF ADJ.S. NO. 399/2 (PART) IS PROVIDED IN THIS LAYOUT

AREA STATEMENT

AREA STATEMENT	AREA IN SQM.
1) AREA OF THE LAND (AS PER 7/12)	34,200.00
3) AREA UNDER NALLA	300.00
4) NET AREA UNDER DEVELOPMENT (LYT)	33900.00
5) AREA UNDER AMENITY PLOT (P.H.G. 89)	1800.00
6) AREA UNDER OPEN SPACE	3390.00
7) AREA UNDER M.S.E.D.C.L.	210.00
8) AREA UNDER COLONY ROADS	6626.66
9) AREA UNDER PLOTS	21873.34

DEMARCATED RESIDENTIAL FINAL LAYOUT PLAN IN S. No. 399/2/2 OF MAKHAMALABAD SHIWAR IN NASHIK. FOR SMT. THANHUBAI V. GAIKWAD & OTHERS - 3

SMT. THANHUBAI V. GAIKWAD
SHRI. AVADIP M. GAIKWAD
SHRI. DEVENDRA M. GAIKWAD
SHRI. RAJENDRA M. GAIKWAD

G.V. KATALE AND ASSOCIATES
CONSULTING ENGINEERS & ARCHITECTS

OFFICE: 01, KAMAL RESIDENCY,
PATIL LANE & COLLEGE ROAD,
NASHIK - PH. (OFF) 2360925, 2379927
Email: gv.katale@shy.com

ACCESS KEY: -CONVENIENCE/399 DATE: 11 June 2013 CDD BY: KATALE G.V.
JOB REF: AS PER MAP SCALE: 1:500 DRN BY: MANOHAR V.