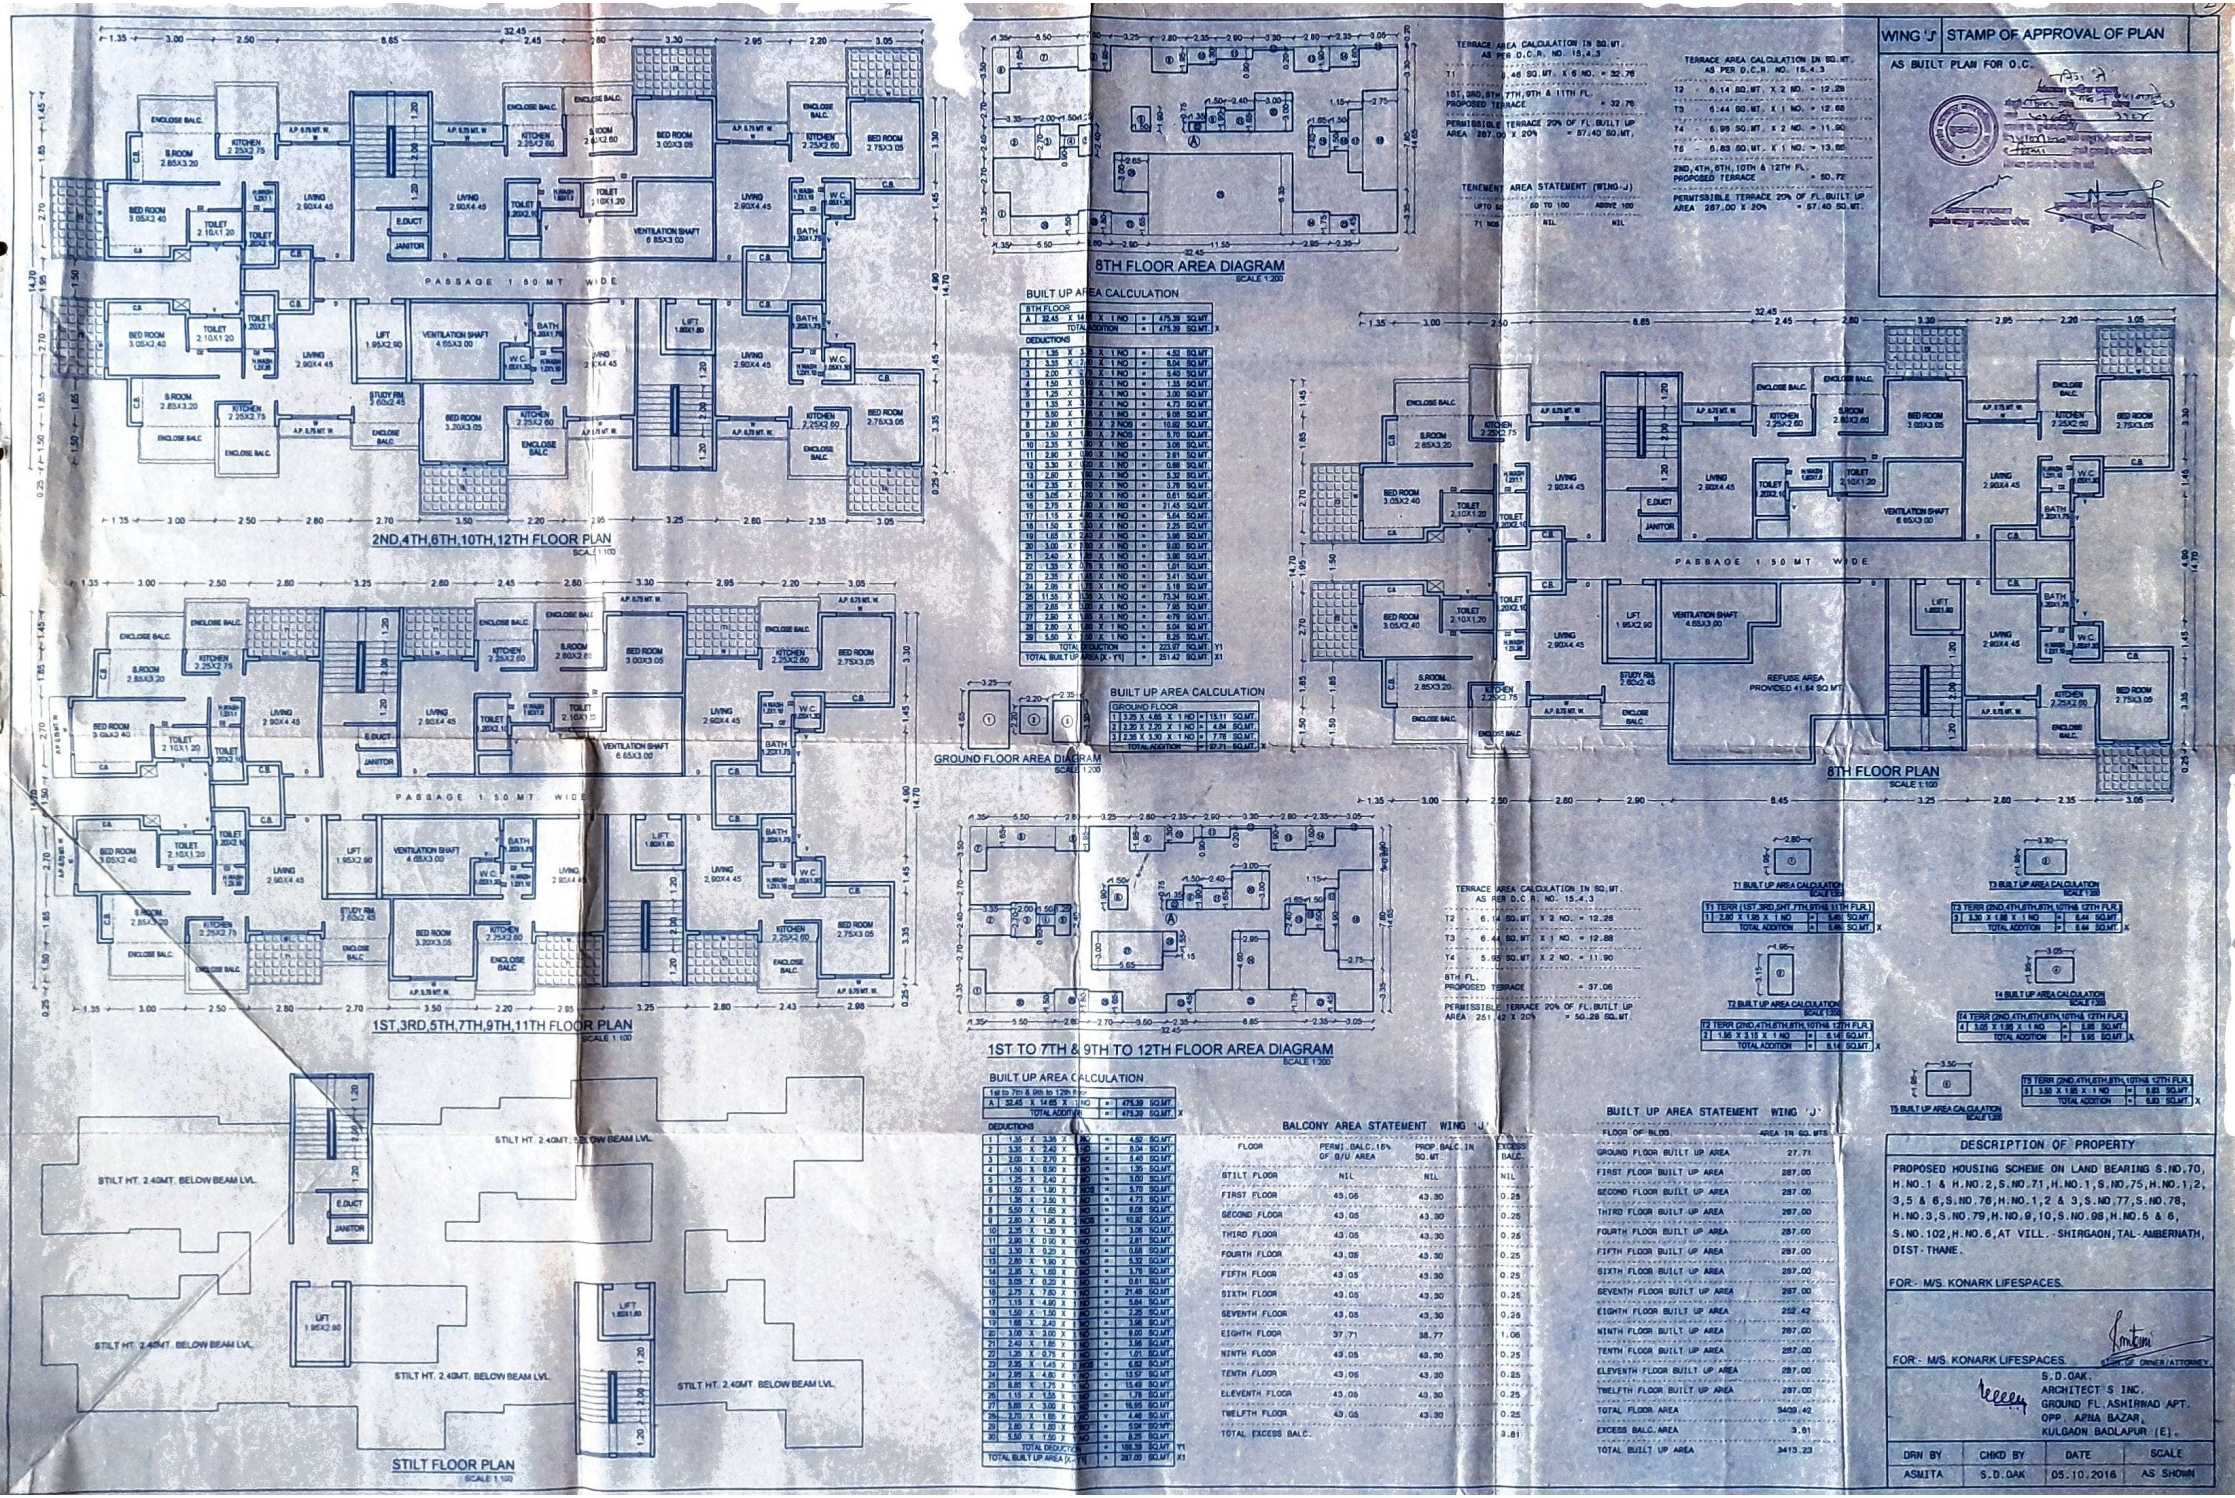
WING 'J'
STAMP OF APPROVAL OF PLAN
AS BUILT PLAN FOR O.C.
2ND,4TH,6TH,10TH,12TH FLOOR PLAN
SCALE 1:100
1ST,3RD,5TH,7TH,9TH,11TH FLOOR PLAN
SCALE 1:100
STILT FLOOR PLAN
SCALE 1:100
8TH FLOOR AREA DIAGRAM
SCALE 1:200
GROUND FLOOR AREA DIAGRAM
SCALE 1:200
1ST TO 7TH & 9TH TO 12TH FLOOR AREA DIAGRAM
SCALE 1:200
8TH FLOOR PLAN
SCALE 1:100
BUILT UP AREA CALCULATION
BUILT UP AREA CALCULATION
BUILT UP AREA CALCULATION
TERRACE AREA CALCULATION IN SQ.MT. AS PER D.C.R. NO. 15.4.3
TERRACE AREA CALCULATION IN SQ.MT. AS PER D.C.R. NO. 15.4.3
TENEMENT AREA STATEMENT (WING-J)
BALCONY AREA STATEMENT WING 'J'
BUILT UP AREA STATEMENT WING 'J'
T1 BUILT UP AREA CALCULATION
T2 BUILT UP AREA CALCULATION
T3 BUILT UP AREA CALCULATION
T4 BUILT UP AREA CALCULATION
T5 BUILT UP AREA CALCULATION
DESCRIPTION OF PROPERTY
PROPOSED HOUSING SCHEME ON LAND BEARING S.NO.70, H.NO.1 & H.NO.2,S.NO.71,H.NO.1,S.NO.75,H.NO.1,2, 3,5 & 6,S.NO.76,H.NO.1,2 & 3,S.NO.77,S.NO.78, H.NO.3,S.NO.79,H.NO.9,10,S.NO.98,H.NO.5 & 6, S.NO.102,H.NO.6,AT VILL.-SHIRGAON,TAL-AMBERNATH, DIST-THANE.
FOR:- M/S. KONARK LIFESPACES.
FOR:- M/S. KONARK LIFESPACES.
S.D.OAK. ARCHITECT'S INC. GROUND FL.ASHIRWAD APT. OPP. APNA BAZAR, KULGAON BADLAPUR (E).
DRN BY ASMITA
CHKD BY S.D.OAK
DATE 05.10.2016
SCALE AS SHOWN