



पनवेल महानगरपालिका
 नो. २०८७/२०२३
 वेविल ऑफिस नं. ३४, ३५, ३६, १००
 मधील अटी, शर्ती व अटी वरून नकाराचे ताल रंगीने दुकस केलावयाचा आहे.

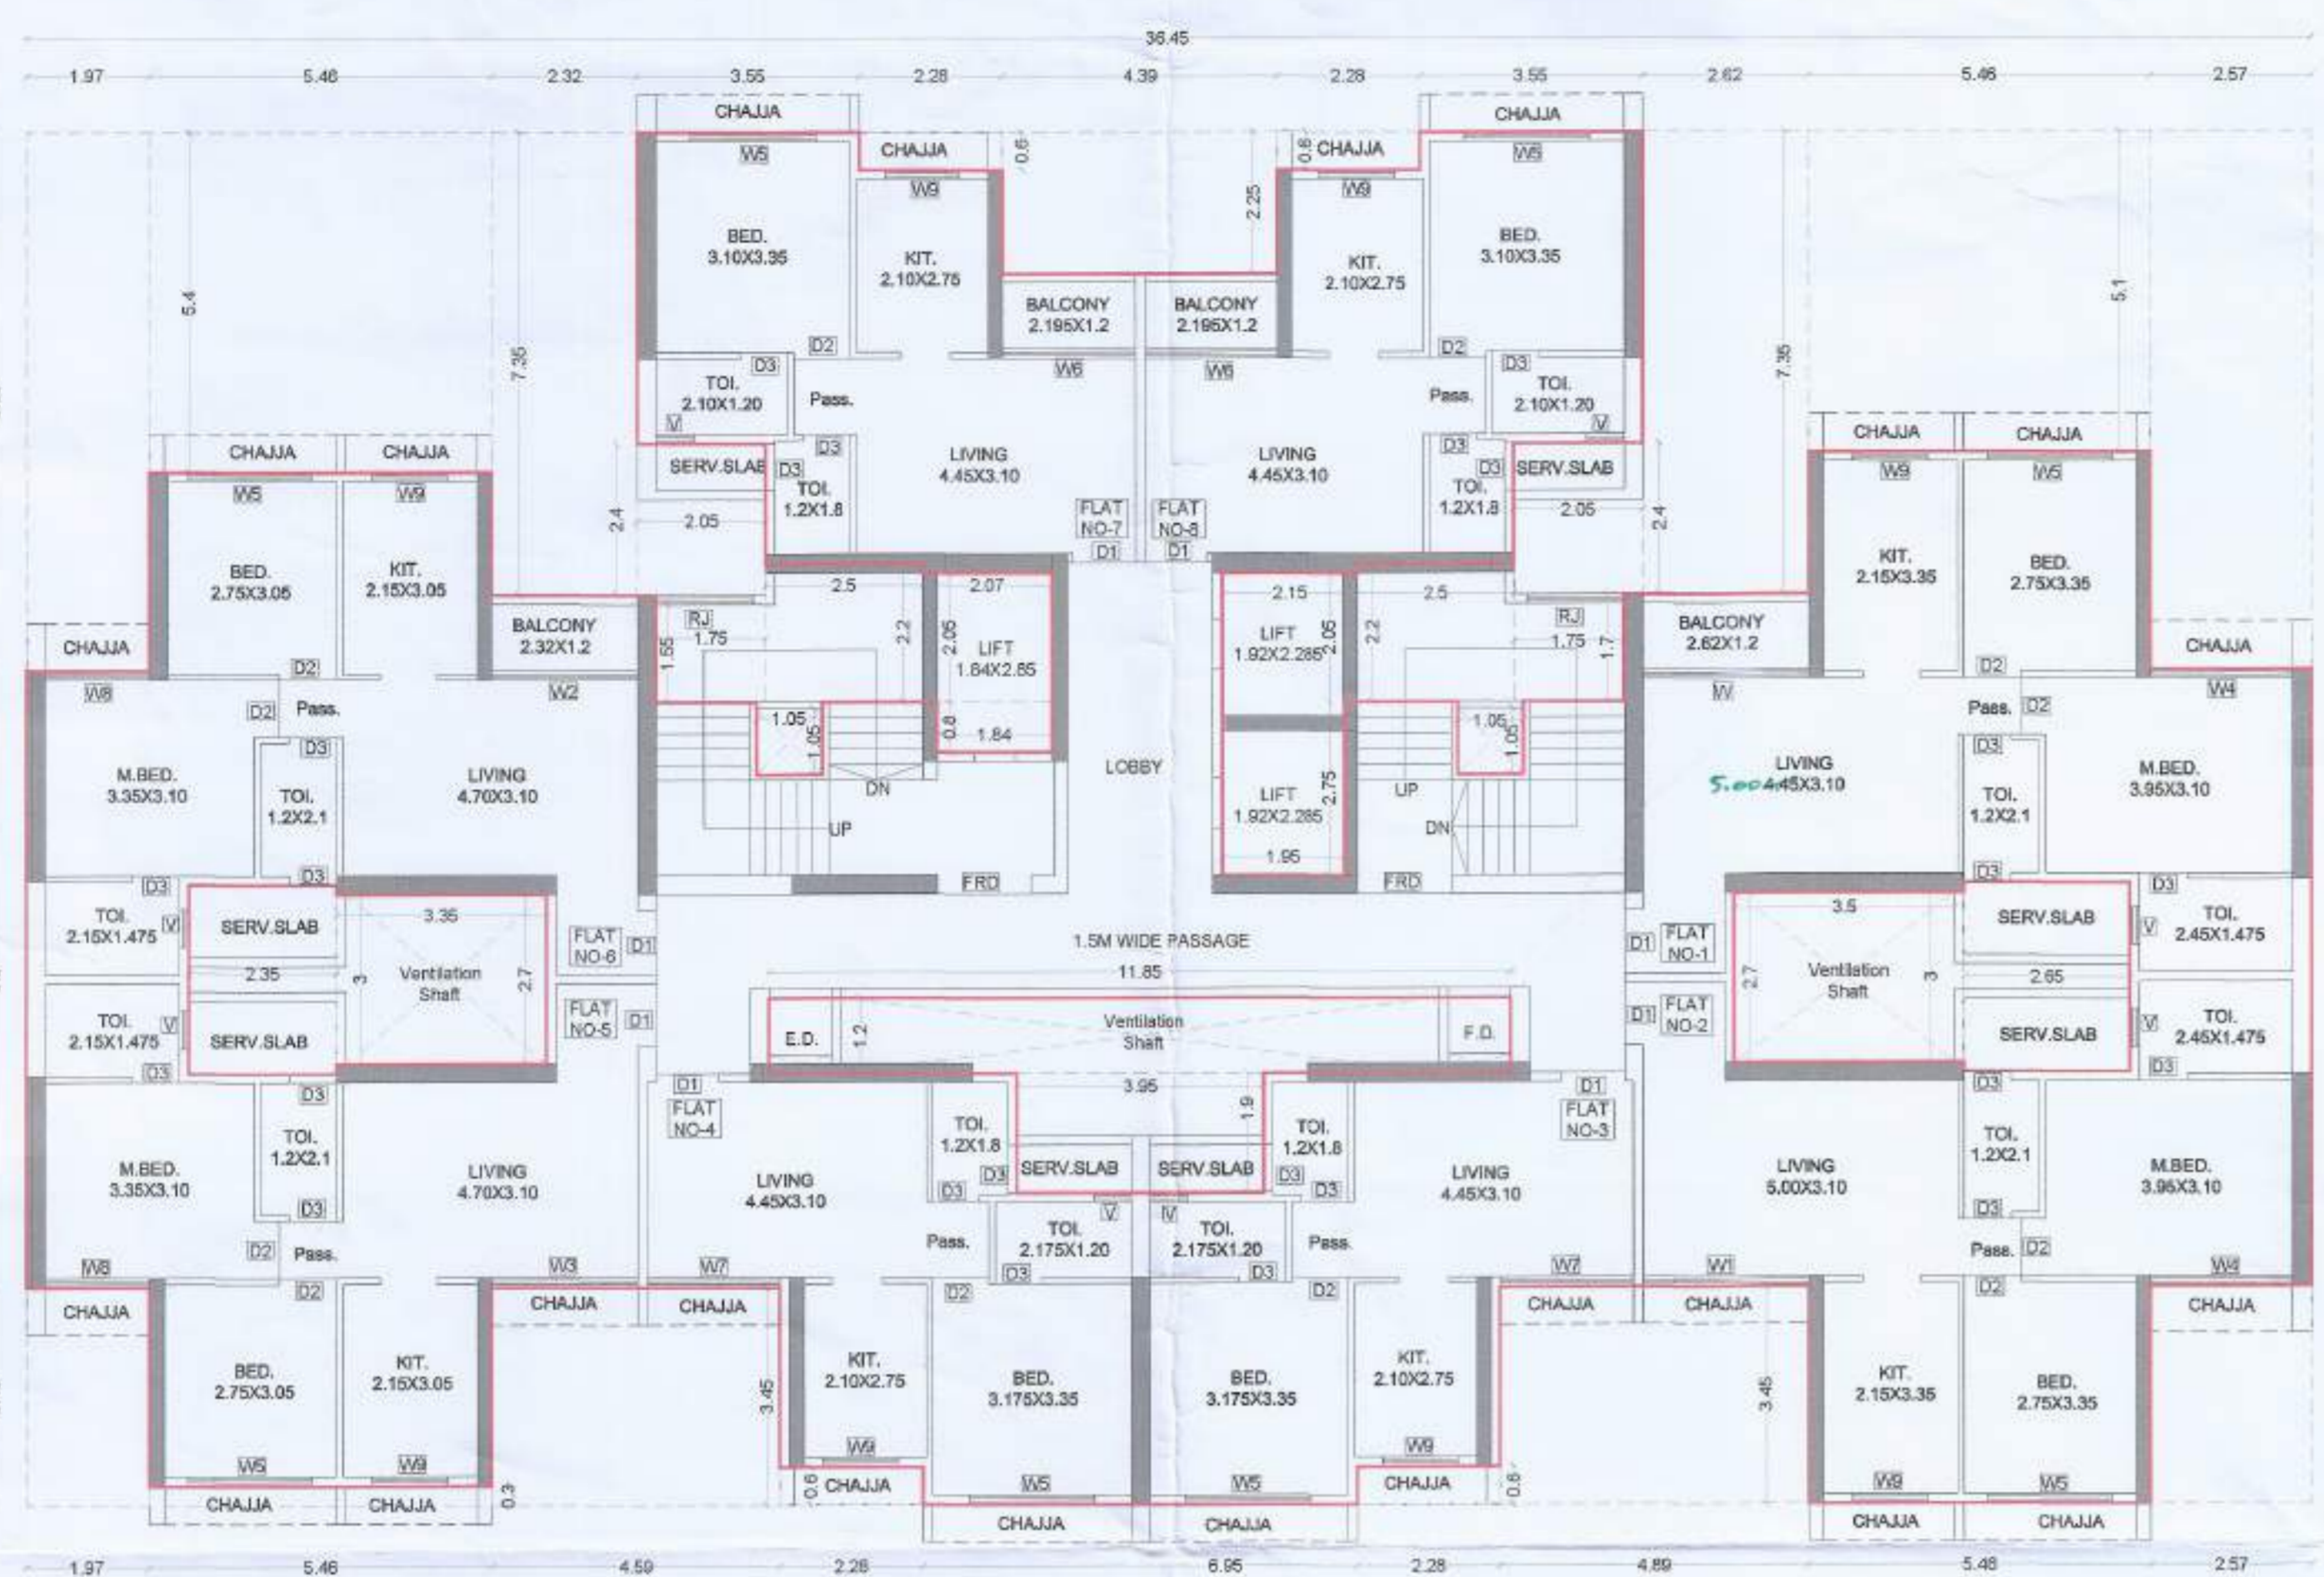


TYPICAL 5TH TO 8TH, 10TH TO 13TH, 15TH TO 18TH, 20TH TO 23RD FLOOR PLAN
 SCALE 1:100

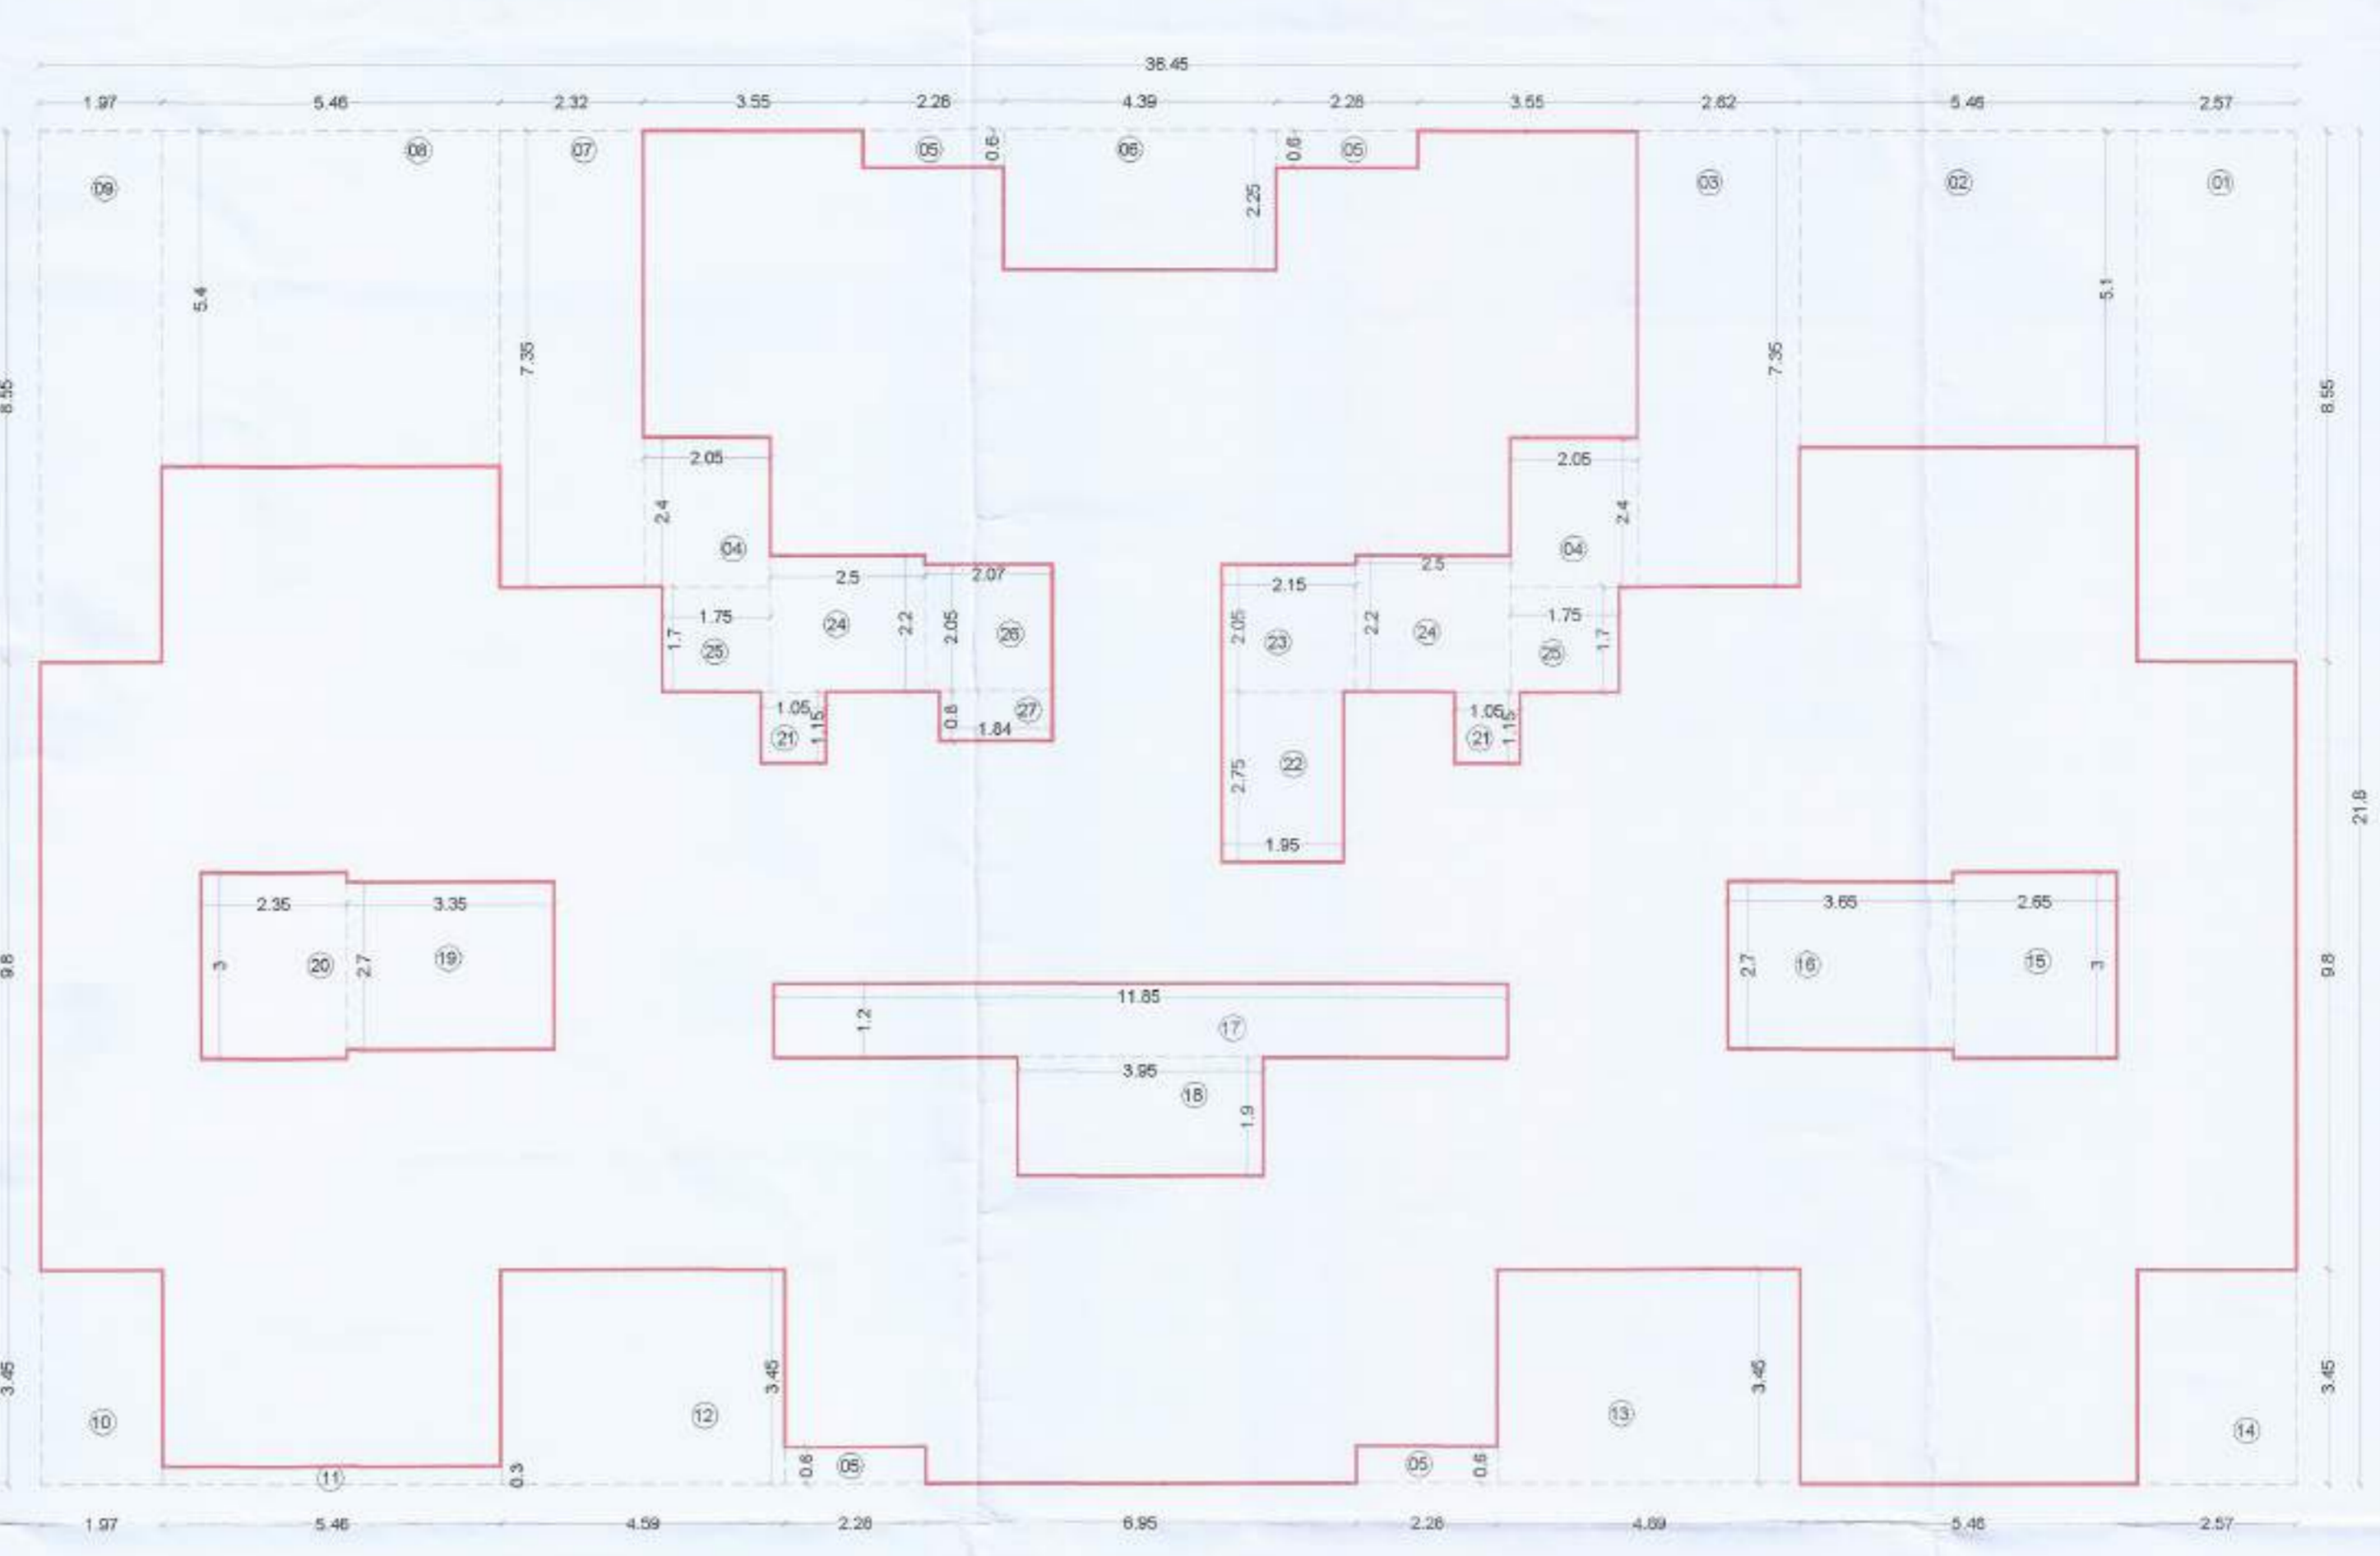


TYPICAL 5TH TO 8TH, 10TH TO 13TH, 15TH TO 18TH, 20TH TO 23RD FLOOR AREA DIAGRAM & CALCULATION
 SCALE 1:100

TYPICAL 5TH TO 8TH, 10TH TO 13TH, 15TH TO 18TH, 20TH TO 23RD FLOOR BUILT UP AREA CALCULATION						
S.No	Description	Length	X	Breadth	No.	Area in sqm
1	Block	38.450	X	21.800	X 1	= 794.610
Total						794.610 (A)
Deductions						
1		2.370	X	8.550	X 1	= 20.294
2		3.400	X	5.100	X 1	= 17.340
3		2.620	X	7.350	X 1	= 19.237
4		2.050	X	3.400	X 2	= 9.840
5		2.280	X	0.600	X 4	= 5.472
6		4.390	X	2.250	X 1	= 9.878
7		2.320	X	7.350	X 1	= 17.052
8		5.460	X	3.400	X 1	= 18.564
9		1.370	X	8.550	X 1	= 11.656
10		1.370	X	5.460	X 1	= 7.397
11		5.460	X	0.300	X 1	= 1.638
12		4.190	X	3.450	X 1	= 14.455
13		4.890	X	3.450	X 1	= 16.871
14		2.570	X	3.450	X 1	= 8.867
15		2.800	X	8.000	X 1	= 22.400
16		3.850	X	2.700	X 1	= 10.395
17		11.850	X	1.200	X 1	= 14.220
18		3.950	X	1.900	X 1	= 7.505
19		3.350	X	2.700	X 1	= 9.045
20		2.250	X	3.000	X 1	= 6.750
21		1.050	X	1.150	X 2	= 2.415
22		1.950	X	2.750	X 1	= 5.363
23		2.150	X	2.050	X 1	= 4.408
24		2.800	X	2.300	X 2	= 11.000
25		1.750	X	1.700	X 2	= 5.950
26		2.070	X	2.050	X 1	= 4.244
27		1.840	X	0.800	X 3	= 4.440
Total Deductions						298.128 (B)
TOTAL BUILT UP AREA PER FLOOR (A-B)						496.482 (C)

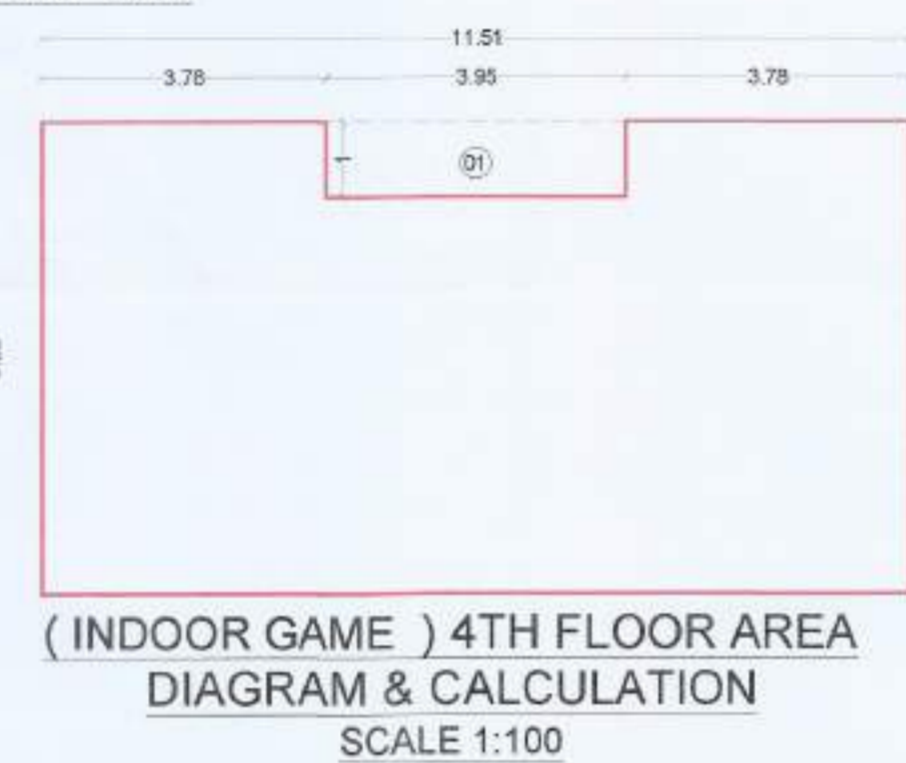


(INDOOR GAME) 4TH FLOOR AREA
 DIAGRAM & CALCULATION
 SCALE 1:100

4TH FLOOR BUILT UP AREA CALCULATION						
S.No	Description	Length	X	Breadth	No.	Area in sqm
1	Block	11.510	X	6.250	X 1	= 71.938
Total						71.938 (A)
Deductions						
1		3.950	X	1.000	X 1	= 3.950
Total Deductions						3.950 (B)
TOTAL BUILT UP AREA 4TH FLOOR (A-B)						67.988 (C)

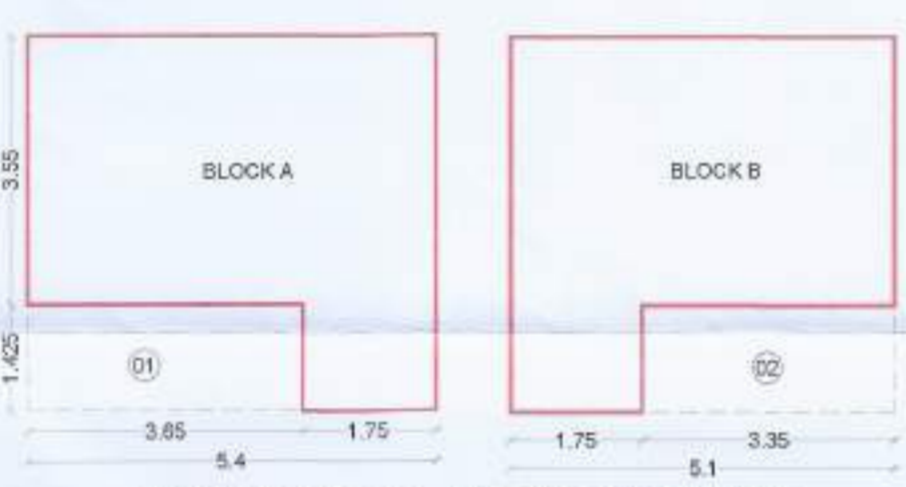

METER ROOM AREA DIAGRAM &
 CALCULATION
 (SCALE 1:100)


METER ROOM BUILT UP AREA CALCULATION						
S.No	Description	Length	X	Breadth	No.	Area in sqm
1	Block A	5.400	X	4.375	X 1	= 23.625
2	Block B	5.100	X	4.375	X 1	= 22.313
Total						45.938 (A)
Deductions						
1		3.650	X	1.425	X 1	= 5.201
2		3.350	X	1.425	X 1	= 4.774
Total Deductions						9.975 (B)
TOTAL BUILT UP AREA ON METER ROOM (A-B)						35.963 (C)

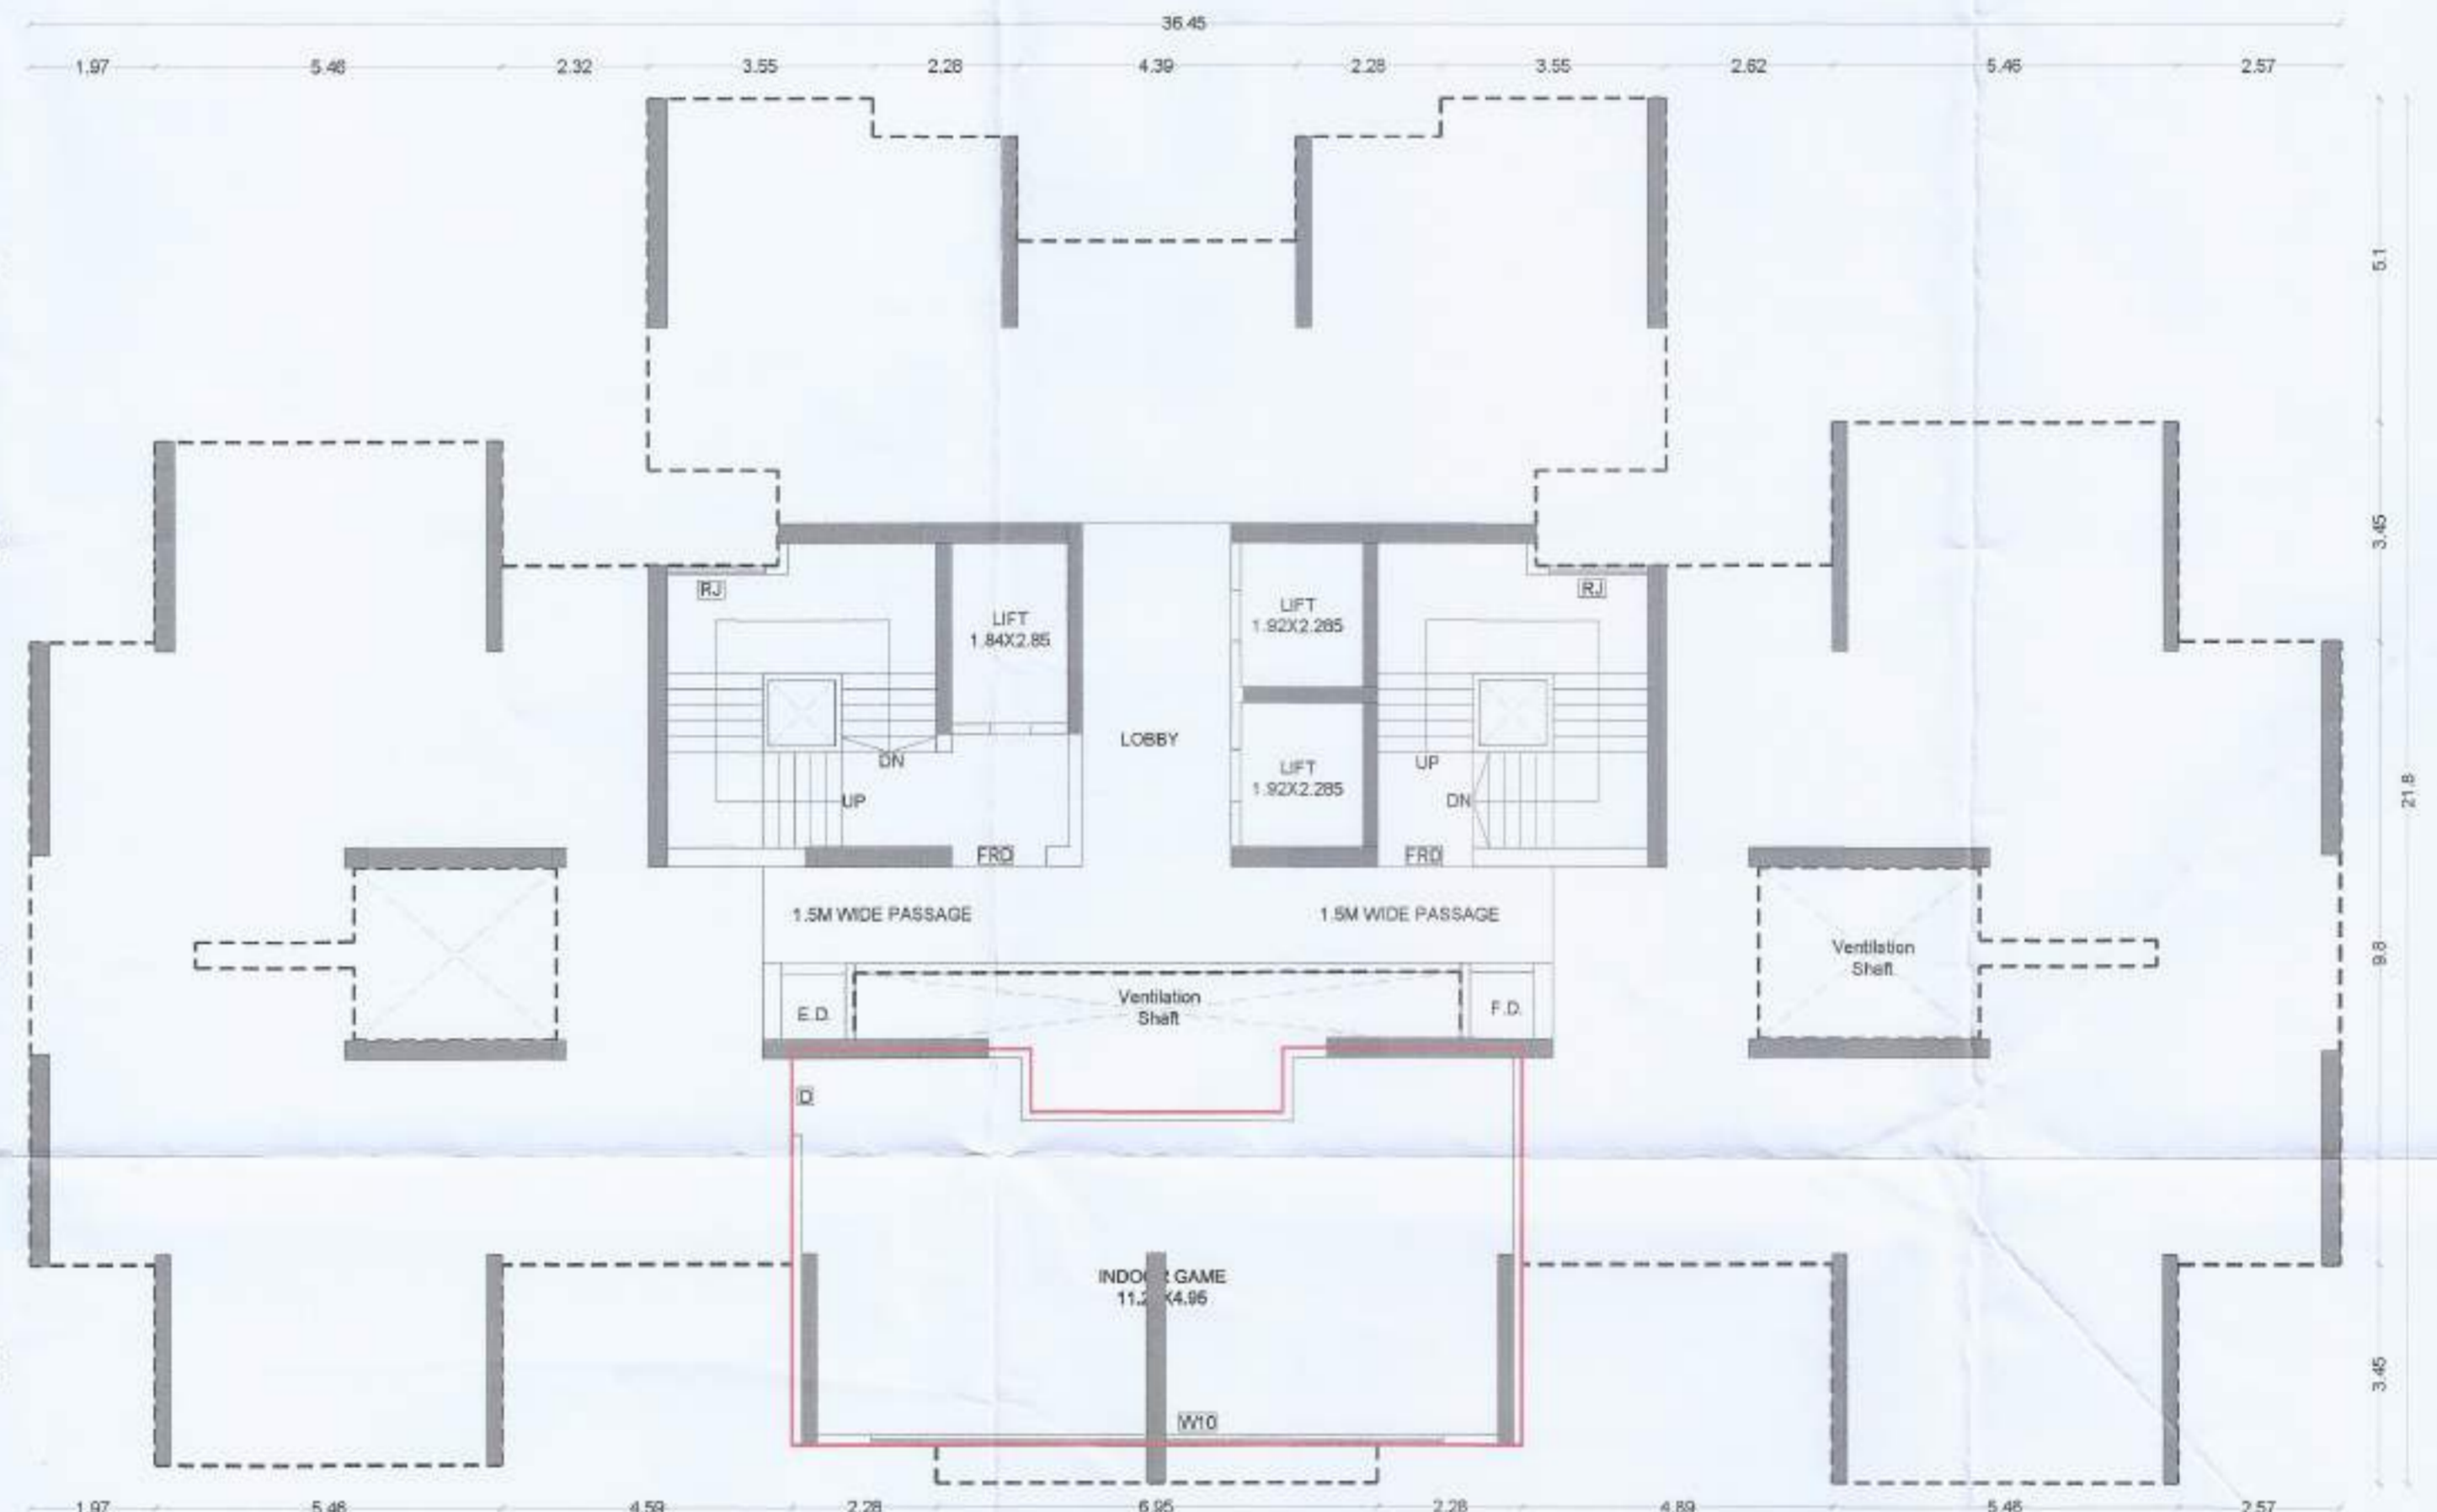


4TH (PODIUM) FLOOR PLAN
 SCALE 1:100

GROUND FLOOR BUILT UP AREA CALCULATION						
S.No	Description	Length	X	Breadth	No.	Area in sqm
1	Block	4.810	X	4.450	X 1	= 21.583
Total						21.583 (C)

GROUND FLOOR AREA DIAGRAM
 & CALCULATION
 SCALE 1:100

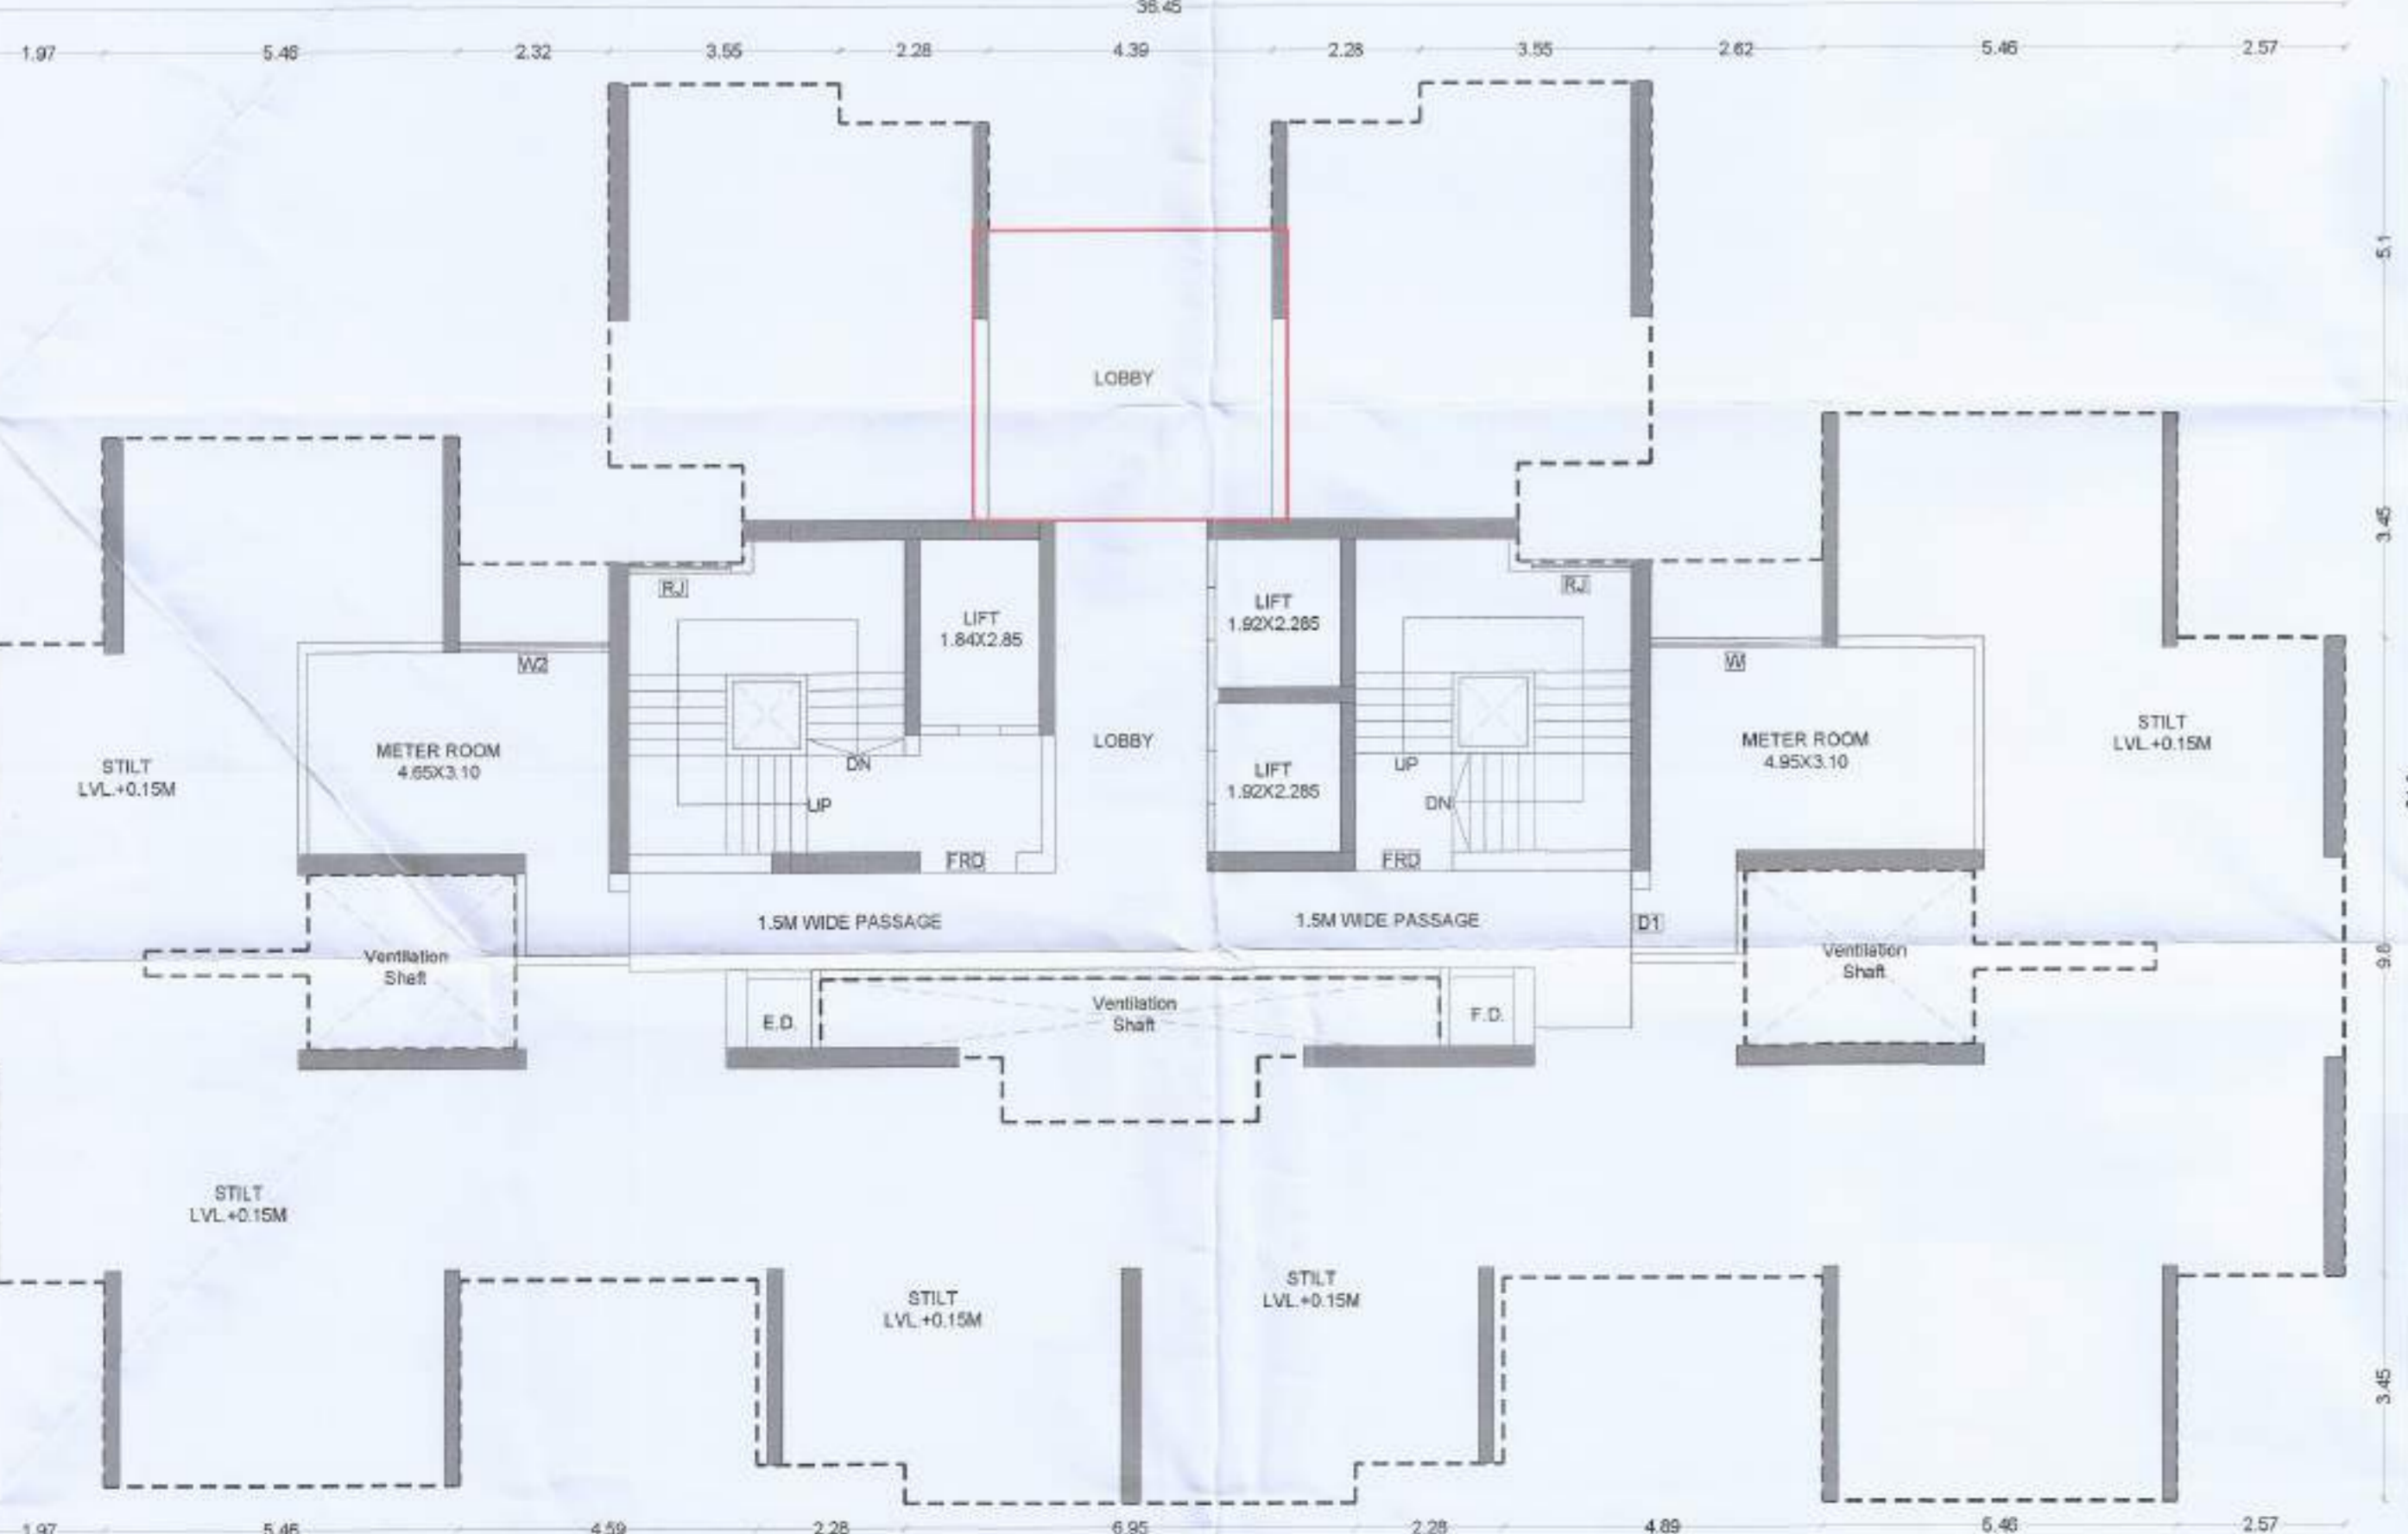

GROUND FLOOR PLAN
 SCALE 1:100

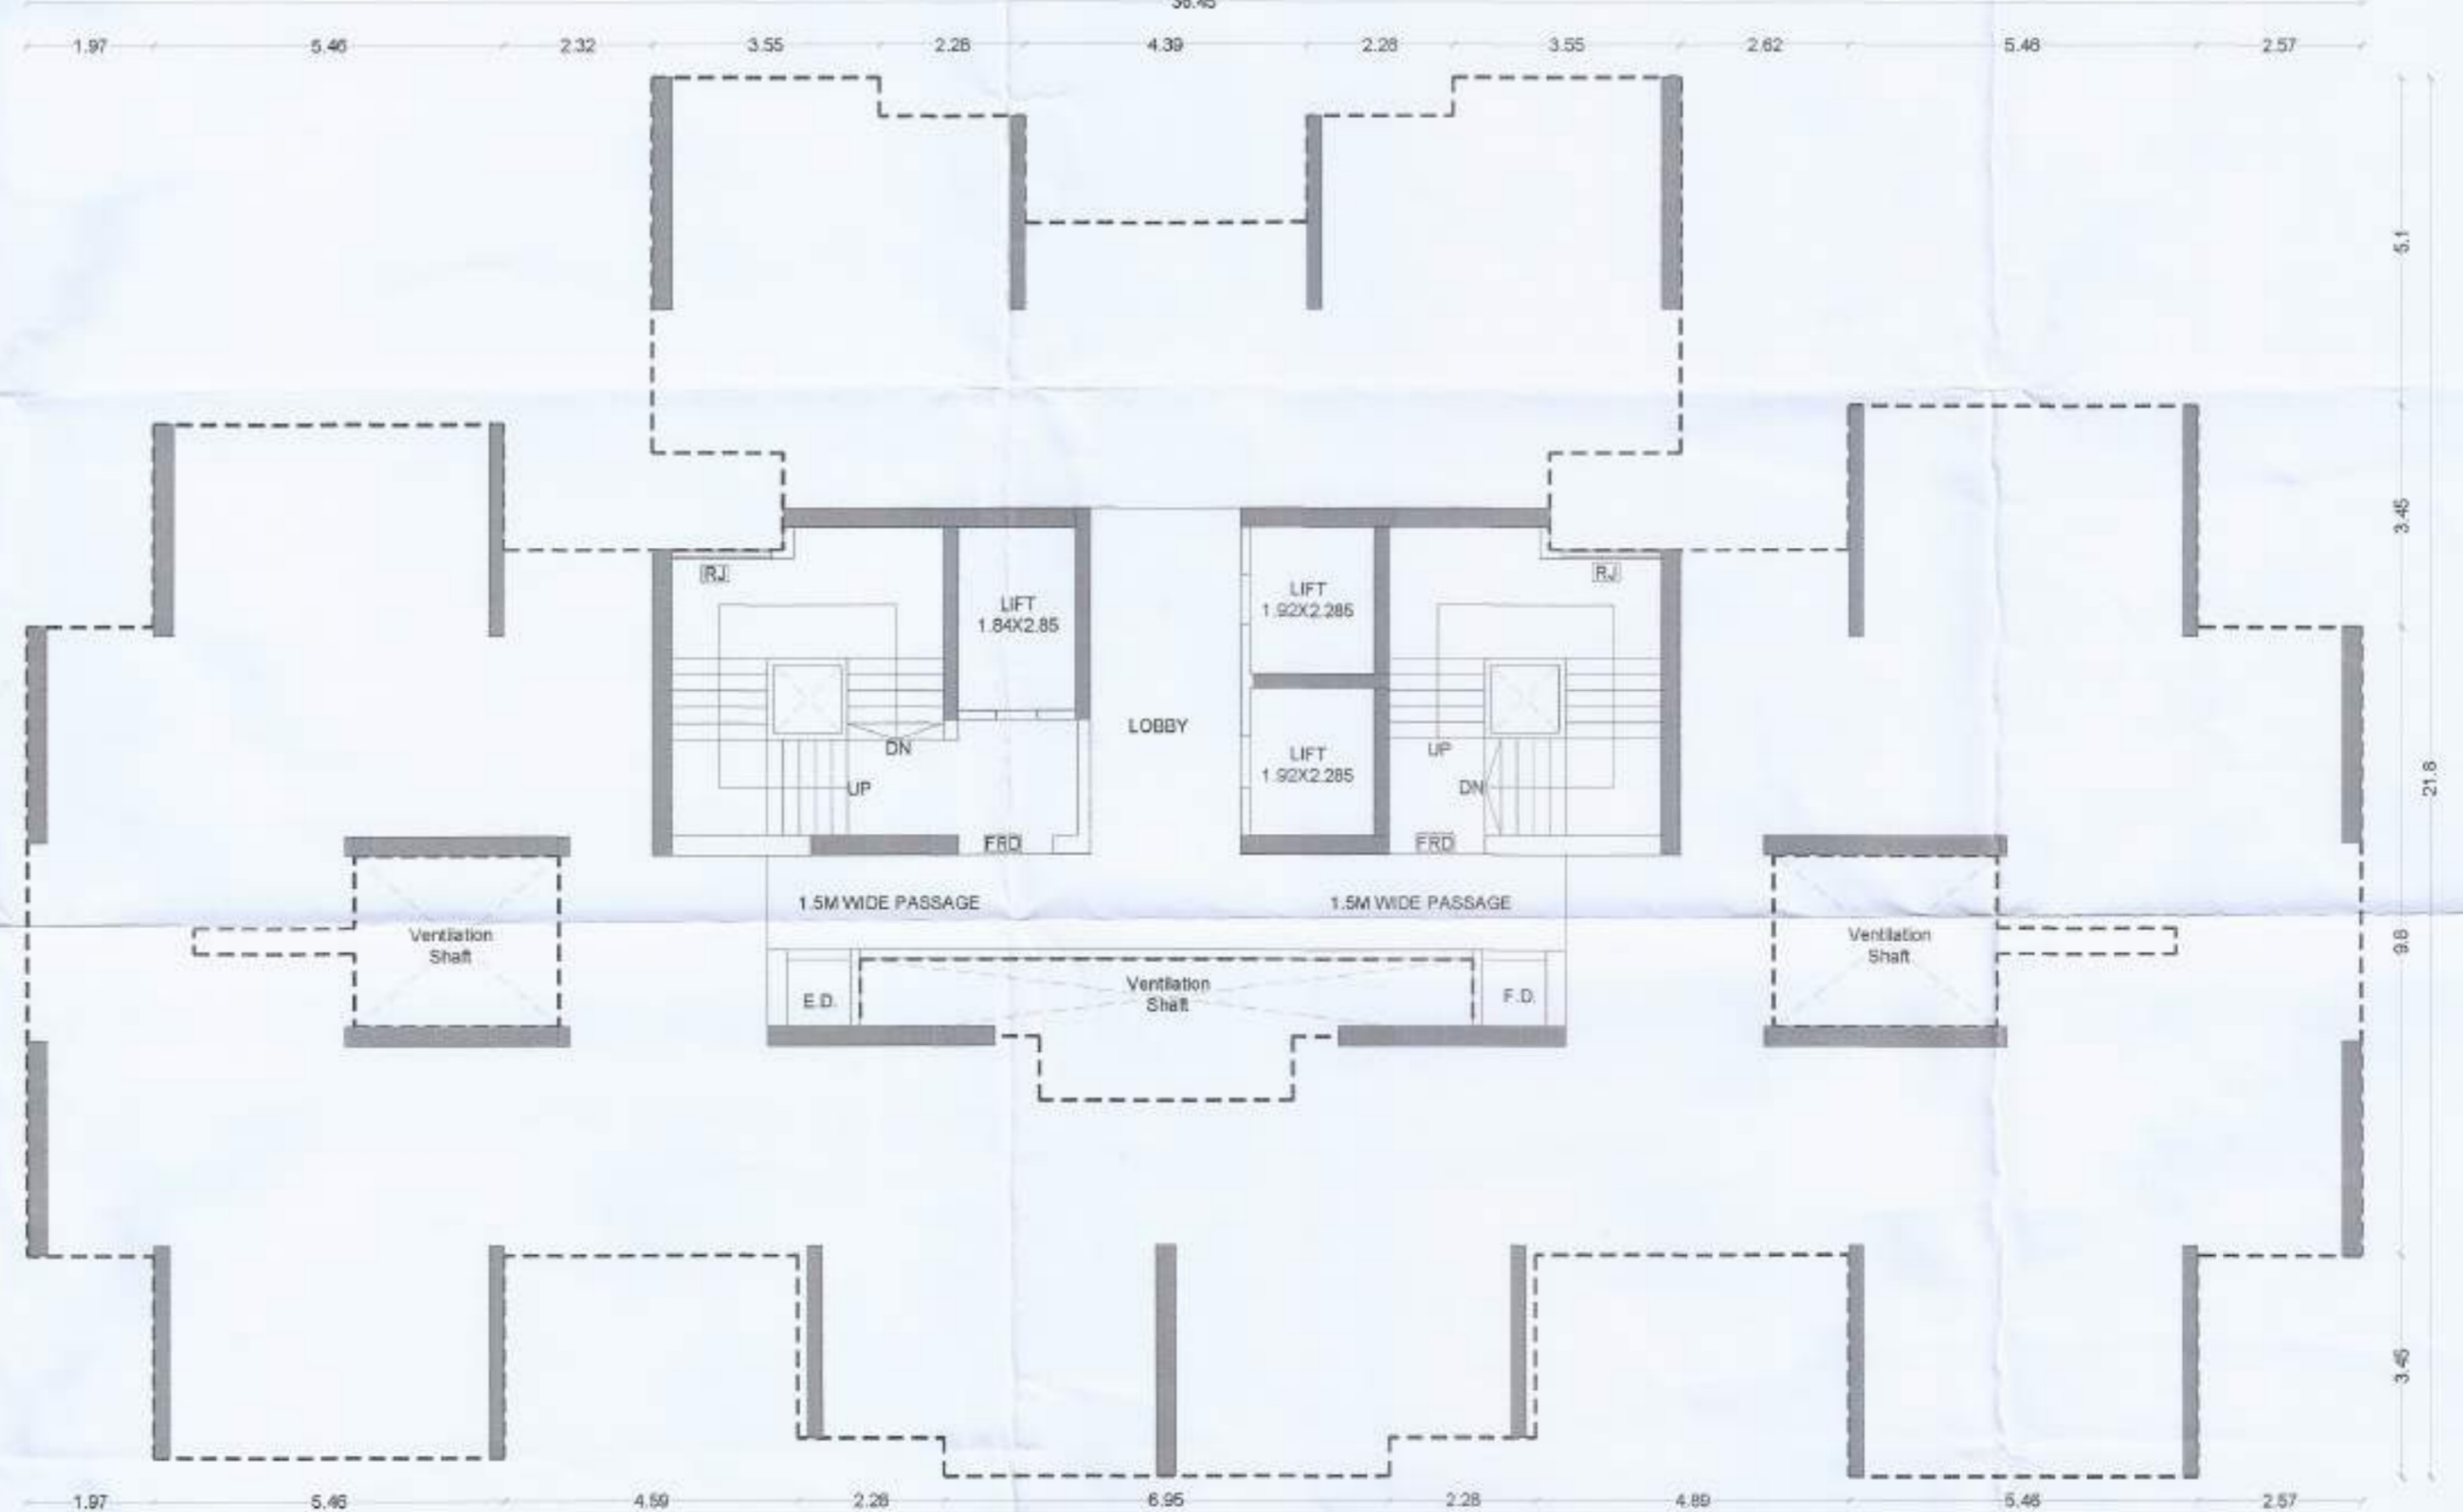

TYPICAL 1ST TO 3RD PARKING FLOOR PLAN
 SCALE 1:100

Correction Marked in Green Colour.

TENEMENT STATEMENT
 COMMERCIAL
 1) Total Nos of Shops 0 Nos
 RESIDENTIAL
 Total Nos of Units 149 Nos

CONTENTS OF SHEET
 GROUND FLOOR PLAN, TYPICAL FLOOR PLAN, GROUND & TYPICAL FLOOR BU AREA CALCULATION DIAGRAM & STATEMENT, DRIVERS ROOM, SERVANT TOILET & METER ROOM AREA DIAGRAM & CALCULATION

NAME OF THE OWNER & SIGNATURE

M/S. METRO SATYAM DEVELOPERS - PARTNERS
 For Metro Satyam Developers

KARAN GULATI
 For Metro Satyam Developers

HITESH JAIN
 Partners

DESCRIPTION OF PROPOSAL & PROPERTY
 PROPOSED COMMERCIAL CUM RESIDENTIAL BUILDINGS ON SURVEY No. 13/1, 14/5B, 14/6, 15/5, 15/6 & 15/8AT VILLAGE - ROHINJAN, TAL - PANVEL, DIST - RAIGAD.

ARCHITECT NAME & SIGN

AN.ARCH ARCHITECT & PLANNERS

Office no 20&21, Raheja Arcade, Sec-11, Plot no 61, CBD Belapur-400614, cctd no 022-27562410, mail i.d-anarch.architect@gmail.com

DATE 28-08-2021

DRAWN BY Rajeshree

CHKD BY Gharat

SCALE 1:100

NORTH

AN.ARCH ARCHITECT & PLANNERS

Office no 20&21, Raheja Arcade, Sec-11, Plot no 61, CBD Belapur-400614, cctd no 022-27562410, mail i.d-anarch.architect@gmail.com

DESIGN WITH A DIFFERENCE