PROFORMA-I

PROPOSED RESIDENTIAL CUM COMMERCIAL BUILDING ON LAND BEARING S. NO. - 2/1/1, VILLAGE - KOYNAVELE, TAL. - PANVEL, DIST. - RAIGAD.

SHEET NO. 5/5

STAMPS OF APPROVAL OF PLANS

पनवेल महानगरपालिका
मौजे- कोयनावेळे सेक्टर —
येथील अंतिम ~~भूं.क्र./न.भू.क्र./~~सर्व्हे क्र./~~गट क्र./~~
~~भूं.क्र./~~ २।१।१ मध्ये नियोजित/~~सुधारित/~~
~~फेरबदल करणेस/वाढीव~~ बांधकामाचे नकाशांस या
कार्यालयाचे जा.क्र./पमपा/नरवि/ १६४३९/जा.क्र.
१९१३/२०२२ दिनांक ३०/०६/२०२२
मधील अटी, शर्तींस अधिन राहून नकाशांस लाल रंगाने
दुरूस्त केल्यानुसार मंजूर.

सहाय्यक संचालक, नगररचना
पनवेल महानगरपालिका

PANVEL MUNICIPAL CORPORATION
पनवेल महानगरपालिका पनवेल–रायगड
PANVEL-RAIGAD

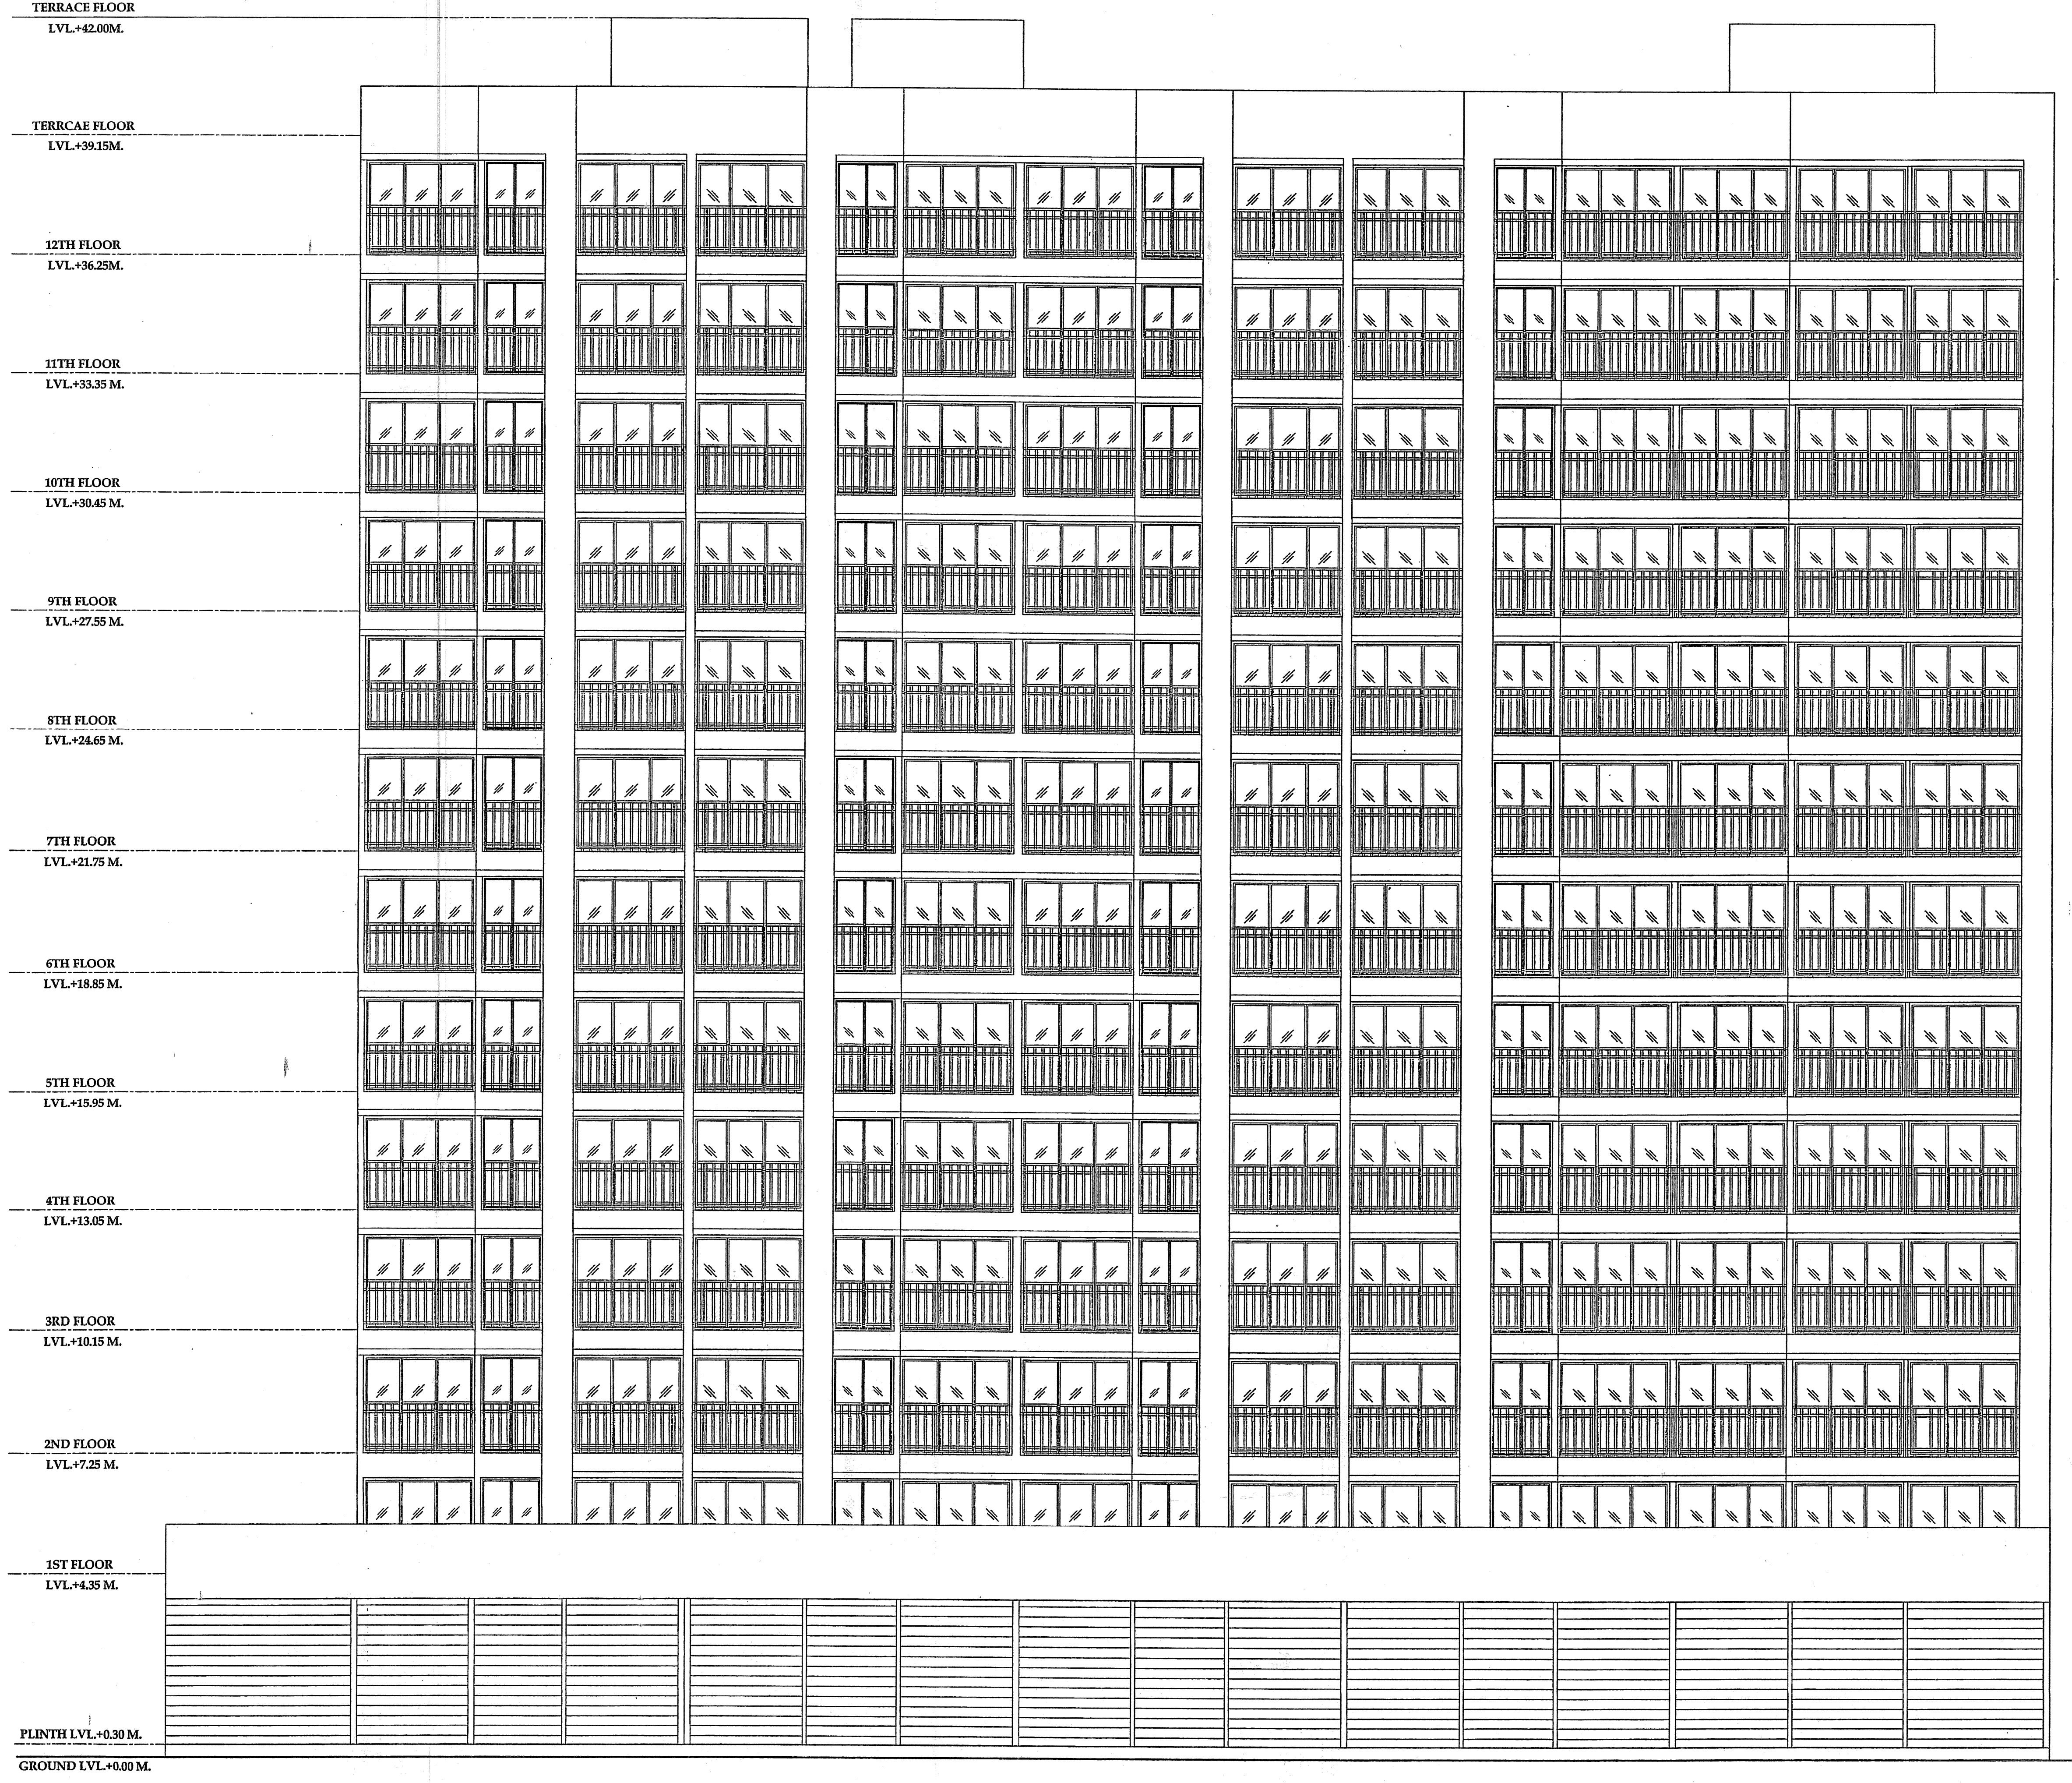
TERRACE FLOOR
LVL.+42.00M.
TERRCAE FLOOR
LVL.+39.15M.
12TH FLOOR
LVL.+36.25M.
11TH FLOOR
LVL.+33.35 M.
10TH FLOOR
LVL.+30.45 M.
9TH FLOOR
LVL.+27.55 M.
8TH FLOOR
LVL.+24.65 M.
7TH FLOOR
LVL.+21.75 M.
6TH FLOOR
LVL.+18.85 M.
5TH FLOOR
LVL.+15.95 M.
4TH FLOOR
LVL.+13.05 M.
3RD FLOOR
LVL.+10.15 M.
2ND FLOOR
LVL.+7.25 M.
1ST FLOOR
LVL.+4.35 M.
PLINTH LVL.+0.30 M.
GROUND LVL.+0.00 M.

FRONT SIDE ELEVATION

BUILDING- 1& 2 SCALE - 1:100

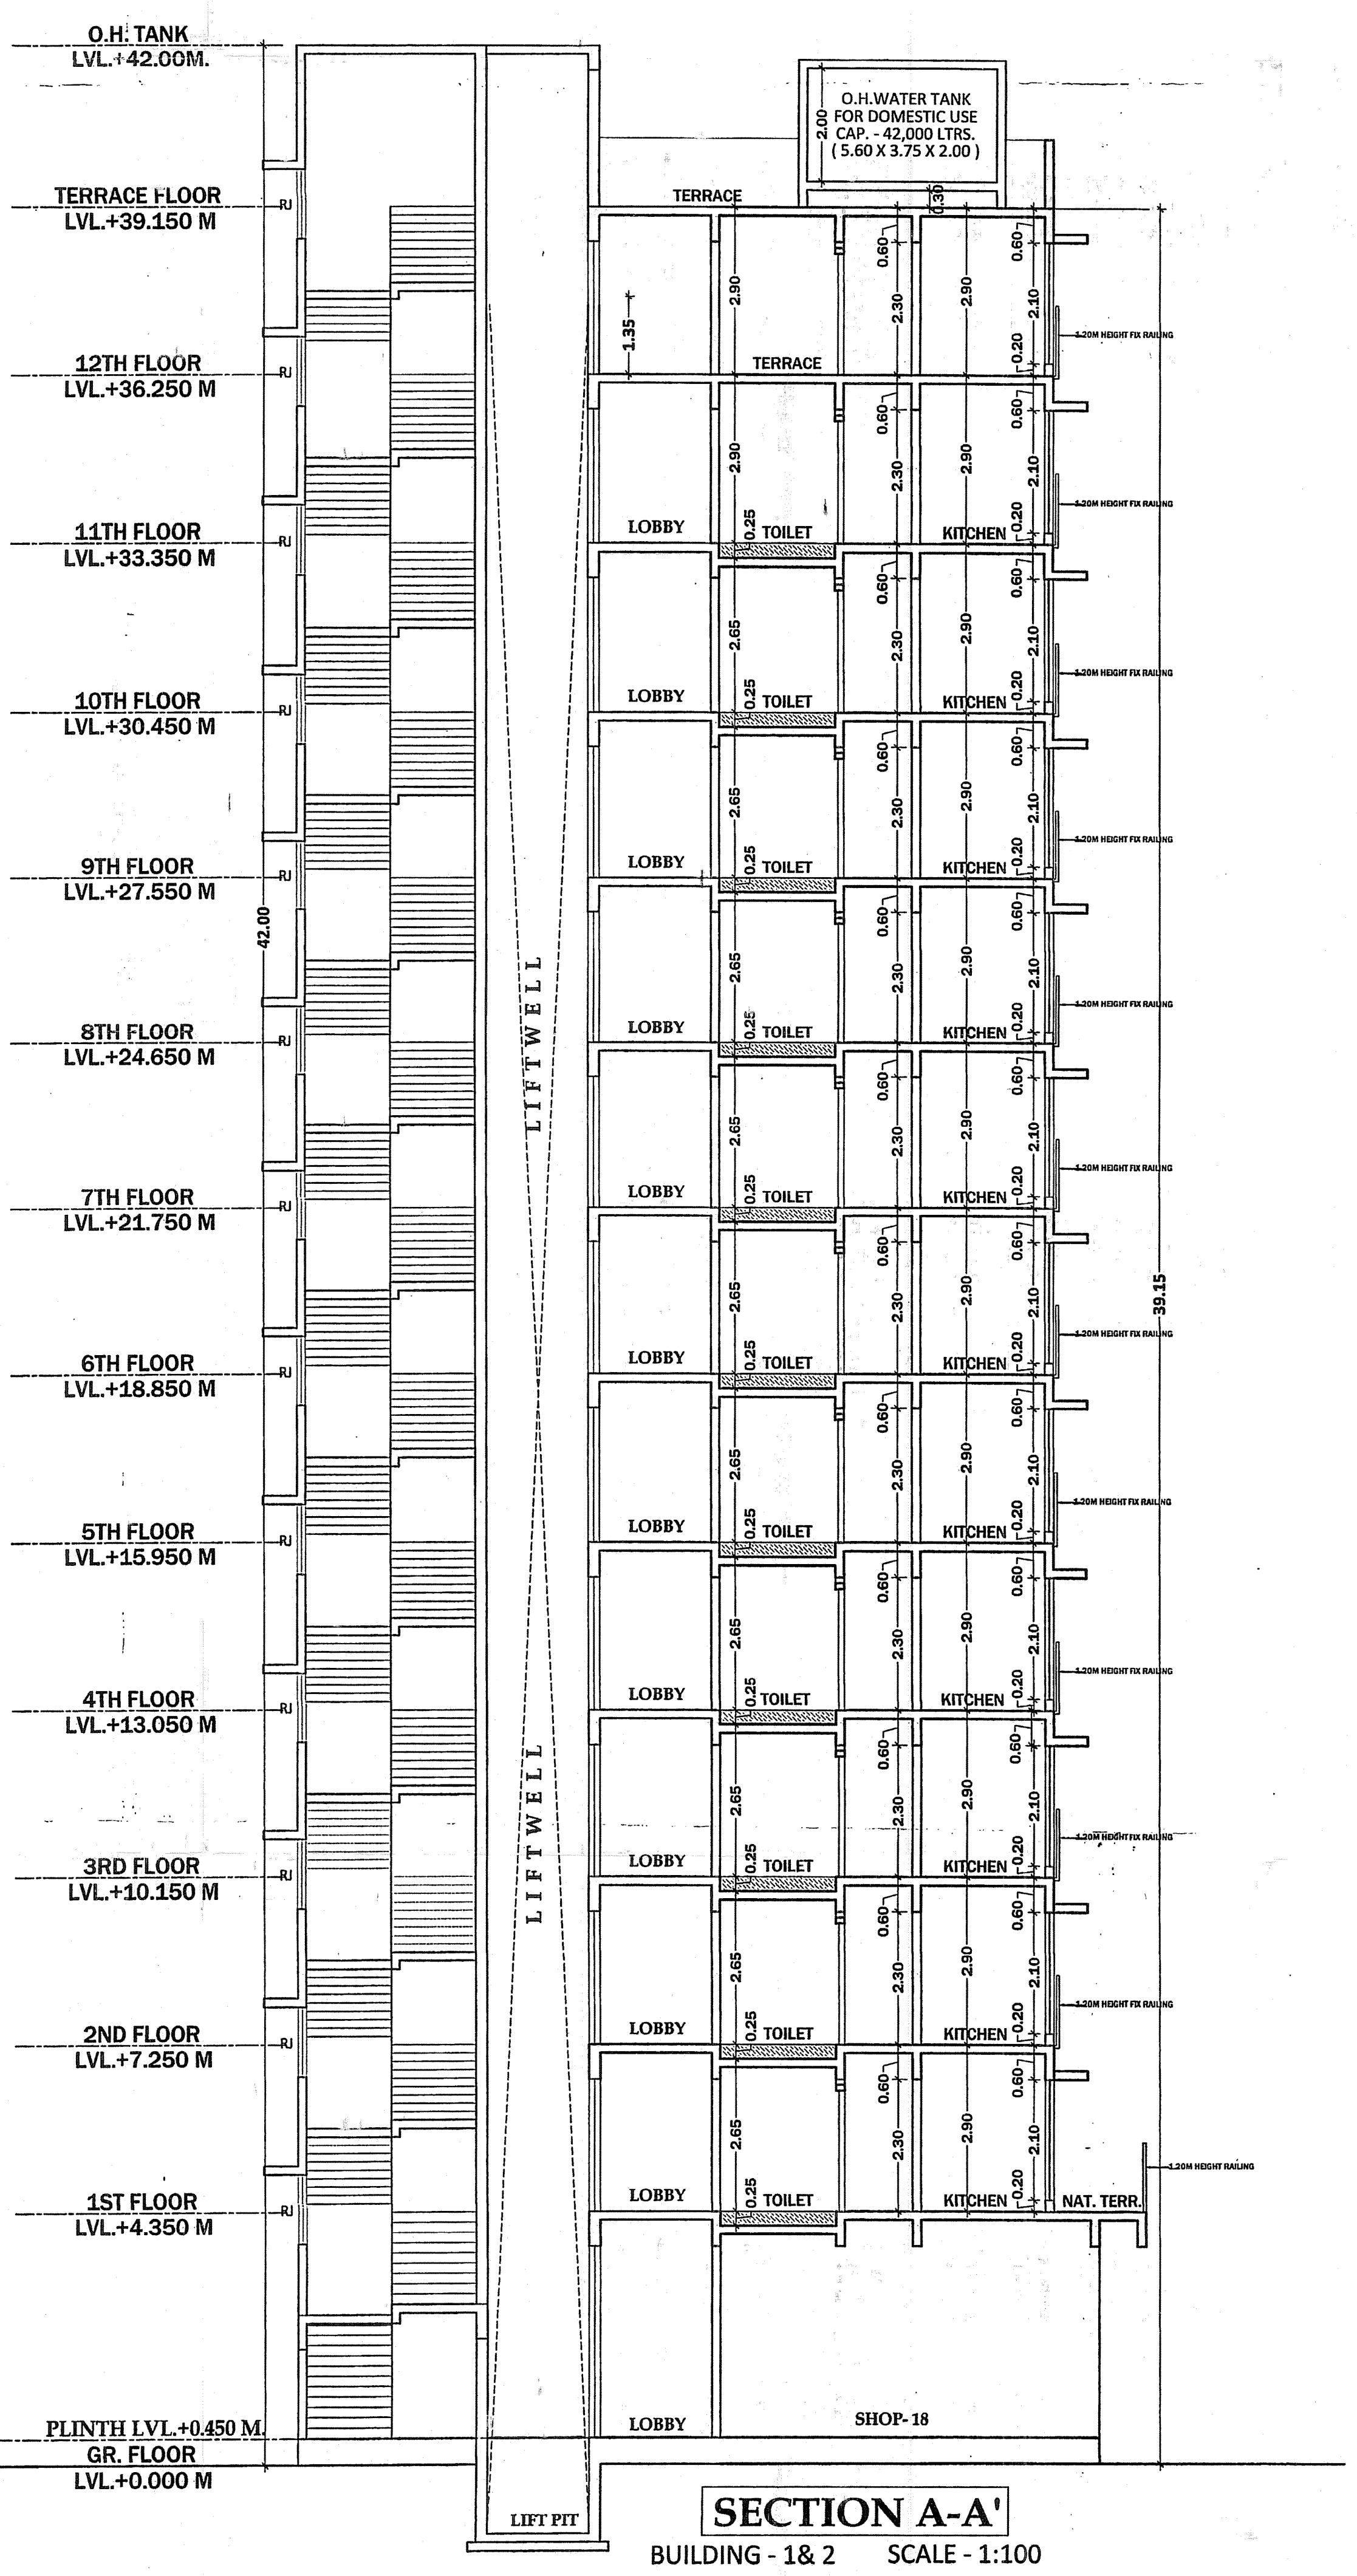
O.H. TANK
LVL.+42.00M.
O.H.WATER TANK
FOR DOMESTIC USE
CAP. - 42,000 LTRS.
(5.60 X 3.75 X 2.00)
TERRACE FLOOR
LVL.+39.150 M
12TH FLOOR
LVL.+36.250 M
11TH FLOOR
LVL.+33.350 M
10TH FLOOR
LVL.+30.450 M
9TH FLOOR
LVL.+27.550 M
8TH FLOOR
LVL.+24.650 M
7TH FLOOR
LVL.+21.750 M
6TH FLOOR
LVL.+18.850 M
5TH FLOOR
LVL.+15.950 M
4TH FLOOR
LVL.+13.050 M
3RD FLOOR
LVL.+10.150 M
2ND FLOOR
LVL.+7.250 M
1ST FLOOR
LVL.+4.350 M
PLINTH LVL.+0.450 M
GR. FLOOR
LVL.+0.000 M
TERRACE
LOBBY
TOILET
KITCHEN
NAT. TERR.
SHOP- 18
LIFTWELL
LIFT PIT
1.20M HEIGHT FIX RAILING
42.00
39.15

SECTION A-A'

BUILDING - 1& 2 SCALE - 1:100

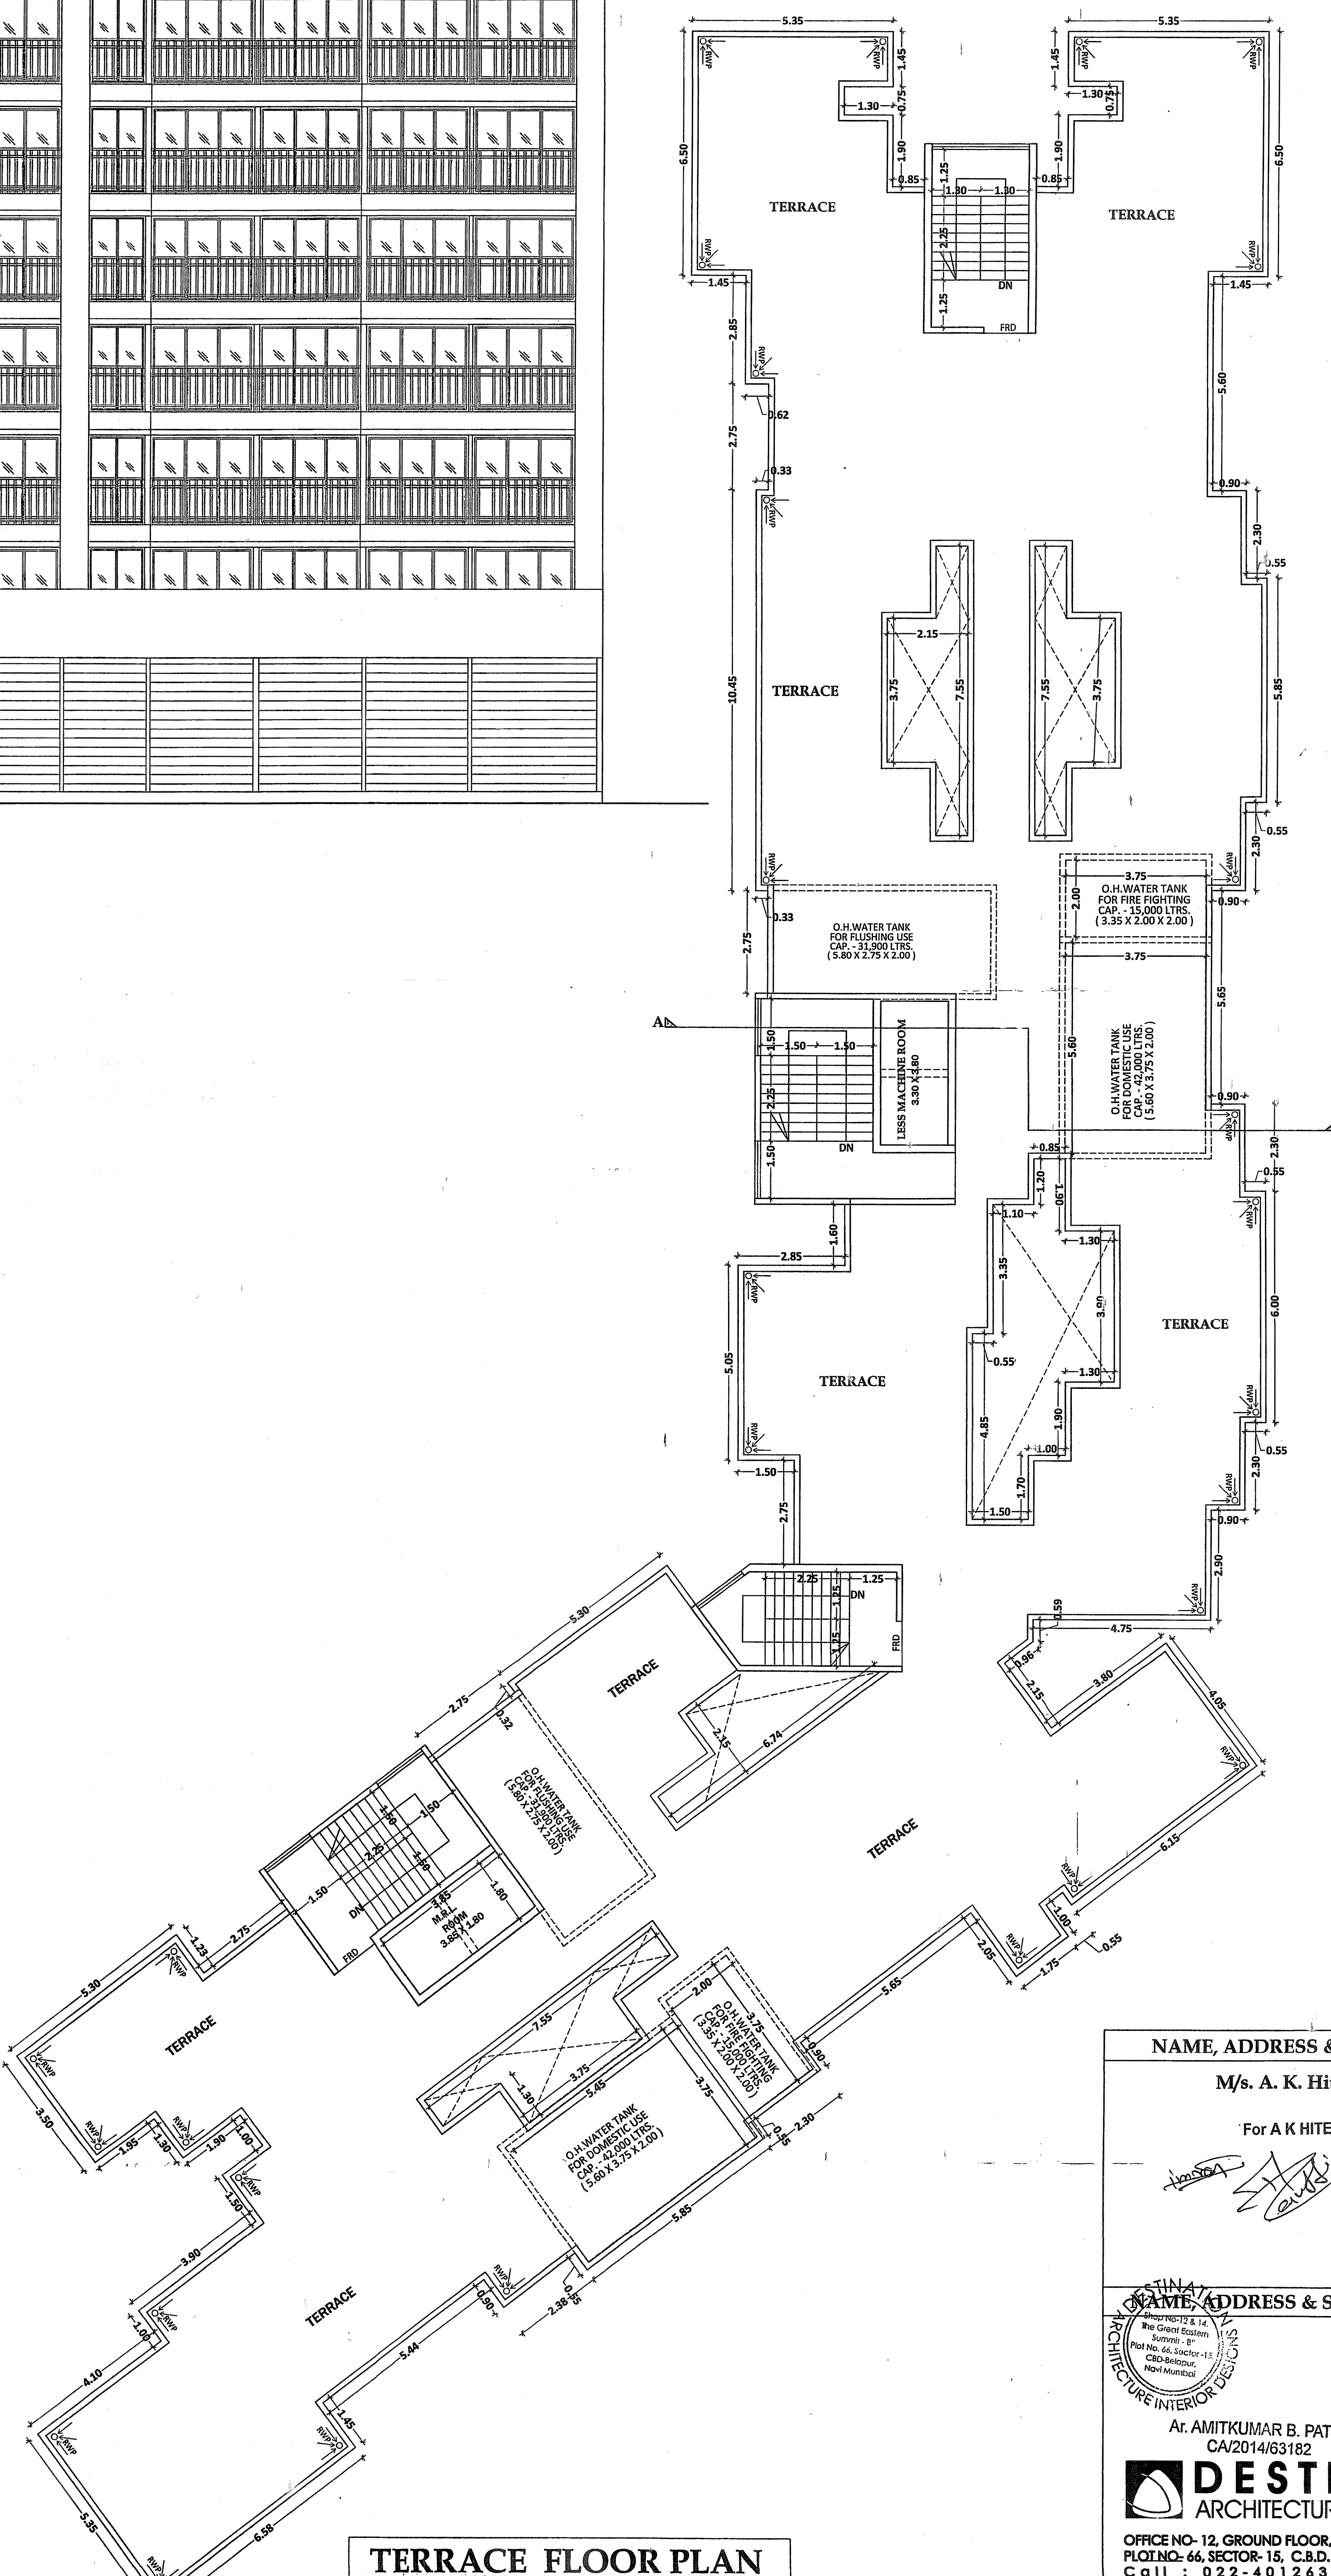
TERRACE
O.H.WATER TANK
FOR FLUSHING USE
CAP. - 31,900 LTRS.
(5.80 X 2.75 X 2.00)
O.H.WATER TANK
FOR FIRE FIGHTING
CAP. - 15,000 LTRS.
(3.35 X 2.00 X 2.00)
O.H.WATER TANK
FOR DOMESTIC USE
CAP. - 42,000 LTRS.
(5.60 X 3.75 X 2.00)
LESS MACHINE ROOM
3.30 X 3.80
DN
FRD
RWP
A
A'
5.35
6.50
10.45
5.85
5.65
5.60
6.00
5.05
4.85

TERRACE FLOOR PLAN

BUILDING- 1 & 2 SCALE - 1:100

NAME, ADDRESS & SIGN OF OWNER

M/s. A. K. Hitech Realty

For A K HITECH REALTY

Partners

NAME, ADDRESS & SIGN OF ARCHITECT

DESTINATION ARCHITECTURE INTERIOR DESIGNS
Shop No-12 & 14, The Great Eastern Summit - B, Plot No. 66, Sector-15, CBD-Belapur, Navi Mumbai

Ar. AMITKUMAR B. PATEL
CA/2014/63182

Ar. Amitkumar B. Patel
(Reg. No. CA/2014/63182)

DESTINATION
ARCHITECTURE INTERIOR DESIGNS

OFFICE NO- 12, GROUND FLOOR, GREAT EASTERN SUMMIT WING- B,
PLOT NO- 66, SECTOR- 15, C.B.D. BELAPUR, NAVI MUMBAI. 400614
Call : 022-40126328 & 022-41276523
www.destinationarchitects.com / destination.ind1@gmail.com

JOB NO	DRG. NO.	SCALE	DRAWN BY	DATE
	01	AS SHOWN	GAURESH	05/07/2022