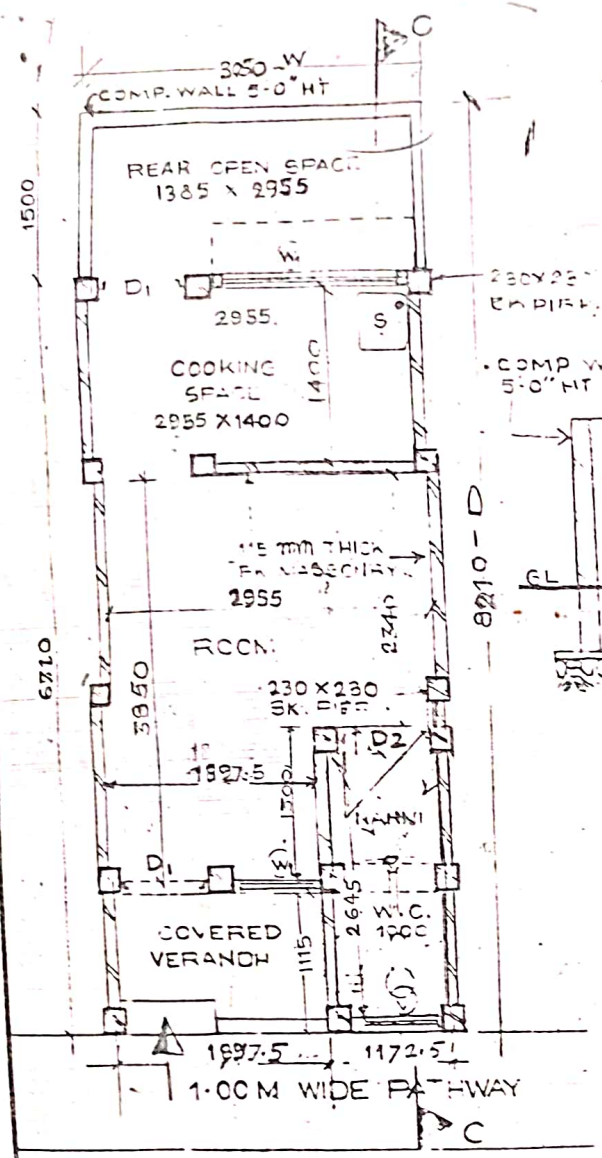

PLAN

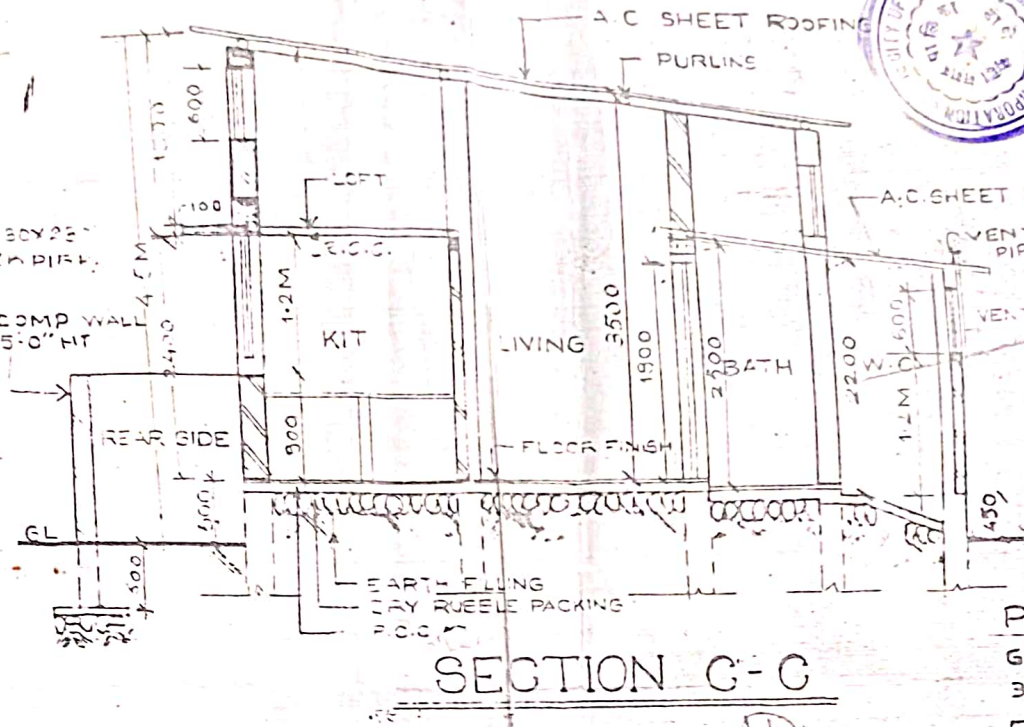

SECTION C-C

NOTE

1) D & W VARIABLE AS PER THE DIMENSIONS OF THE PLOT

2) LAY OUT PLANS APPROVED BY TMC. VIDE ① V.P NO 4505 OF 2/3/87 FOR PANCH PAKHADI AND ② V.P NO 4549 OF 25/11/87 FOR MAJIWADE

D. V. SHEKDAR
ARCHITECT · PLANNER
WORLD BANK PROJECT.
M·H·& A·D·A·

AREA STATEMENT

TYPE OF PLOT	PLOT SIZE W_m	PLOT SIZE D_m	AREA OF PLOT m^2	F.S.I.	PERMISSIBLE BUILT UP m^2	PROPOSED CARPET AREA ROOM	HIT.	VER.	MEZZ FLR	TOIL.	TOTAL	PROPOSED BUILT UP	F.S.I. CONSUMED
25 m^2	3.05	8.21	29.04	0.85	21.28	2.81	4.06	2.12	—	3.40	19.09	20.47	0.82
	~~3.05~~	~~9.66~~	~~29.60~~	0.85	~~21.76~~	3.85	4.31	1.90	—	~~2.44~~	18.43	~~20.98~~	0.81

DOORS & WINDOWS SCHEDULE

W_1 = 1200 X 1200 — GLAZED WINDOWS
V = 600 X 600 — GLAZED VENTILATOR
D_1 = 900 X 2100 — PANNELLED DOOR
D_2 = 750 X 2100 — PANNELLED DOOR

25m2

Occupation is hereby granted subject to conditions mentioned in this Office Letter
No. TMC/TDD/ 2254 Dated 18/1/97

Town Development Officer (TDR) Thane Municipal Corporation Thane.
Dy. City Engineer (DP)

सावधान

"[illegible] विकास [illegible] अधिनियमाचे कलम 42 अनुसार दखलपात्र गुन्हा आहे. त्यासाठी जास्तीत जास्त ५ वर्षे कैद व रु. ५०००/- दंड होऊ शकतो"

AREA DIAGRAM

PROPOSED BUILT-UP AREA

GROUND FLOOR
3.05 x 6.71m = 20.47 m^2

F.S.I. CALCULATION

AREA OF THE PLOT = 3.05 X 8.21 = 25.04
F.S.I. PERMISSIBLE = 0.85
PERMISSIBLE FLOOR AREA 25.04X0.85 = 21.28
BUILT UP AREA PROSED = 3.05 X 6.71 = 20.48
F.S.I. CONSUMED = 0.82

PROPOSED TYPE DESIGN FOR S.NO 3386 MULUND, PANCH PAKHADI MAJIWADE THANE

	CHIEF ENGINEER	(C. D. DAVE)
	DYR CHIEF ENGINEER	(P. Y. JOSHI)
SCALE 1:50	ARCHITECT	(D. V. SHEKDAR)
	ASST. ARCHITECT	(A. G. KULKARNI)
DATE 3-7-87	SR. ARCHITECT ASST.	(V. K. SHIRGAONKAR)
	DRAWN BY	(K. M. [illegible])

DRG. NO. CE/WD/EXCHANGE/ 5/87

BUDP MHADA